


- NOTES**
1. DO NOT SCALE OFF THIS DRAWING.
  2. THIS DRAWING IS TO BE READ INCONJUNCTION WITH  
SE 57061-1-C07 LEVEL E EAST PLANTROOM CO-ORD LL SERVICES  
SE 57061-1-C07 LEVEL E EAST PLANTROOM CO-ORD SECTIONS
  3. ALL MECHANICAL PIPEWORK HAS MANUAL AIR VENTS AT H/L
  4. ALL MECHANICAL PIPEWORK HAS DRAIN COCKS AT L/L, IN ALL  
POCKETS AND AT ALL FLOOR ISOLATING VALVES
  5. ALL DUCTWORK TO DW144, AND FOLLOW SPECIFICATION FOR  
ACCESS DOORS FOR CLEANING AND MAINTENANCE
  6. ALL NEW PIPEWORK SERVICES HAVE BEEN SLEEVED THROUGH  
WALLS AND FLOORS
  7. ALL MECHANICAL SERVICES ARE IN ACCORDANCE WITH  
THE SPECIFICATION FOR FCUs, DUFFUSERS AND ATTENUATORS

DO NOT Scale This Drawing  
Dimensions to be checked on Site.

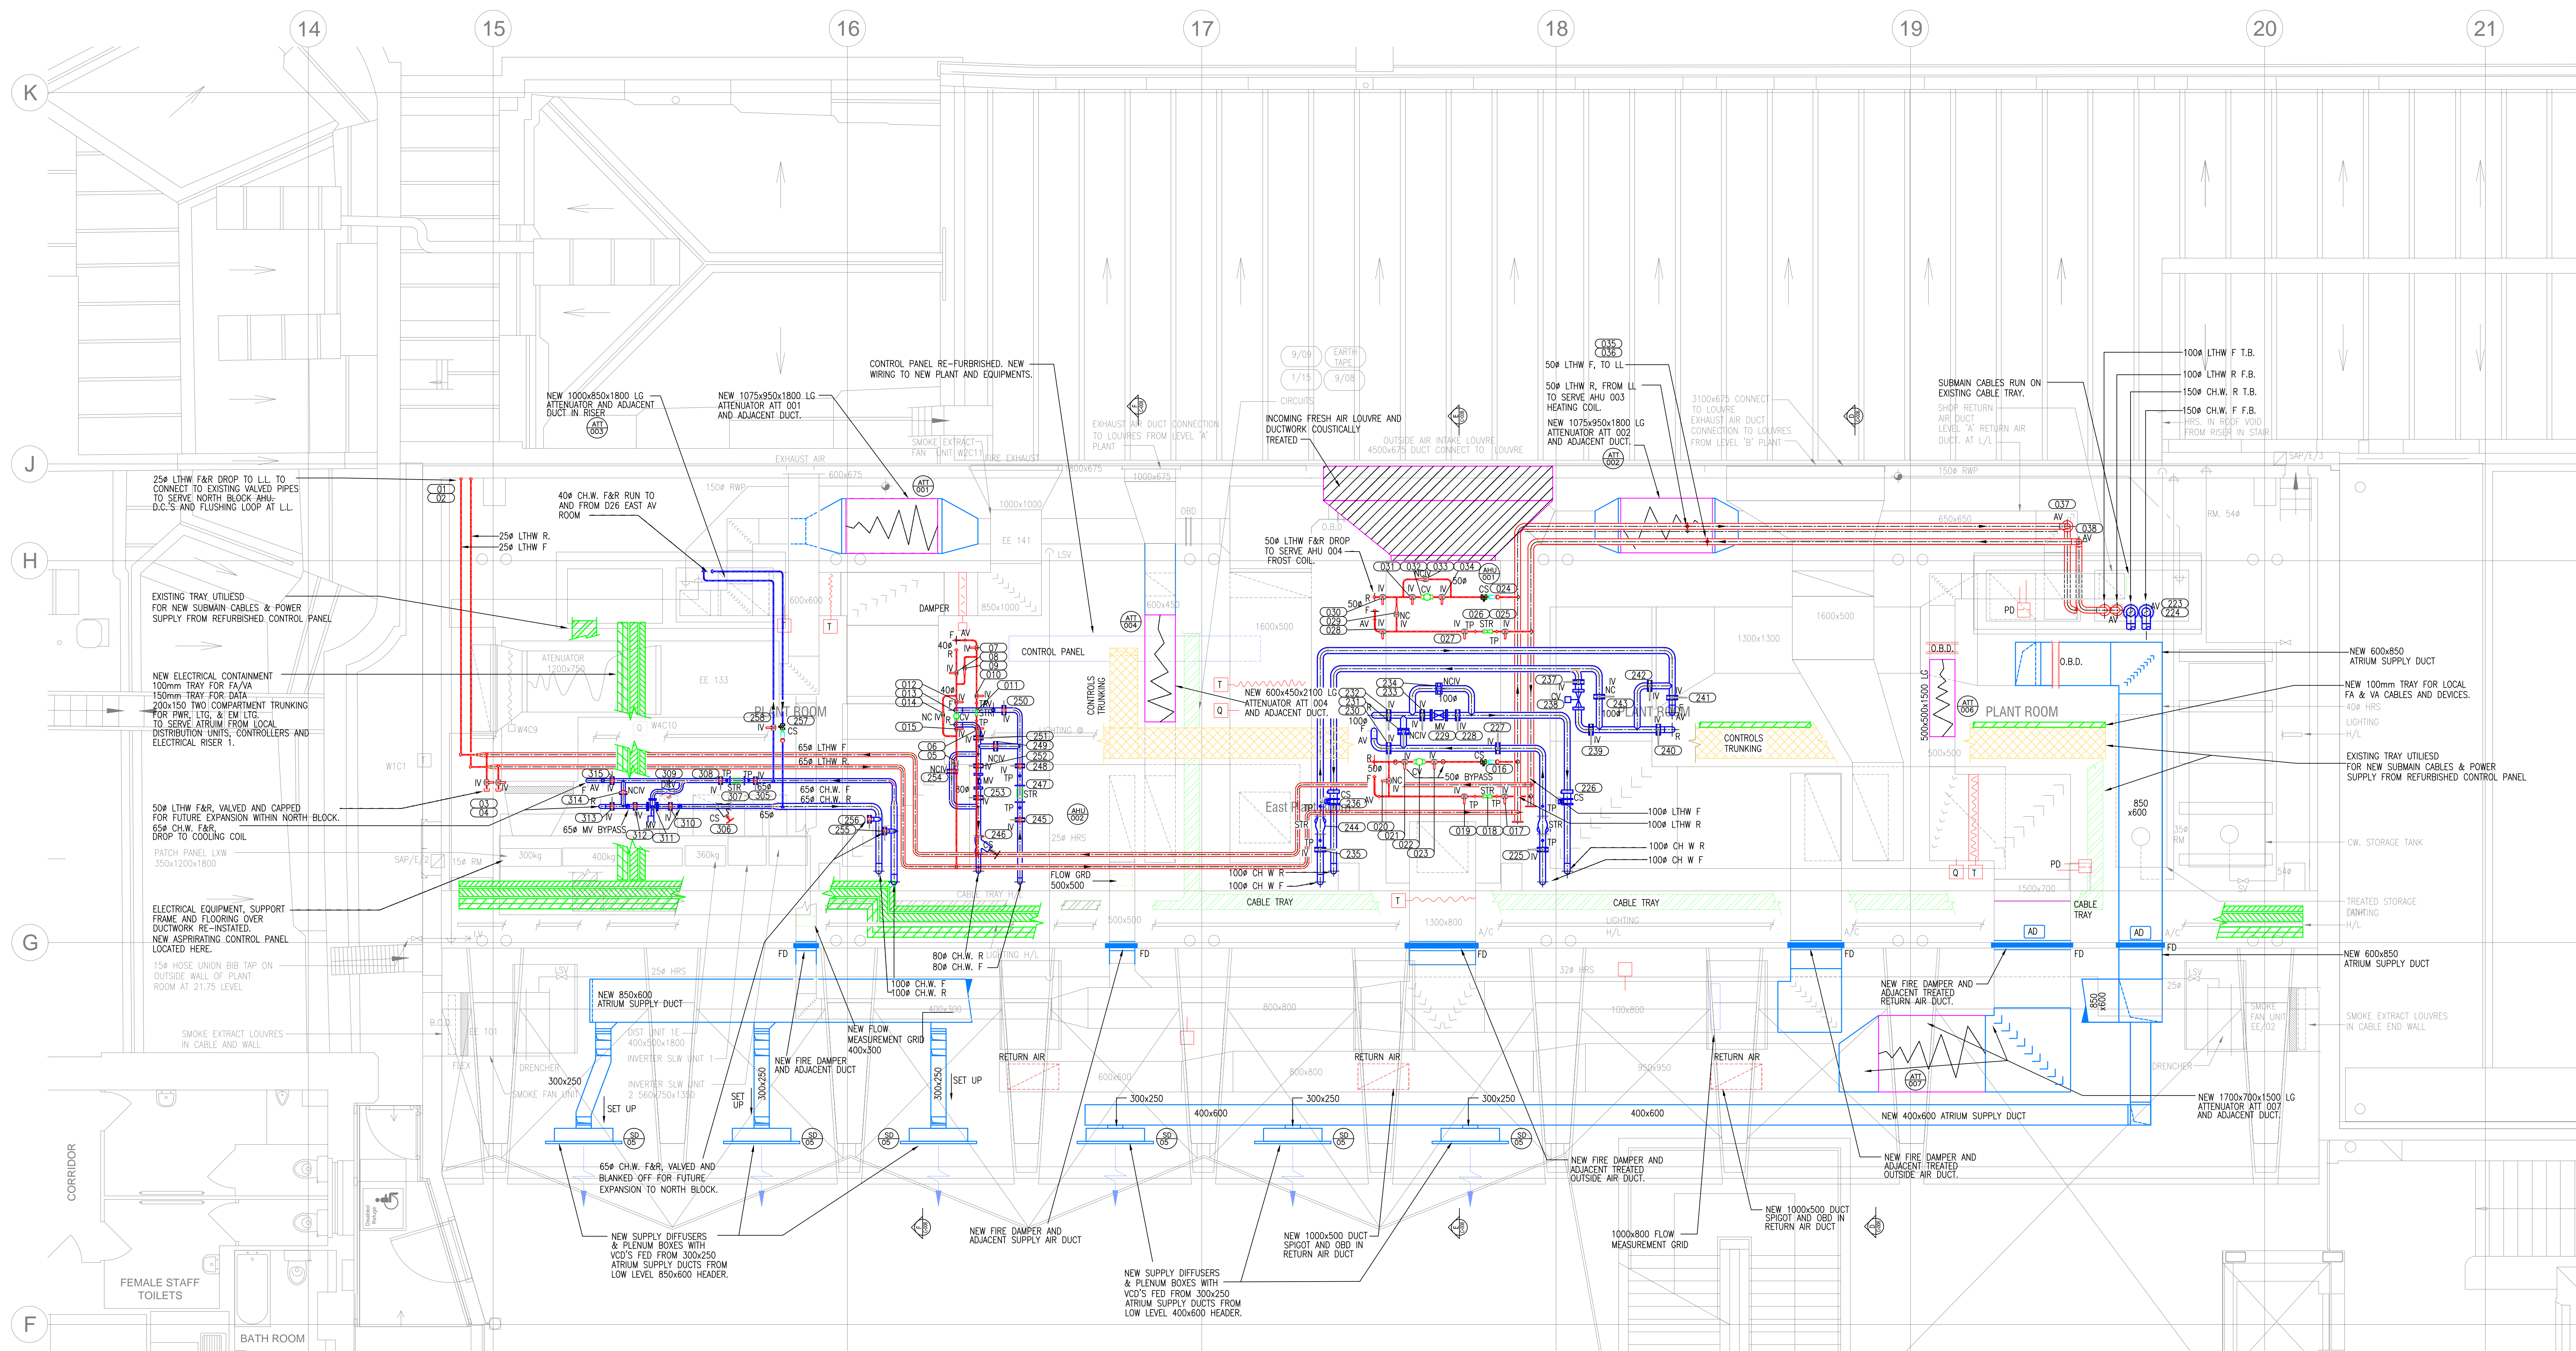

## LEVEL E EAST PLANTROOM HIGH LEVEL MODIFICATIONS TO EXISTING SERVICES

Date Issued	Date	Revisions
<h1>RECORD DRAWING</h1>		
Client:	Imperial War Museum Lambeth Road London SE1 6HZ	
Consultant:	Buro Happold	
Project:	Imperial War Museum First World War Centenary Project	
Drawing Title:	Level E East Plinthroom High Level Services Modifications To Existing	
 <div style="float: right; text-align: right;"> <p>The Millennium Centre          Millennium Quay          Farnham          Surrey          GU9 7JX  <a href="http://www.mitie.co.uk">www.mitie.co.uk</a></p> </div>		
Tel: 01252 732 420	Fax: 01252 715 708	
Drawn Date: <b>June 2014</b>	Drawn by: <b>DW</b>	
Scale: <b>1:50 @ A0</b>	Approved by: <b>PE</b>	
Drawing No:		Revision:
<b>T7060-7-E-006</b>		<b>RD</b>