

Notes:

1. DO NOT SCALE THIS DRAWING.
2. DO NOT ALTER BY HAND.
3. THIS DRAWING IS TO BE READ IN CONJUNCTION WITH ALL OTHER RELEVANT DRAWINGS AND SPECIFICATIONS.
4. ALL DIMENSIONS ARE IN MILLIMETRES UNLESS STATED OTHERWISE.

As Installed		N/A	
Rev	As Issued	By	Date
1/01	As Issued	CAT	2007/09
Drawn By	Checked By	Drawn Date	Checked Date
C. Tomlinson	R. Dawson	1:100	June 2009
Drawing Number	Revision	AI	
106-E-165	AI		


derry BUILDING SERVICES


Sam Derry House,
London Road, L1P
Tel: 0151 275 1234
Email: enquiries@derry.co.uk


Corby East Midlands International Swimming Pool


External Feature Lighting	
Drawn By	Engineer
C. Tomlinson	R. Dawson
Primary Scale	Size
1:100	A1
Drawn Date	Drawn By
June 2009	AI

LEGEND

 PULSAR CHROMAFLUO LED FLOODLIGHT RGB COLOUR CHANGE SIZE AS INDICATED

 DENOTES OPTICAL LENS FITTED

 FEATURE LIGHTING LED REFERENCE NUMBER

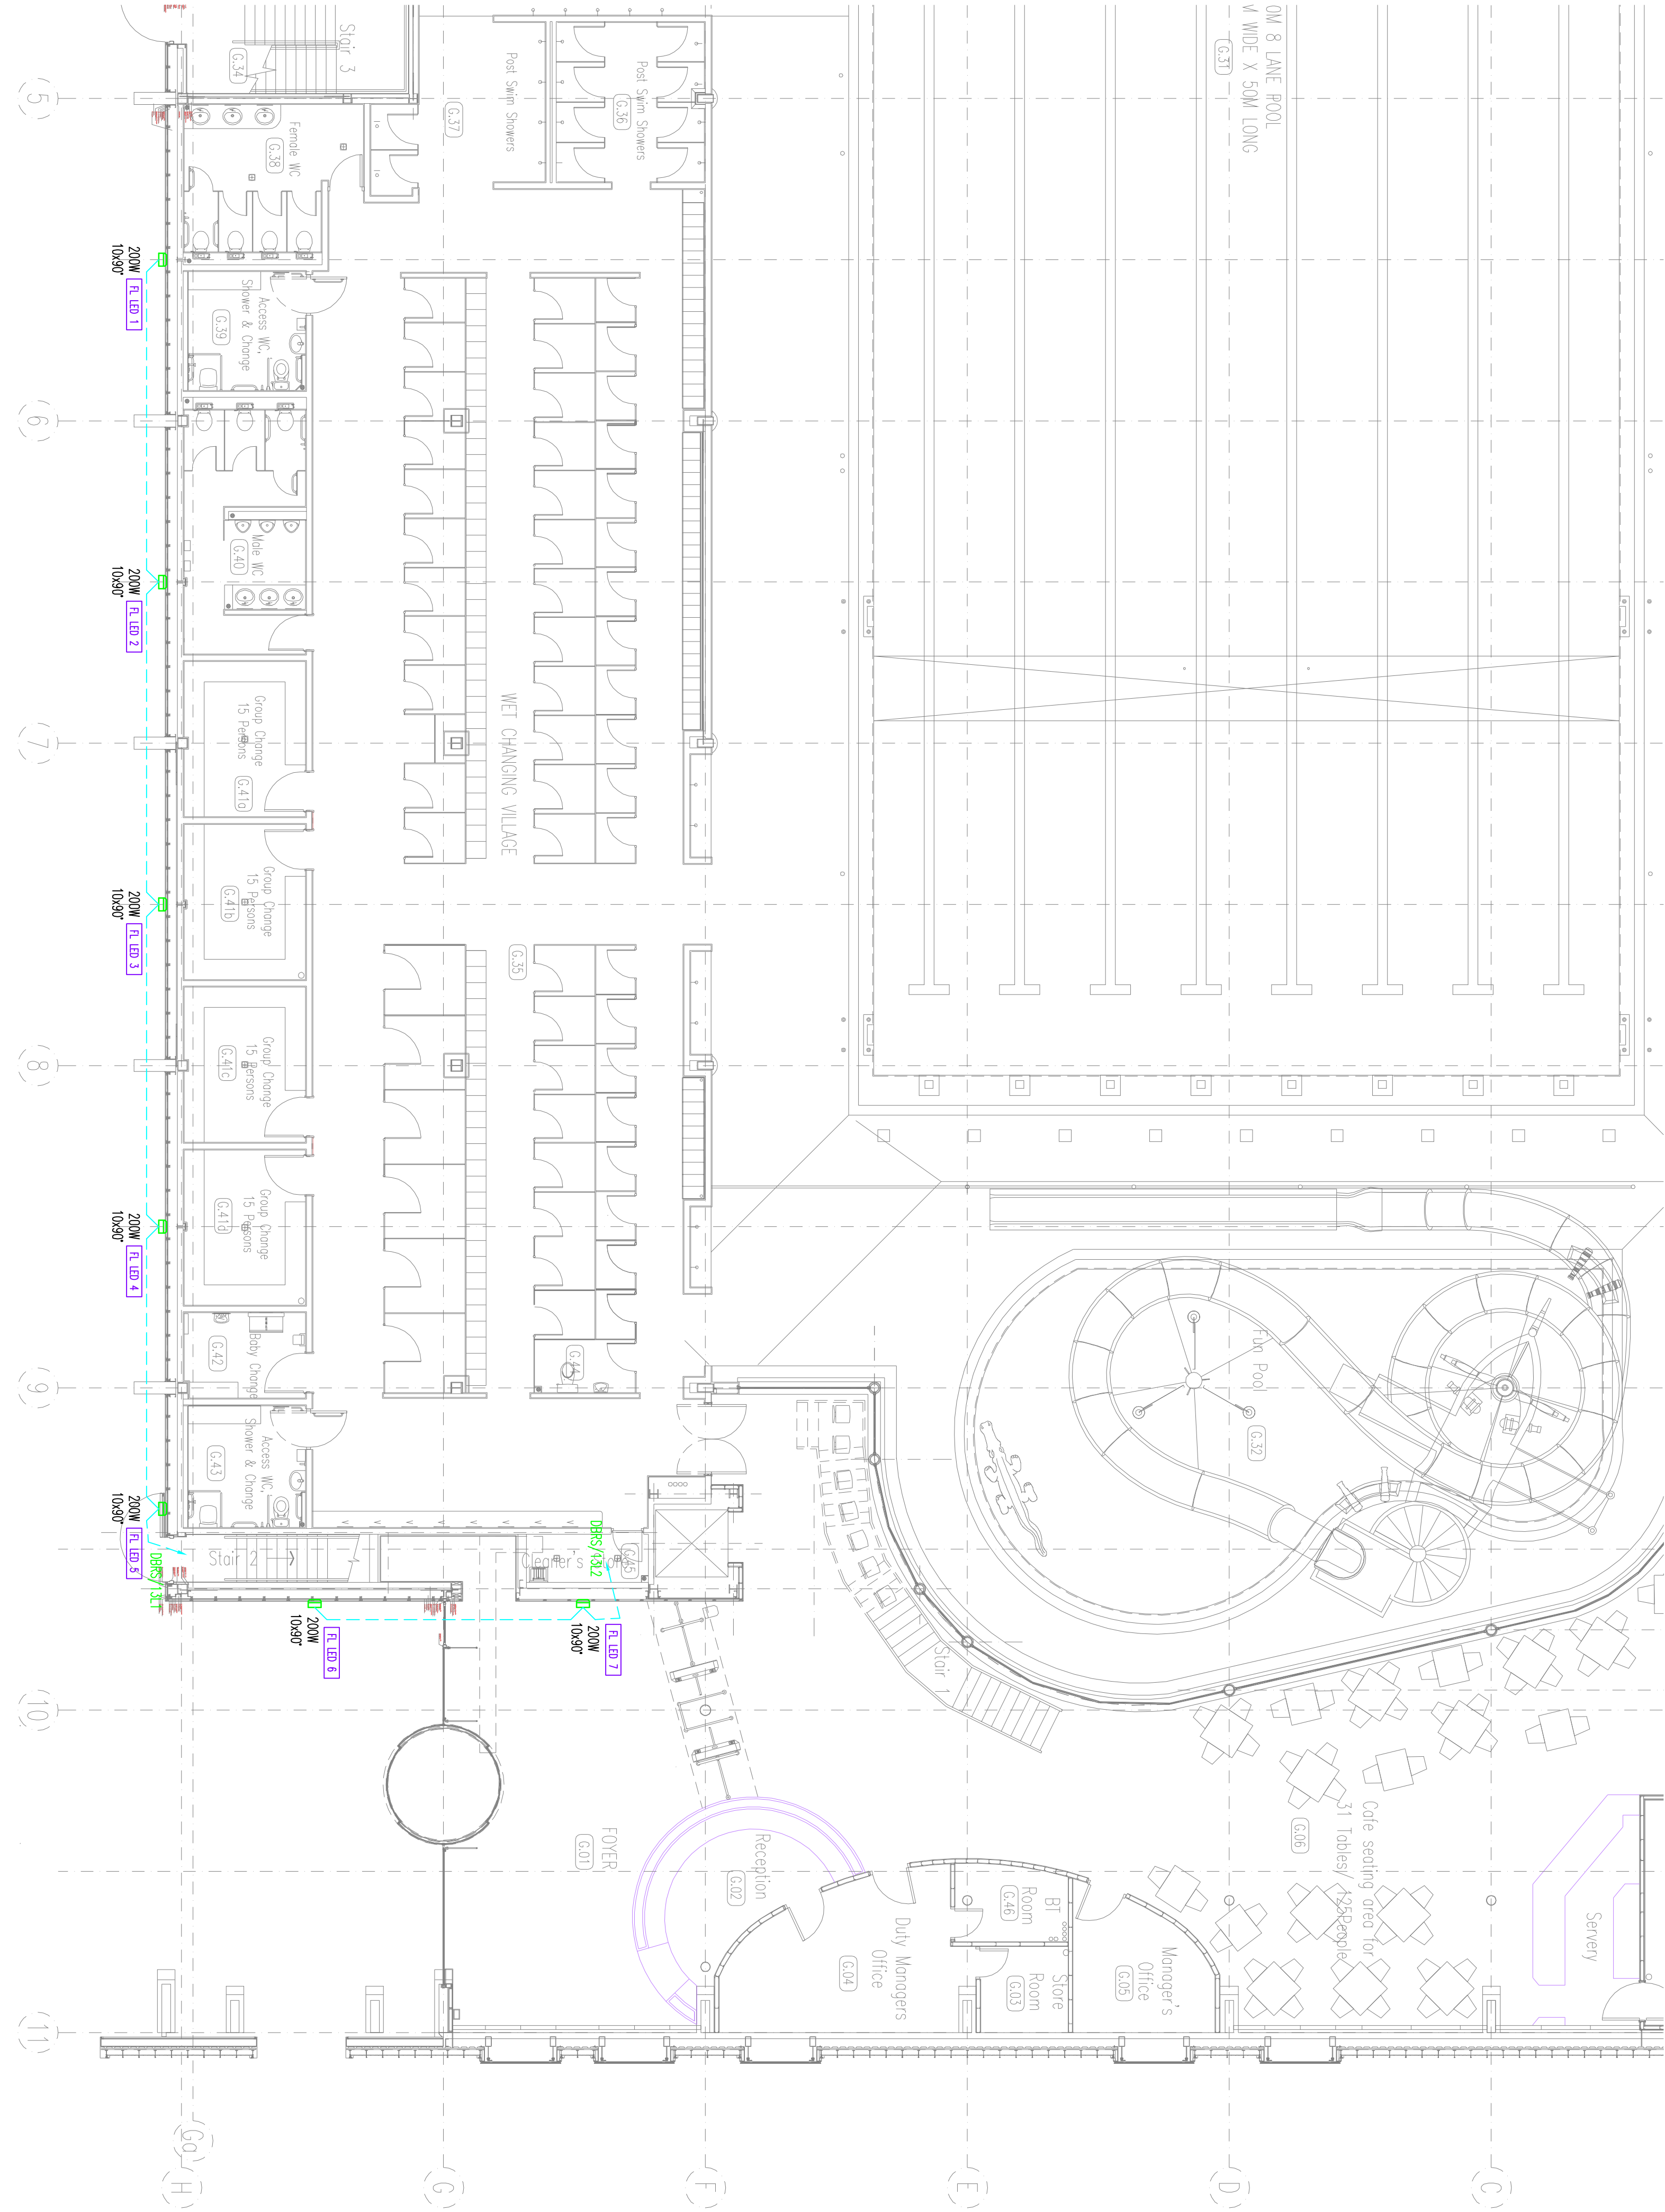

- NOTES**
1. R LED 1 - 5 ARE TO BE MOUNTED TO TIMER CLADDING AT UNDERSIDE OF CONCRETE PLUMB.
 2. R LED 6 & 7 ARE TO BE MOUNTED AT _____mm AFL ON THE TIMER CLADDING.
 3. EXTERNAL FEATURE LIGHTING IS PROVIDED BY RGB COLOUR CHANGE LED PROJECTOR FLOODLIGHTS. THE EXTERNAL FEATURE LIGHTING IS CONTROLLED BY A MASTER SWITCH AT RECEPTION AND TIMECLOCK/PHOTOCELL. THE LUMINAIRES ARE ADJUSTED AT COMMISSIONING TO PROVIDE DIFFERENT SCENES AS AGREED WITH THE CLIENT.

MOUNTING HEIGHT
TO BE CONFIRMED