



NOTE

1) MATERIAL
MAIN BODY MILD STEEL
HANDRAIL AND GLASS CLAMP 316 STAINLESS
STEEL




2) FINISH
MILD STEEL - GALVANISED
STAINLESS STEEL - SATIN POLISHED

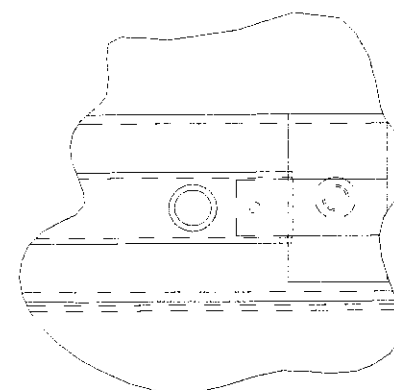

SECTION B-B
SCALE 1/2

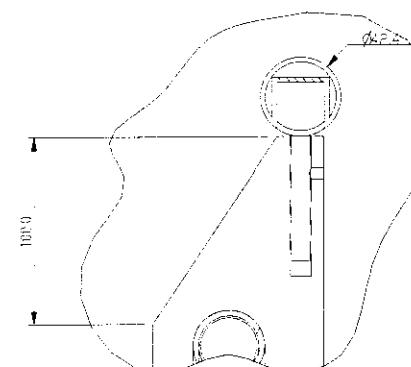

SECTION C-C
SCALE 1/2

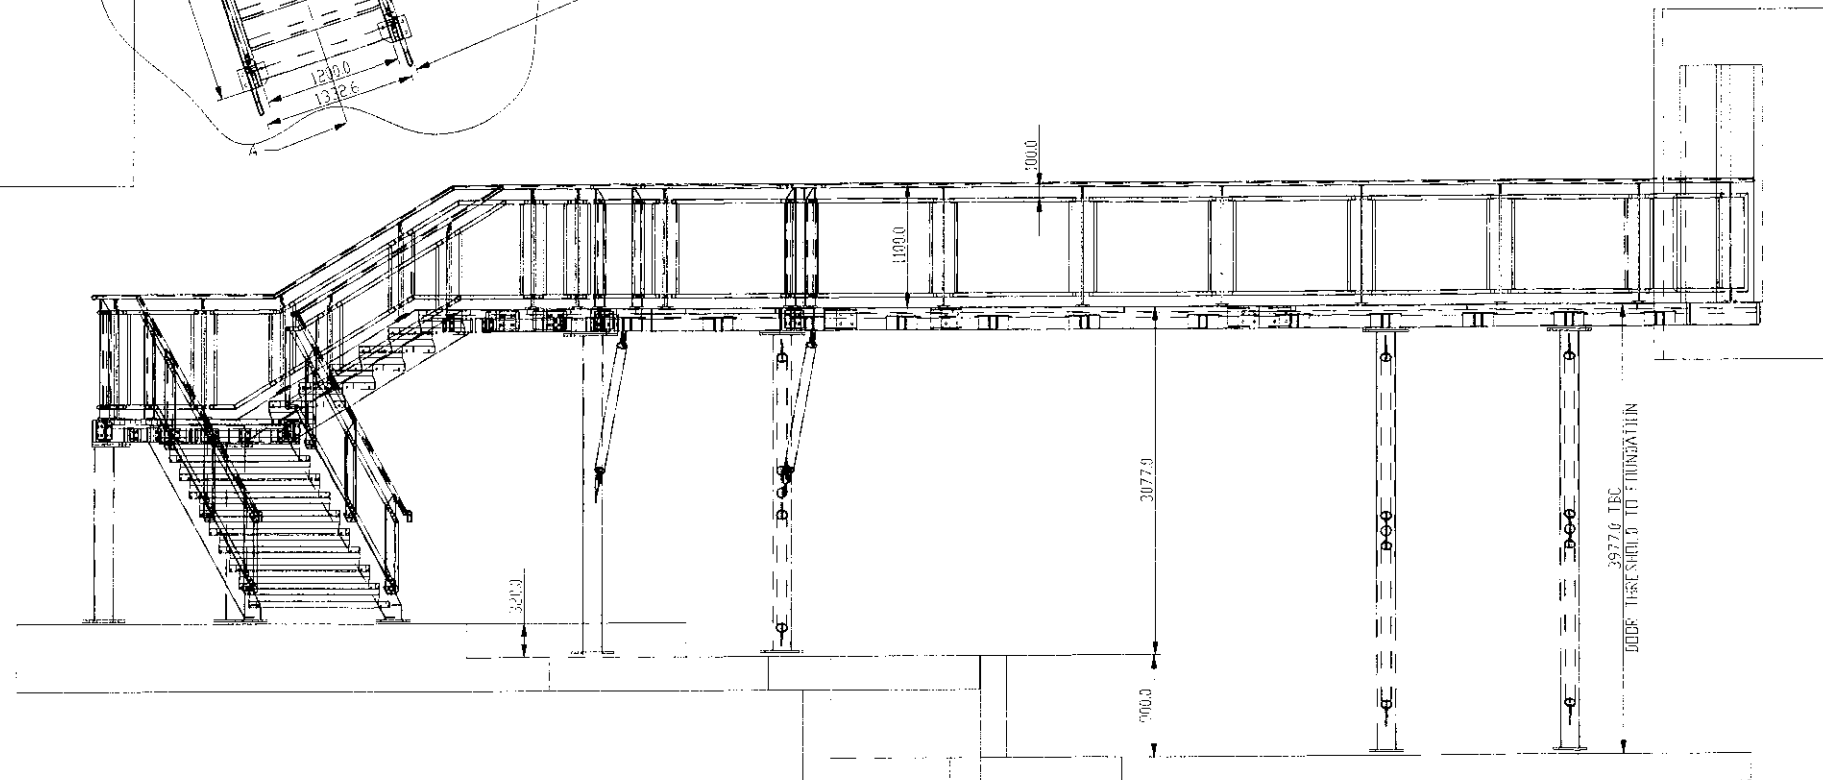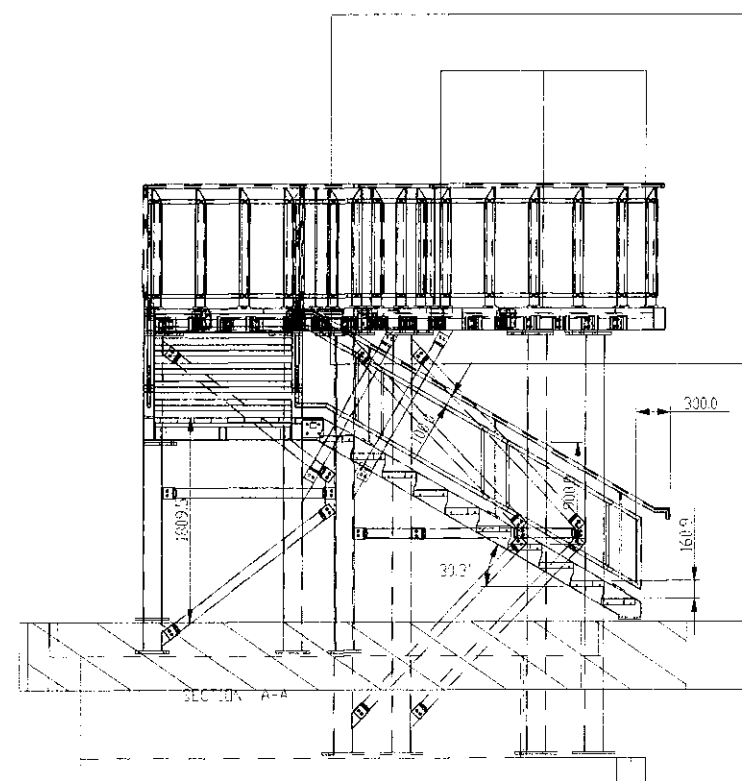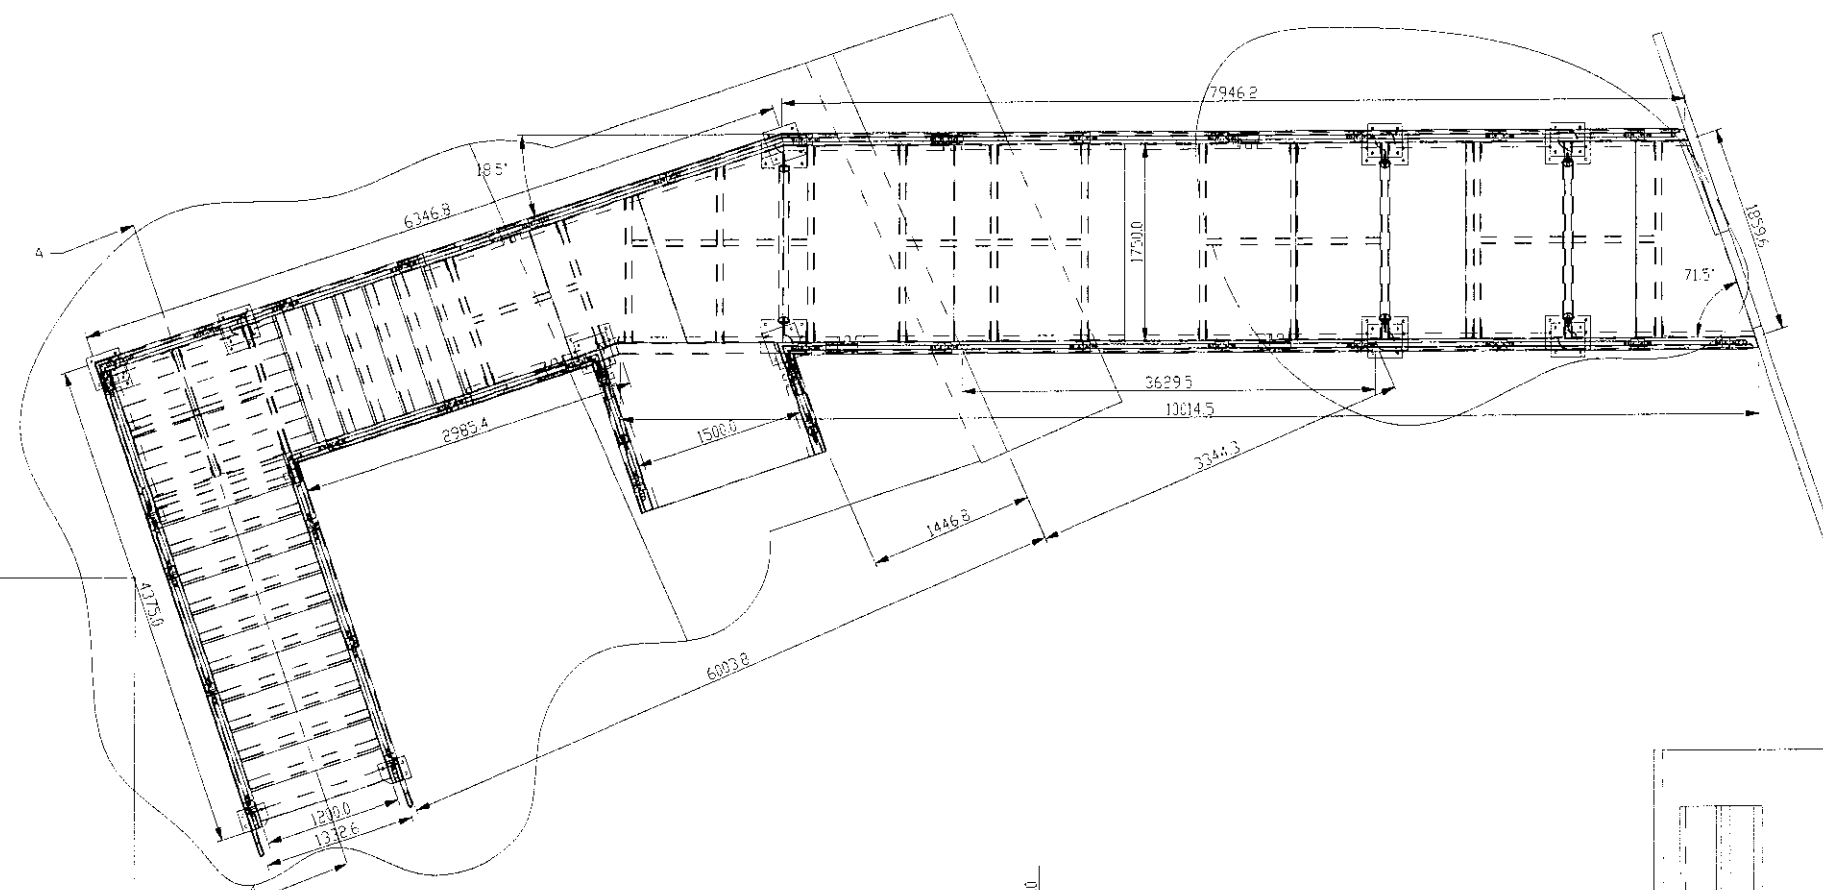

REVISION E DATE 21-03-13 BY: CJH
UPDATE TO SUIT COMMENTS

REVISION D DATE 19-03-13 BY: CJH
UPDATE TO SUIT COMMENTS

REVISION C DATE 26-02-13 BY: CJH
UPDATE TO CALCULATIONS

REVISION E DATE 05-02-13 BY: CJH
BALUSTRADE DESIGN UPDATED

REVISION A DATE 29-01-13 BY: CJH
UPDATE TO SUIT SURVEY AND COMMENTS



UNIT 42
HOSPICE BUSINESS PARK
2000291
HAMPSHIRE POLE 402
TEL: 01203 9652 5555
FAX: 01203 9652 3333

SPECIALIZED
FABRICATIONS

CONTRACT DETAILS


HMS ALLIANCE

DRAWING TITLE


REAR STAIRCASE
3A

REVISIONS

DATE	30/03
DRAWN BY	CJH
CHECKED BY	BI-2013
DATE TRAVEL	21-03-13
CHECKED	21-03-13
DRAWING NO	21-03-13
REVISION	AS BUILT



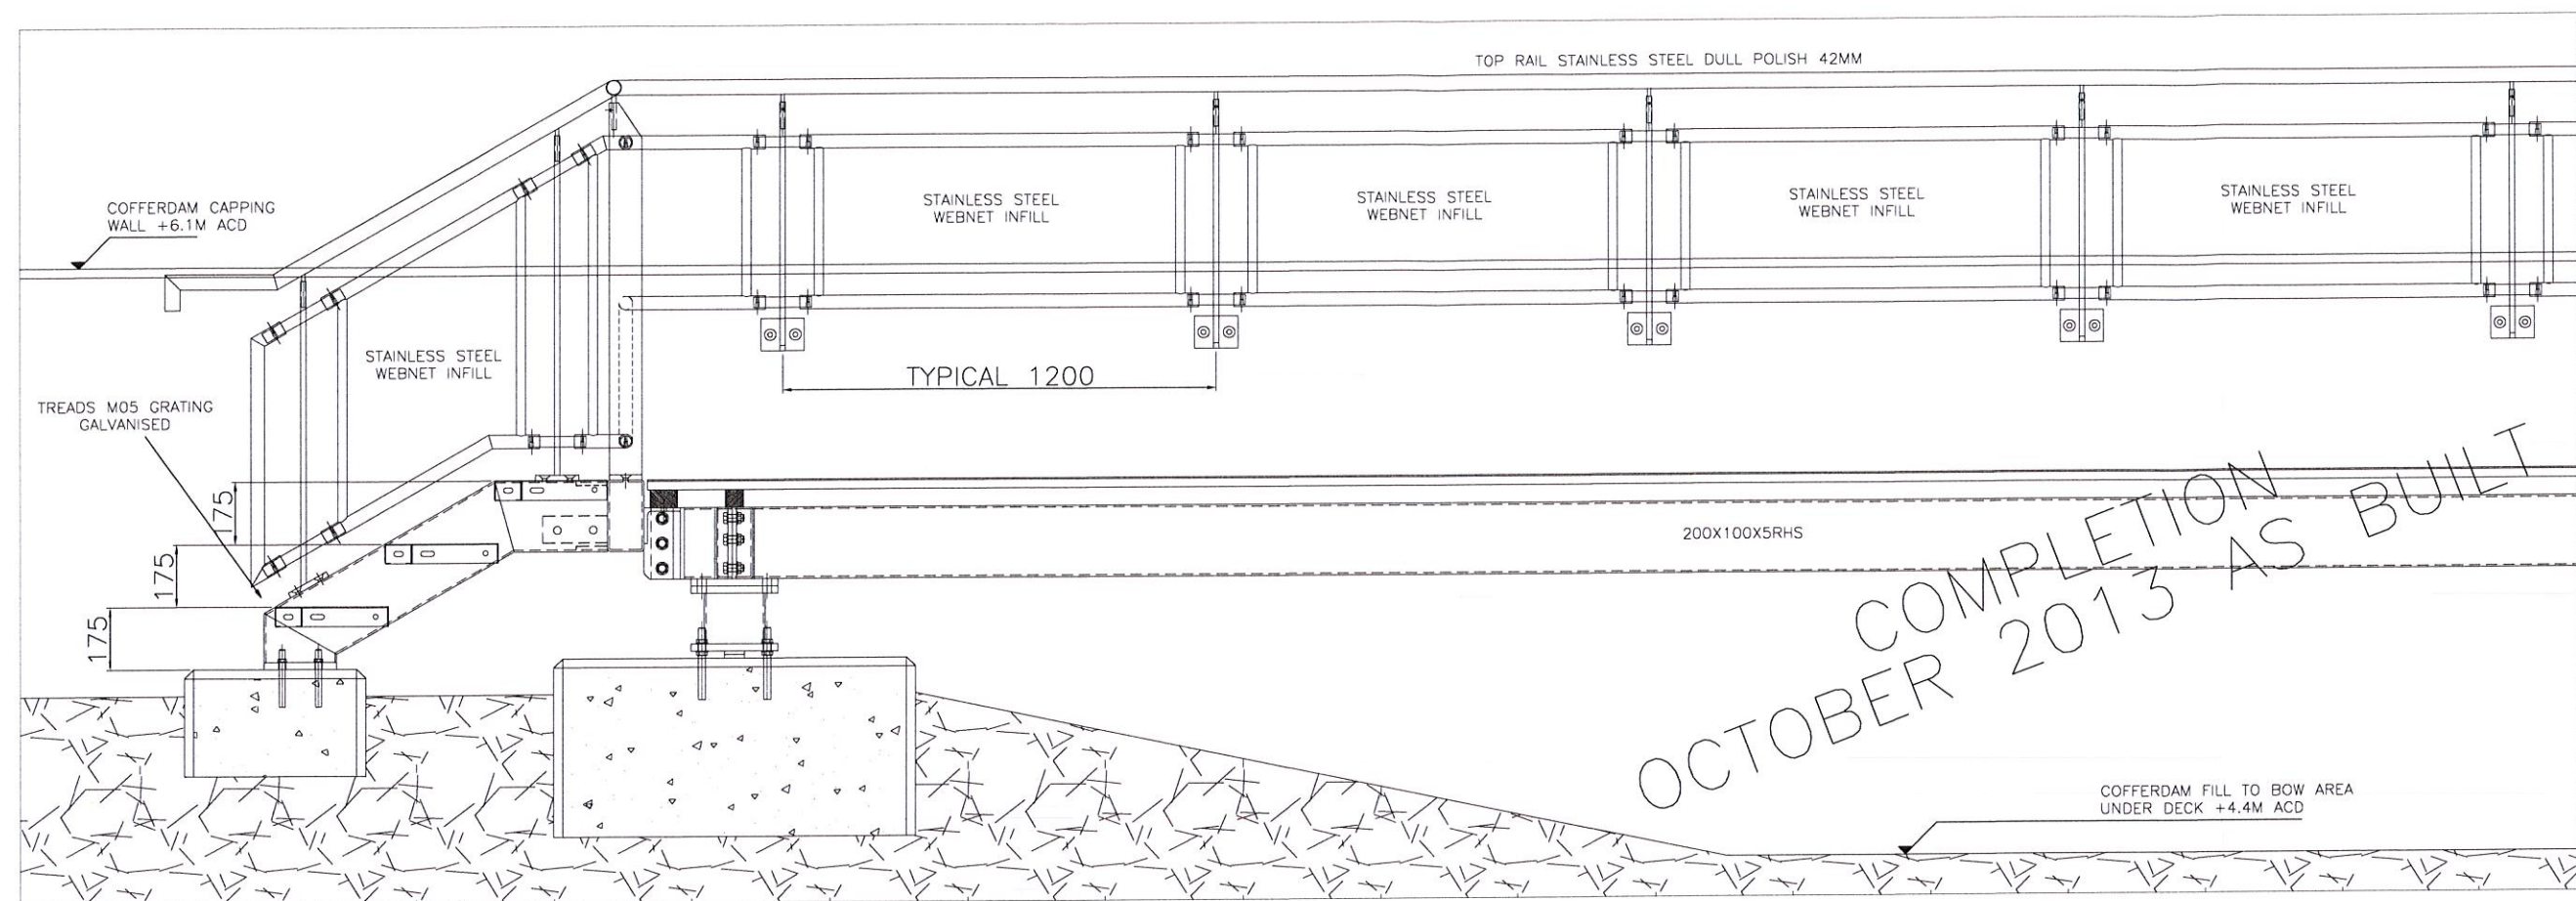


COMPLETION
OCTOBER 2013 AS BUILT

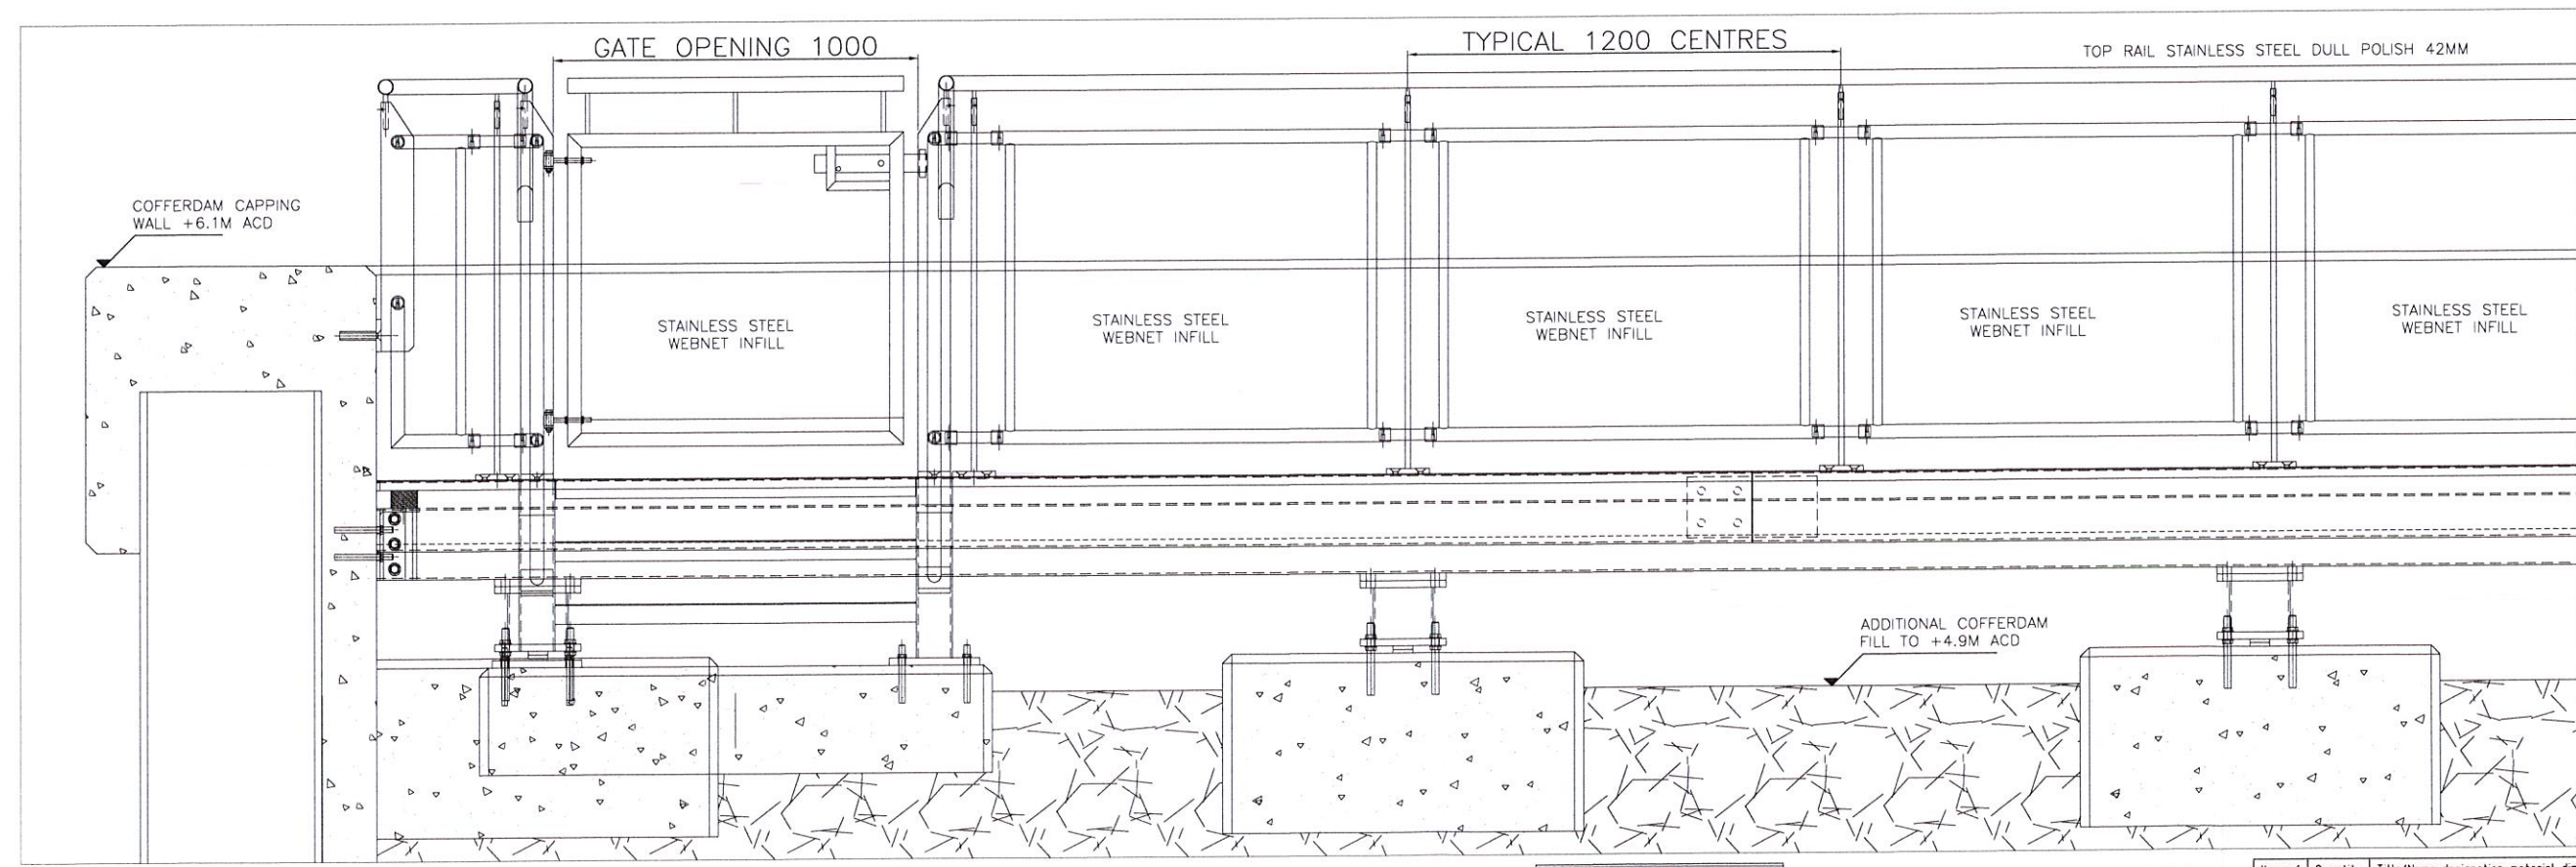


Kettering Terrace, Mile End
Portsmouth, Hampshire
PO2 7QH
Telephone: 02392 819114
Facsimile: 02392 823386
www.mluk.co.uk

Itemref	Quantity	Title/Name, designation, material, dimension etc			Article No./Reference	
Designed by MH	Checked by DR	Approved by - date	Filename	Date 09/06/13	Scale PRINT A1	
HMS ALLIANCE (RESTORATIONS 2012/13)				BOW DECK AREA - SECTION VIEWS		
				MLD-12-121-10	Edition AB	Sheet

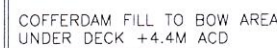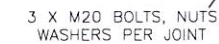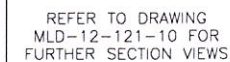

- | | | | | | | |
|-------------------------------------|------------------|--|-------------------------------------|------------------|-----------------------|--|
| Item#r | Quantity | Title/Name, designation, material, dimension etc | | | Article No./Reference | |
| Designed by
MH | Checked by
DR | Approved by - date | Filename | Date
05/06/13 | Scale
PRINT A1 | |
| HMS ALLIANCE (RESTORATIONS 2012/13) | | | BOW DECK AREA - GENERAL ARRANGEMENT | | | |
| | | | MLD-12-121-9 | Edition
6B | Sheet | |

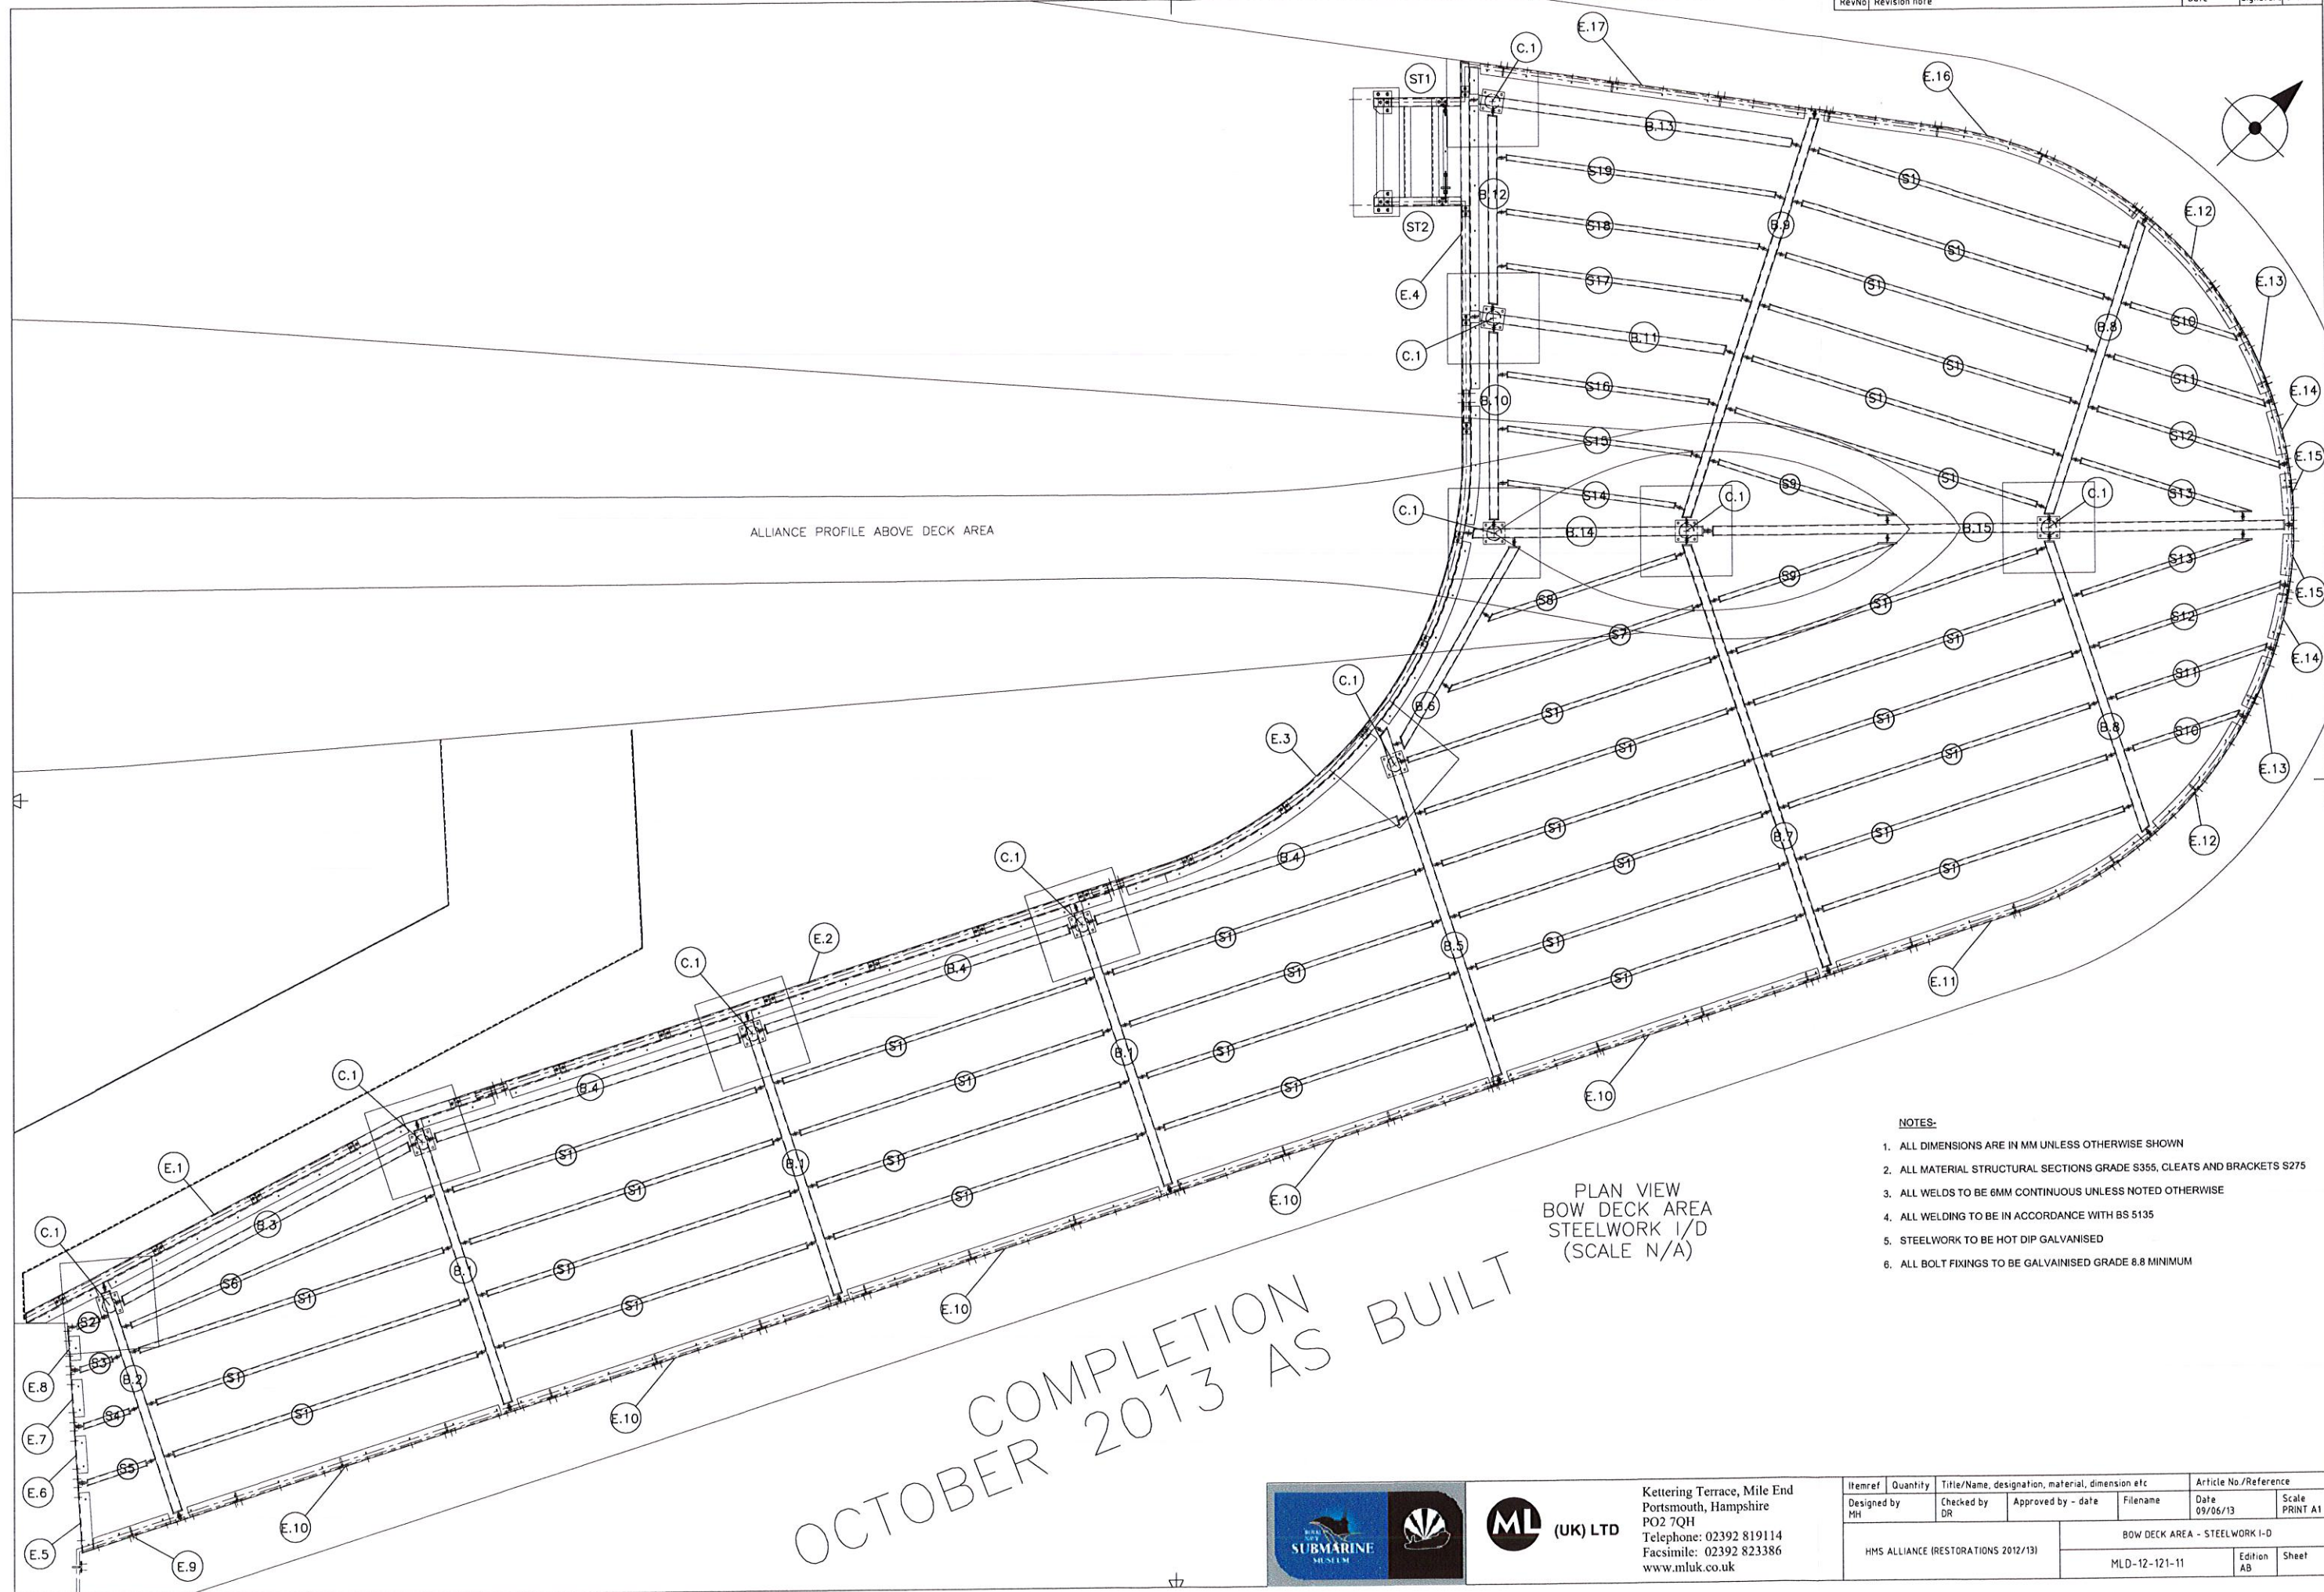


ALLIANCE PROFILE ABOVE DECK AREA

PLAN VIEW
BOW DECK AREA
STEELWORK I/D
(SCALE N/A)

NOTES:

1. ALL DIMENSIONS ARE IN MM UNLESS OTHERWISE SHOWN
2. ALL MATERIAL STRUCTURAL SECTIONS GRADE S355, CLEATS AND BRACKETS S275
3. ALL WELDS TO BE 6MM CONTINUOUS UNLESS NOTED OTHERWISE
4. ALL WELDING TO BE IN ACCORDANCE WITH BS 5135
5. STEELWORK TO BE HOT DIP GALVANISED
6. ALL BOLT FIXINGS TO BE GALVANISED GRADE 8.8 MINIMUM

COMPLETION
OCTOBER 2013 AS BUILT

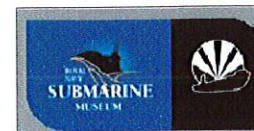

ML (UK) LTD

Kettering Terrace, Mile End
Portsmouth, Hampshire
PO2 7QH
Telephone: 02392 819114
Facsimile: 02392 823386
www.mluk.co.uk

Itemref	Quantity	Title/Name, designation, material, dimension etc			Article No./Reference	
Designed by MH	Checked by DR	Approved by - date	Filename	Date 09/06/13	Scale PRINT A1	
HMS ALLIANCE (RESTORATIONS 2012/13)				BOW DECK AREA - STEELWORK I-D		
				MLD-12-121-11	Edition AB	Sheet