


Assumed cable/mains runs and chambers, all Statutory Undertaker's to confirm.

Assumed cable/mains runs and chambers, all Statutory Undertaker's to confirm.

KEY


- BT
- GAS
- High V
- New ducting
- Utilities shaded GOLD denote approx. extents of Statutory Undertakers Plan to be removed from DCC's structure and diverted along proposed routes.
- Areas shaded GREY denotes bitmac surfacing
- Areas shaded CREAM denotes steel frame structure.

** Note - all options are preliminary and are to be agreed with Utilities Providers.*

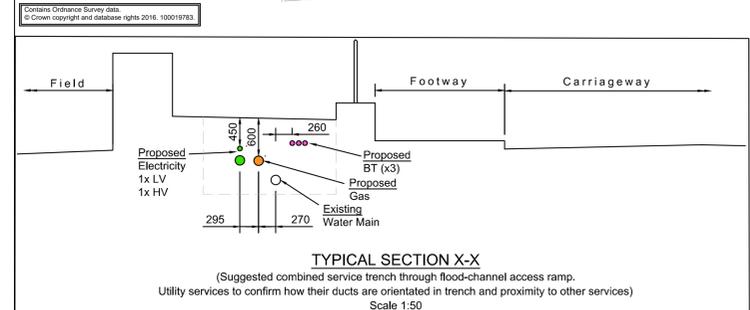

SCHEDULE OF DUCTS
(in proposed directional drilling/trenching)

Reference	Statutory Undertaker	Number of Ducts	Diameter of Ducts (outside dia)
D1	Western Power Distribution	5	180 Ø
	British Telecom	3	125 Ø
D2	Wales & West Utilities	1	315 Ø
	Western Power Distribution	2	180 Ø
T1	British Telecom	3	125 Ø
	Wales & West Utilities	-	No ducts (service in ground)
T2	Western Power Distribution	3	No ducts (service in ground)
	British Telecom	3	125 Ø
	Wales & West Utilities	-	No ducts (service in ground)
	Western Power Distribution	-	No ducts (service in ground)

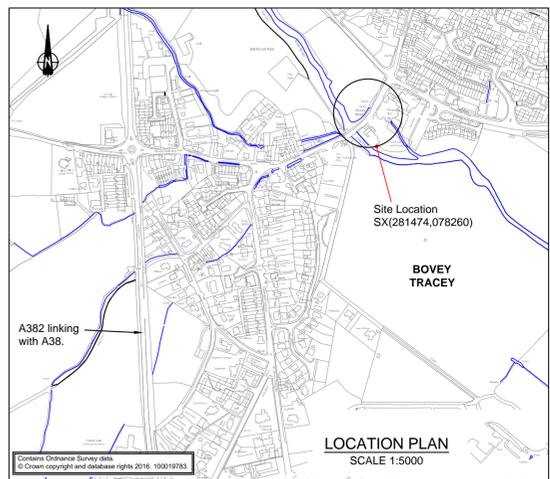

Devon County Council

Engineering Design Group

Matford Offices
County Hall
Topsham Road
Exeter
EX2 4QD

Tel 0845 155 1004
Fax 01392 382342
customer@devon.gov.uk
www.devon.gov.uk

JOB

**689 BOVEY BRIDGE
CANTILEVER WALKWAY**

DRAWING TITLE

**SCHEME LAYOUT
PROPOSED SERVICES DIVERSION
(COMBINED)
AS BUILT**

NOTES

No.	details	No.	details

Rev	Date	Drawn	Revisions	Chk
0	15/11/2016	JO		
A	10/1/2017	JO	Position of open trench next to Old Thatch changed, duct sizes amended in table.	
B	14/2/2017	JO	Position of pipe welding area extended in Mr Hall's field. Number of ducts & sizes amended in table.	
AB	May 2017	JO	As Built Layout	

Do not scale from this drawing in either hard or electronic format. No responsibility is accepted where this drawing is used in circumstances other than that for which it was originally prepared and issued.

Drawing Number N09005/ 50 AB	Revision AB
Scale(s) Main Plan 1:250	Size A1