

SDF/E/1009

ABD

NOTES

1. These notes supplement those on Drg.No. SGN/E/1000.
2. Longitudinal lane markings are to be in line across the carriageway.
3. Diagram nos are those stated in the Traffic Signs Regulations and General Directions 1981 and all current amendments thereof.
4. For details of line markings refer to the Traffic Signs Manual, chapter 5.
5. All road studs on bridgeworks shall be of the reflecting, non-depressible type, nominal width 100mm. Studs adjacent to edge lines shall be positioned on the non-carriageway side of the line.
6. All road studs on embankments shall be nominal width 100mm and of similar type to those used on adjacent Contracts (depressible or non-depressible). Studs adjacent to edge lines shall be located relative to the lines according to their type.
7. Edge of carriageway road studs are to be interspaced with white lane marking road studs as drawn on SDF/E/1010.
8. Plug 1012.1 shall be of the raised rib type marking.

PLAN OF CROSSING CH. 0 TO CH. 1970
1:2500

PLAN OF CROSSING CH. 1970 TO CH. 3920
1:2500

PLAN OF CROSSING CH. 3920 TO CH. 5902.218
1:2500

Lane line no	Chainages from to	Eastbound/Westbound carriageway	Replace 1005 by Diag No.	stud spacing
1	5385.000 5445.689	Eastbound	1010	18m*
1	5385.000 5445.689	Westbound	1004	9m
2	5385.000 5445.689	Westbound	1004	9m

TABLE 2. ALTERNATIVE LANE MARKINGS TO DIAG 1005.
For continuation beyond Ch5445.689 refer to plan on Drg No. SDF/E/1010
* OVER THIS LENGTH STUDS TO BE AT SAME CHAINAGE AS ON THE ADJACENT 1005 LINE

KEY TO ROAD MARKINGS		
DIAG. No.	DESCRIPTION	LINE WIDTH
1004	6m Mark 3m Gap	150mm
1005	2m Mark 7m Gap	100mm
1012.1	Continuous Line	200mm
1010	1m Mark 1m Gap	200mm

TABLE 1

REV	DATE	DRAWN	VER	APPROV	AMENDMENT	STATUS	CHECKER
G	10/94	DJB	CHE	DMM	AS BUILT DRAWING	ABD	
F	28/96	DJB	S.F.L		LANE GAIN & LANE LOSS MARKINGS REVISED IN ACCORDANCE WITH T.S.R. NOT REISSUED TO CHECKER	MIC	
E	May/94	PMJS	MP		Note 6 and 8 revised. Slip road markings revised in accordance with G.A. requirements. Not re-issued to checker.	MIC	
D	Oct/92	JM	MP	AJY	Checkers comments C235 incorporated. Approved by checker for construction issue.	CI	
C	Mar/92	SAME	MP	GEY	T150/30 requirements met, notes added to Table 2 added. Table 1 and B-8 revised. Detail A added, superfluous dims removed A-A and B-B.	FCH	
B	Oct/91	MCC	RJS	MP	Checkers comments; Notes 1 & 5 and section B-8 corrected. Key added.	FCH	
A	May/91	PN	RJS	MP	Title block amended.	FCH	
-	Feb/91	PJS	MP	GEY	Initial issue.	FCC	

S Severn River Crossing Plc

LAING GTM

SECOND SEVERN CROSSING

DRAWING TITLE
CARRIAGEWAY MARKINGS
SHEET 1 OF 2


HALCROW S.E.E. Originator's Drawing No.

Independent Checker Signature: _____ Date: _____ Revision: _____


Scale 1:2500 1:100 1:50

© 1991 LAING-GTM Joint Venture

Drawing Number **SDF/E/1009** Rev. **G**

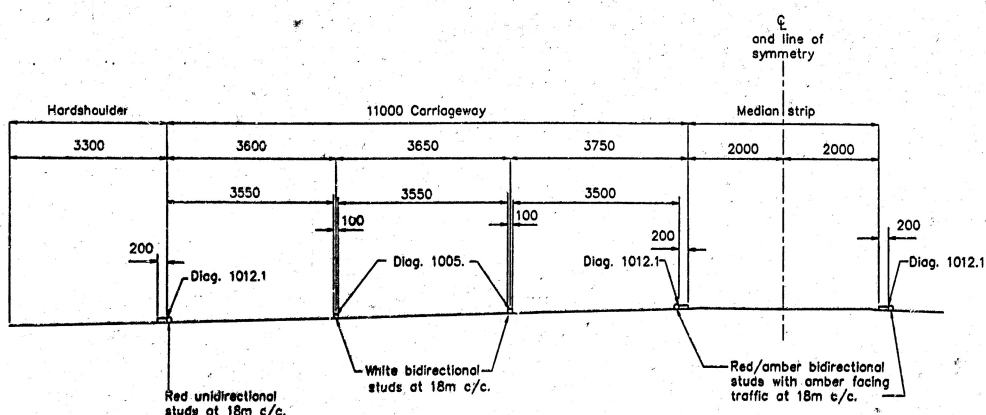

SECTION A-A
CH. 0 TO CH. 400
1:50

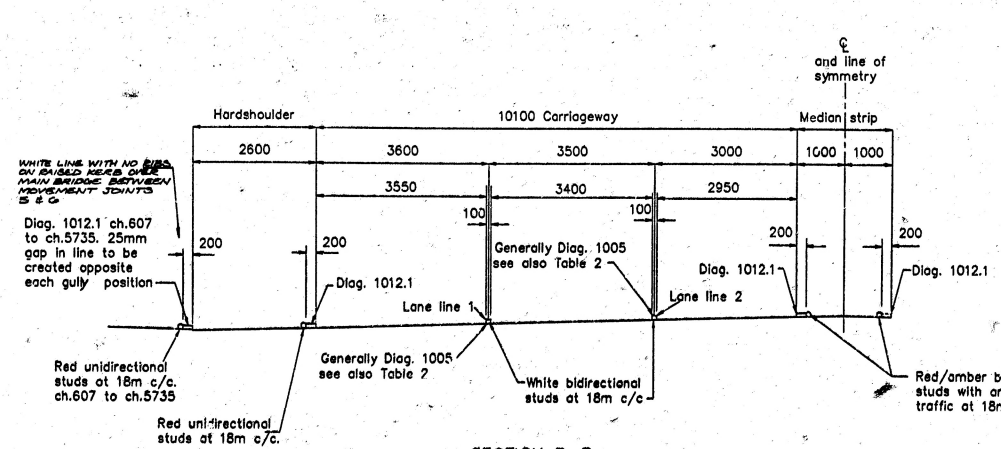

SECTION B-B
CH. 600 TO CH. 5445.689
1:50

