


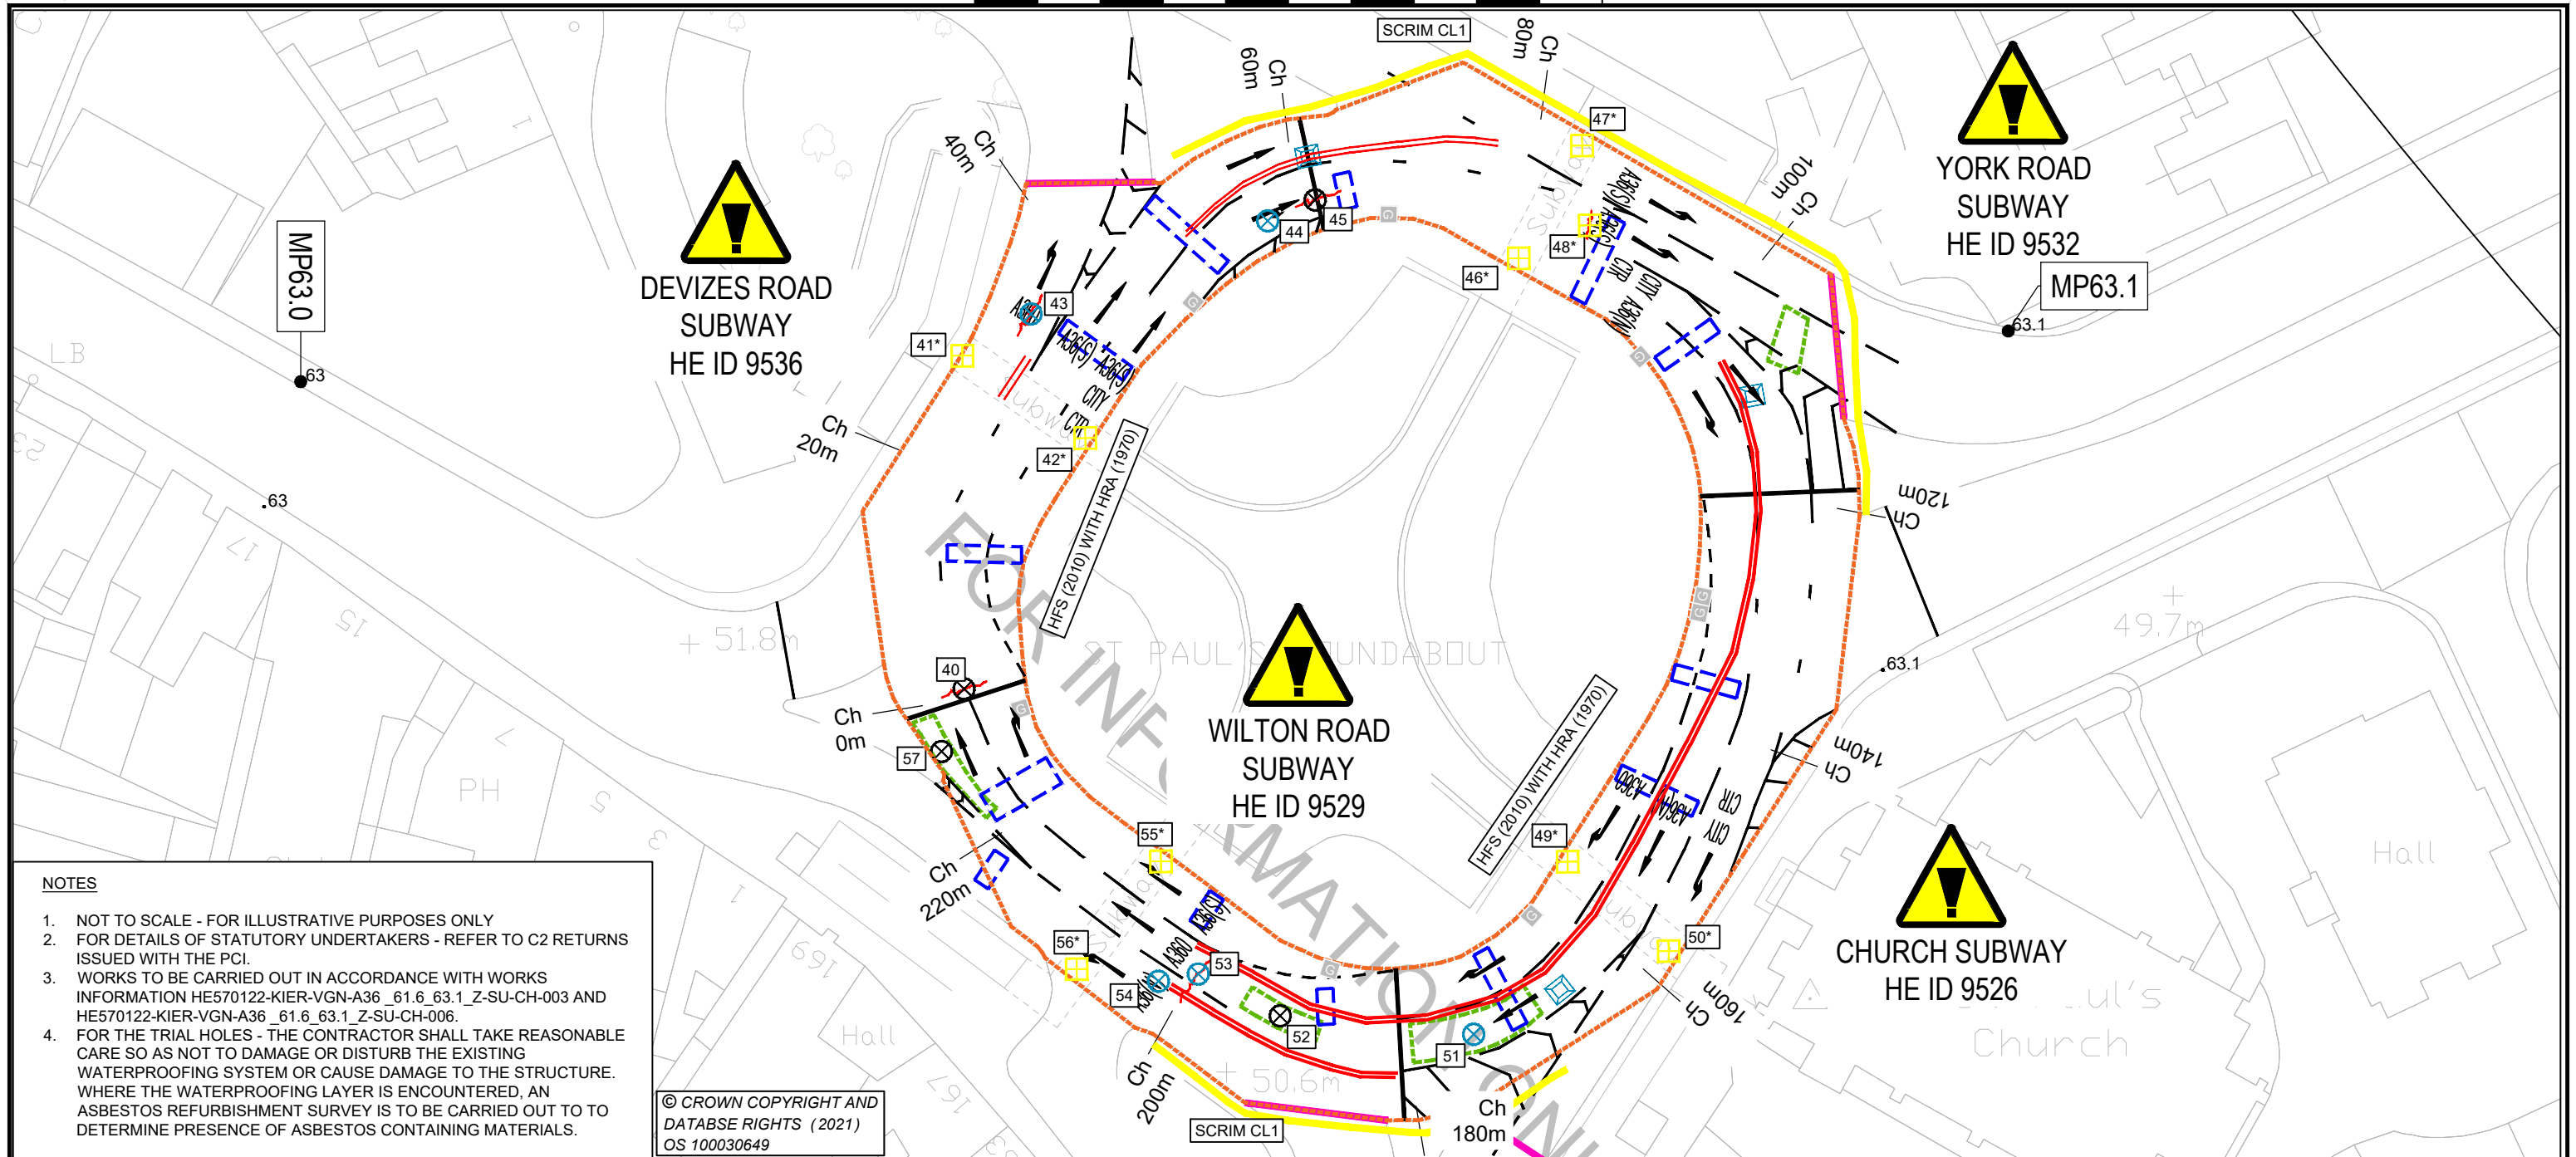

NOTES

1. NOT TO SCALE - FOR ILLUSTRATIVE PURPOSES ONLY
2. FOR DETAILS OF STATUTORY UNDERTAKERS - REFER TO C2 RETURNS ISSUED WITH THE PCI.
3. WORKS TO BE CARRIED OUT IN ACCORDANCE WITH WORKS INFORMATION HE570122-KIER-VGN-A36_61.6_63.1_Z-SU-CH-003 AND HE570122-KIER-VGN-A36_61.6_63.1_Z-SU-CH-006.
4. FOR THE TRIAL HOLES - THE CONTRACTOR SHALL TAKE REASONABLE CARE SO AS NOT TO DAMAGE OR DISTURB THE EXISTING WATERPROOFING SYSTEM OR CAUSE DAMAGE TO THE STRUCTURE. WHERE THE WATERPROOFING LAYER IS ENCOUNTERED, AN ASBESTOS REFURBISHMENT SURVEY IS TO BE CARRIED OUT TO DETERMINE PRESENCE OF ASBESTOS CONTAINING MATERIALS.

© CROWN COPYRIGHT AND
DATABASE RIGHTS (2021)
OS 100030649

KEY

Ch
X m

SECTION CHAINAGE AT
ROUNDABOUT
(3900A36/531)

LOCATION TO BE TRIAL
HOLED AND TESTED FOR
ACM. (NOTE 4)

DEFECTS KEY:

- Core crack depth(mm)
- Transverse crack minor
- Transverse crack major
- Long. crack minor
- Long. crack major
- Photo
- Plug joint
- Loops
- Fatting
- Open long. joint
- Const. joint
- Patch
- Failed patch
- Rutting
- Mechanical joint
- Mud pumping
- Minor fretting
- Major fretting
- Minor surface deterioration
- Major surface deterioration
- Depression
- Minor crazing
- Major crazing
- Pothole
- Nodes
- Ironwork
- Gully
- Core location (tar)
- Settlement
- Structure/Bridge
- Core location (No Tar)
- Trafficked Lane
- Existing HFS
- New HFS
- Site to be cored
- Core Requires DCP
- SCRIM Deficiency
- Texture < 0.8mm

CLIENT



AGENT



PROJECT NAME A36 BEMERTON INCL RBT AT MP63.0 NB & SB MP61.6 - 63.1 RS

DRAWING TITLE ST PAUL'S ROUNDABOUT DEFECT PLAN

REFERENCE

SCALE : NOT TO SCALE

DIMENSIONS : m

COPYRIGHT ©KIER

ORIG DWG SIZE: A3

SUITABILITY: A

DRAWING STATUS

WORK IN PROGRESS

PRELIMINARY

CONSTRUCTION

AS-BUILT

FOR CONSTRUCTION

C1	FIRST ISSUE	EE	EE	OLR	GR	24/03/21
REV	DETAILS	DRWN	DES	CHKD	APPD	DATE

DRAWING NUMBER				KIER PROJECT REFERENCE	
PROJECT	ORIGINATOR	VOLUME		570122	
570122	KIER	VGN		REVISION	
A36_61.6_63.1_Z	DR	CH	0000_01	C1	
LOCATION	TYPE	ROLE	NUMBER		