


DO NOT SCALE

THIS DRAWING IS TO BE USED FOR ELECTRICAL INFORMATION ONLY

LEGEND

-  SOUNDER
-  STROBE LIGHT
-  COMBINED SOUNDER/STROBE
-  SMOKE DETECTOR
-  HEAT DETECTOR
-  MANUAL CALL POINT
-  MAGNETIC DOOR HOLDER (LINKED TO FIRE ALARM BY INTERFACE UNIT)
-  INTERFACE UNIT
-  END OF LINE DEVICE
-  DEVICE
-  MAGNETIC DOOR LOCK
-  SMOKE DAMPER

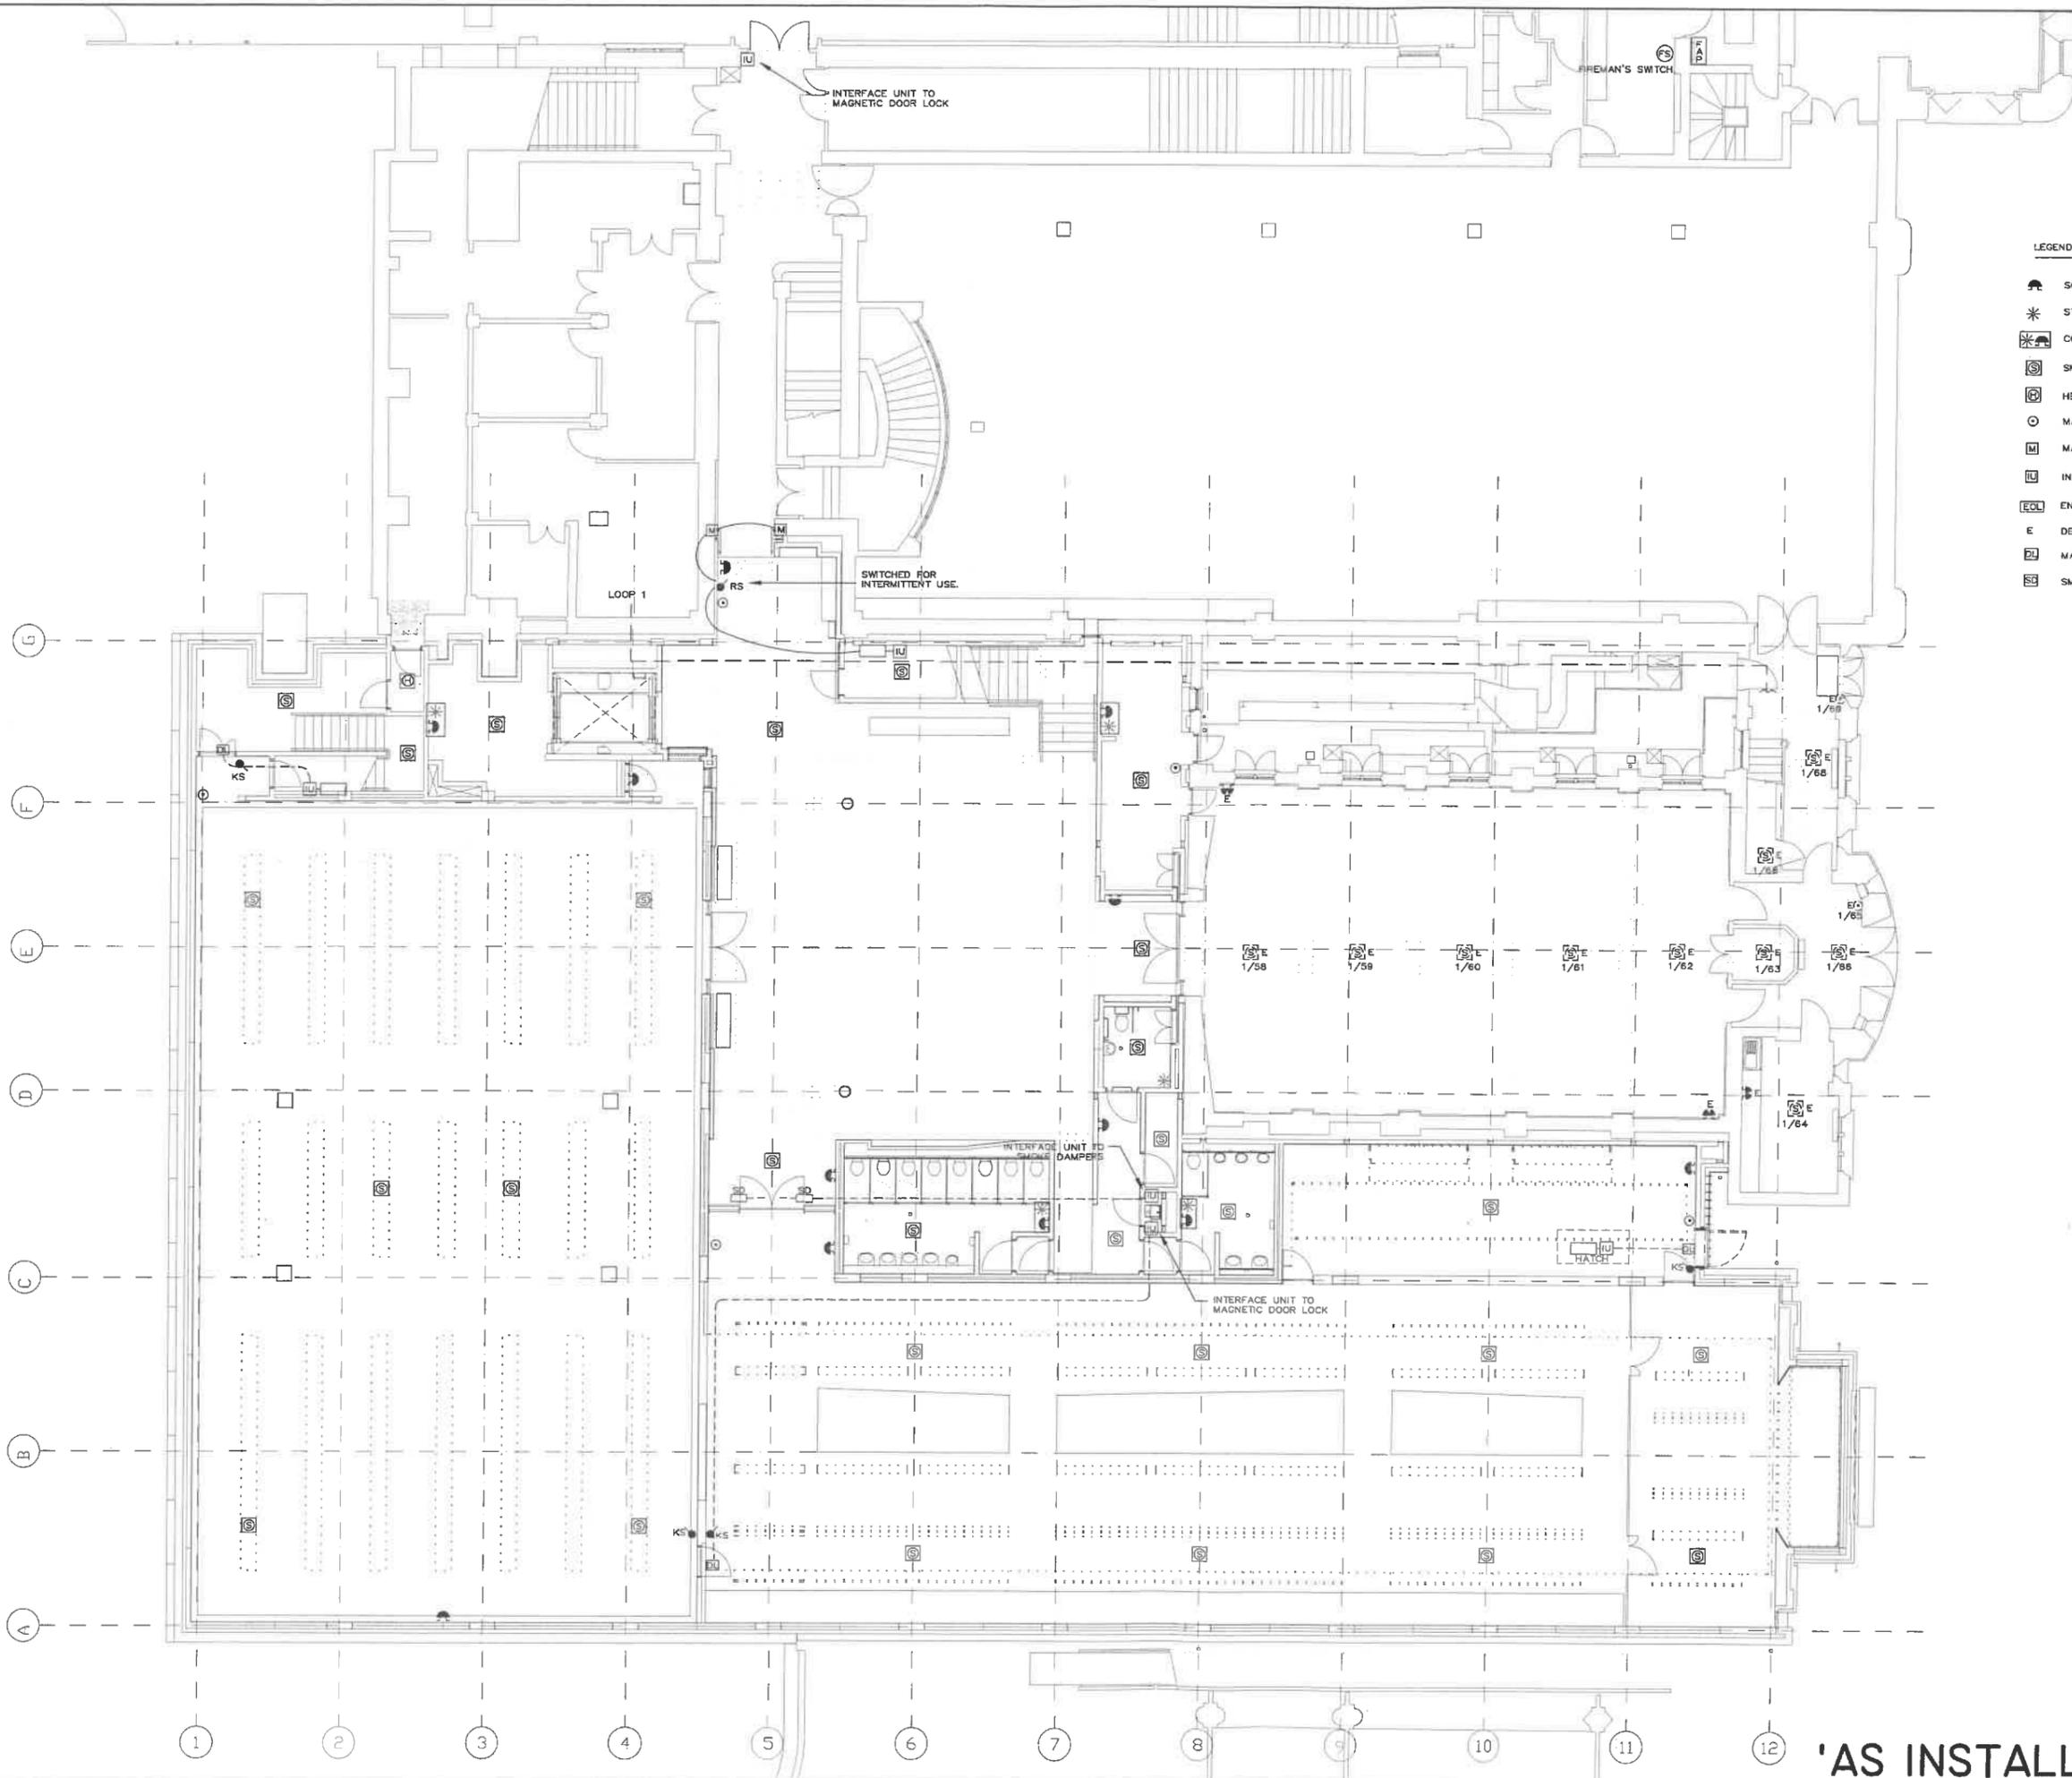

CUMNOR ROAD, WOOTTON, BOWS HILL, OXFORD OX1 5JW
 TEL. No. OXFORD 730881
 FACSIMILE No. 01865 326750

JOB HORNIMAN 2001
 MAIN BUILDING (PHASE II)

TITLE FIRE ALARM & LIGHTNING
 PROTECTION
 LEVEL 1

DATE DEC. 01	SCALE 1:100@A1
DRAWN LO	CHECKED RW
DRAWING No. 1714 W(5)001	REVISION

'AS INSTALLED'