
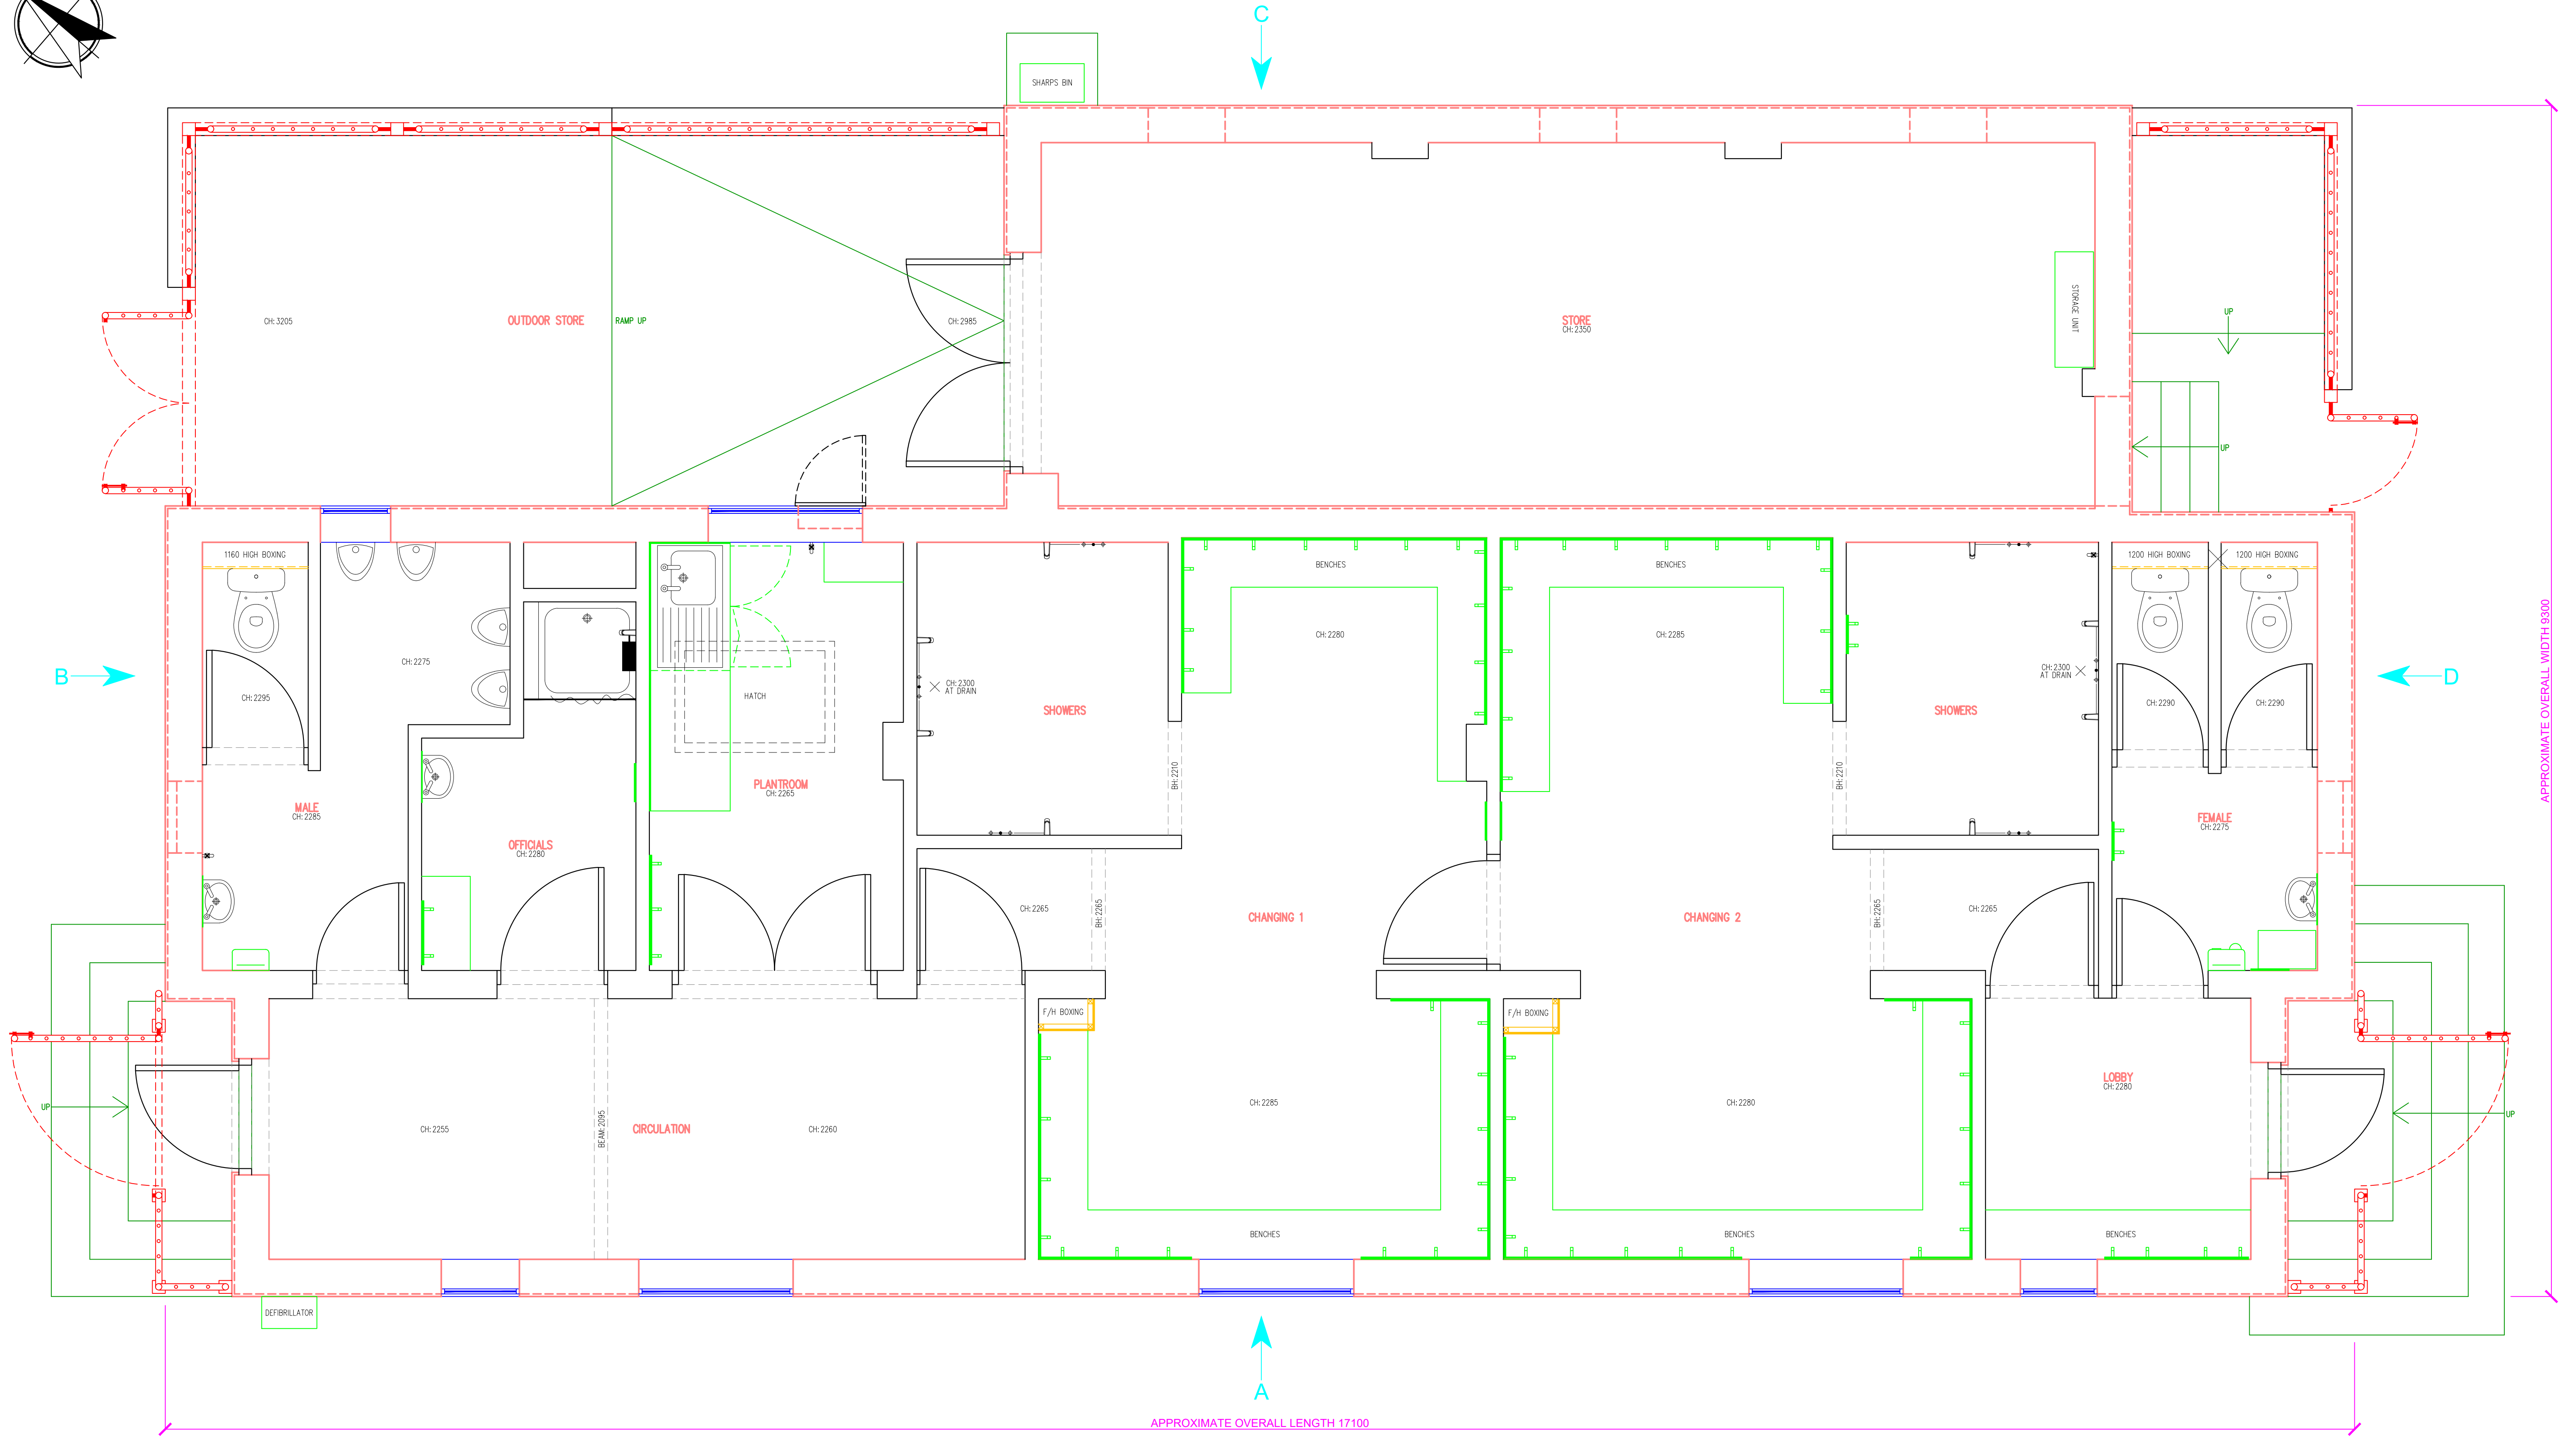


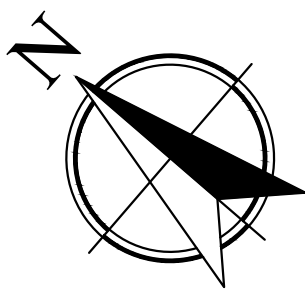

Safety, Health & Environmental Information

All works are to be carried out by a person competent to undertake the type of work indicated on this drawing. This drawing is to be read in conjunction with the risk register produced for inclusion in the Health & Safety Plan. In addition to the hazards/risks normally associated with the types of works detailed on the drawing, note the following.

Construction: Refer to relevant H/S & risk register
Maintenance/Cleaning: Refer to relevant manual
Demolition/Adaption: Refer to relevant manual
Environmental: Refer to Asbestos Survey

All works are to comply with latest Building Regulation Requirements

Notes.
1. All dimensions are to be checked on site prior to any works taking place.

Do Not Scale from Drawing

Client



Meadowcroft Community Centre
Addison Crescent, Swindon, SN2 7JX
Tel: 01793 823761

Contractor



Hyde Road, Upper Stratton, Swindon, SN2 7RB
Tel: 01793 835 765 Fax: 01793 825 725
Email: enquires@edmont.co.uk Web: www.edmont.co.uk

Project



The Pavilion Reburishment

DRAWING STATUS

- ☒ PRELIMINARY/FOR INFORMATION ONLY ☐ FOR APPROVAL
☐ WORKING DRAWING ☐ APPROVED
☐ FOR CONSTRUCTION ☒ RECORD DRAWING

FI	FOR INFORMATION	19.7.24
Rev.	Description.	Date.

Drawing Title

Ground Floor
Existing Layout

Drawn By	Date	Scale	Sheet Size
LJH	Jul.2024	1:25	A1
Project No.	Discipline	Drawing No.	Revision
GE1610	FO	001	FI