


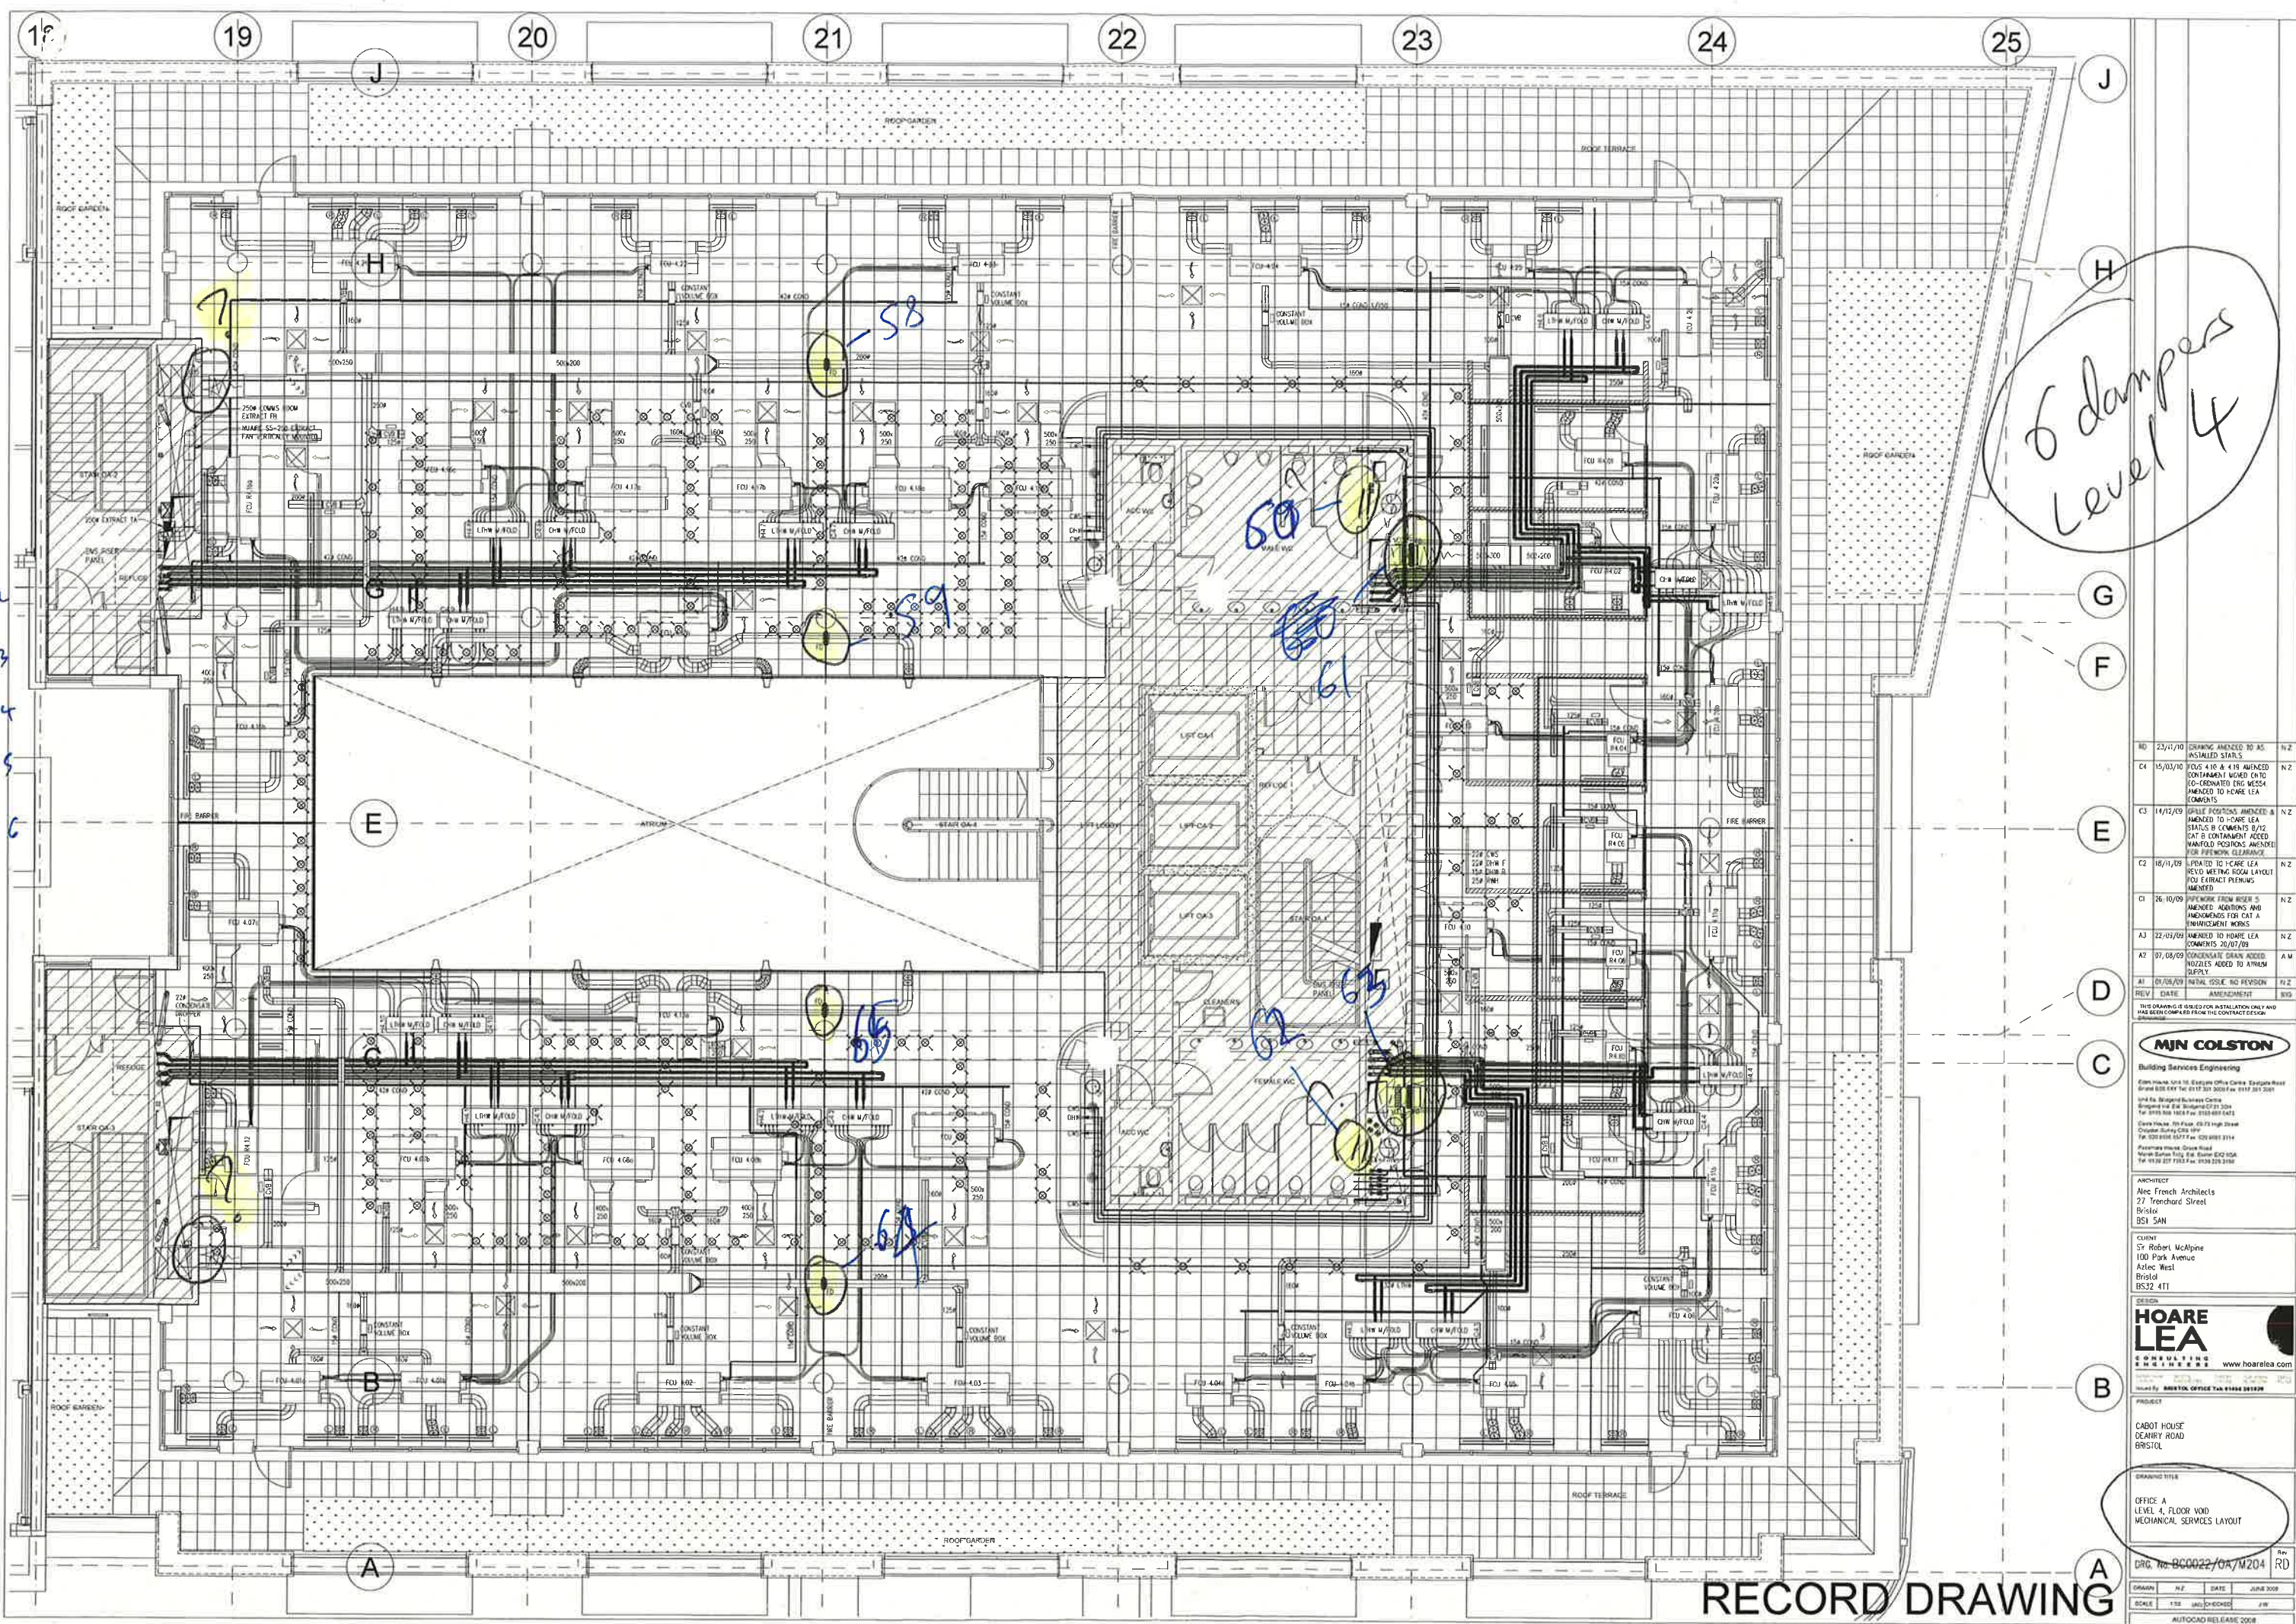

5 dampers
Level 4

NO	23/11/10	DRAWING AMENDED TO AS	NZ
C4	15/03/10	FOUS 410 & 418 AMENDED	NZ
C3	14/12/09	SHALE POSITIONS AMENDED &	NZ
C2	15/11/09	UPDATED TO CARE LEA	NZ
C1	26/10/09	UPDATED TO CARE LEA	NZ
A3	22/09/09	AMENDED TO CARE LEA	NZ
A2	07/08/09	CONDENSATE DRAIN ADDED	AM
A1	01/06/09	INITIAL ISSUE, NO REVISION	NZ
REV	DATE	AMENDMENT	BY

MJN COLSTON
Building Services Engineering
Colston House, 104-106, Exmouth Office Centre, Exmouth Road
Bristol BS1 1JF Tel: 01274 381 300 Fax: 01274 381 301
Unit 10, Broughton Business Centre
Broughton Road, Broughton, Bristol BS1 1JF
Tel: 01274 381 300 Fax: 01274 381 301
Colston House, 104-106, Exmouth Office Centre, Exmouth Road
Bristol BS1 1JF Tel: 01274 381 300 Fax: 01274 381 301
Exmouth House, 104-106, Exmouth Office Centre, Exmouth Road
Bristol BS1 1JF Tel: 01274 381 300 Fax: 01274 381 301

ARCHITECT
Nec French Architects
27 Trenchard Street
Bristol
BS1 1AN
CLIENT
St Robert McAlpine
100 Park Avenue
Arlene West
Bristol
BS2 4TT

HOARE LEA
CONSULTING ENGINEERS
www.hoarelea.com
Bristol Office Tel: 01274 381 300


PROJECT
CABOT HOUSE
DEARBY ROAD
BRISTOL

DRAWING TITLE
OFFICE A
LEVEL 4, FLOOR VOID
MECHANICAL SERVICES LAYOUT

DRG. No. BC0022/0A/M204 RD
DRAWN: N.Z. DATE: JUN 2009
SCALE: 1/16 AND CHECKED: J.W.
AUTOCAD RELEASE 2008

RECORD DRAWING

Basement boiler room

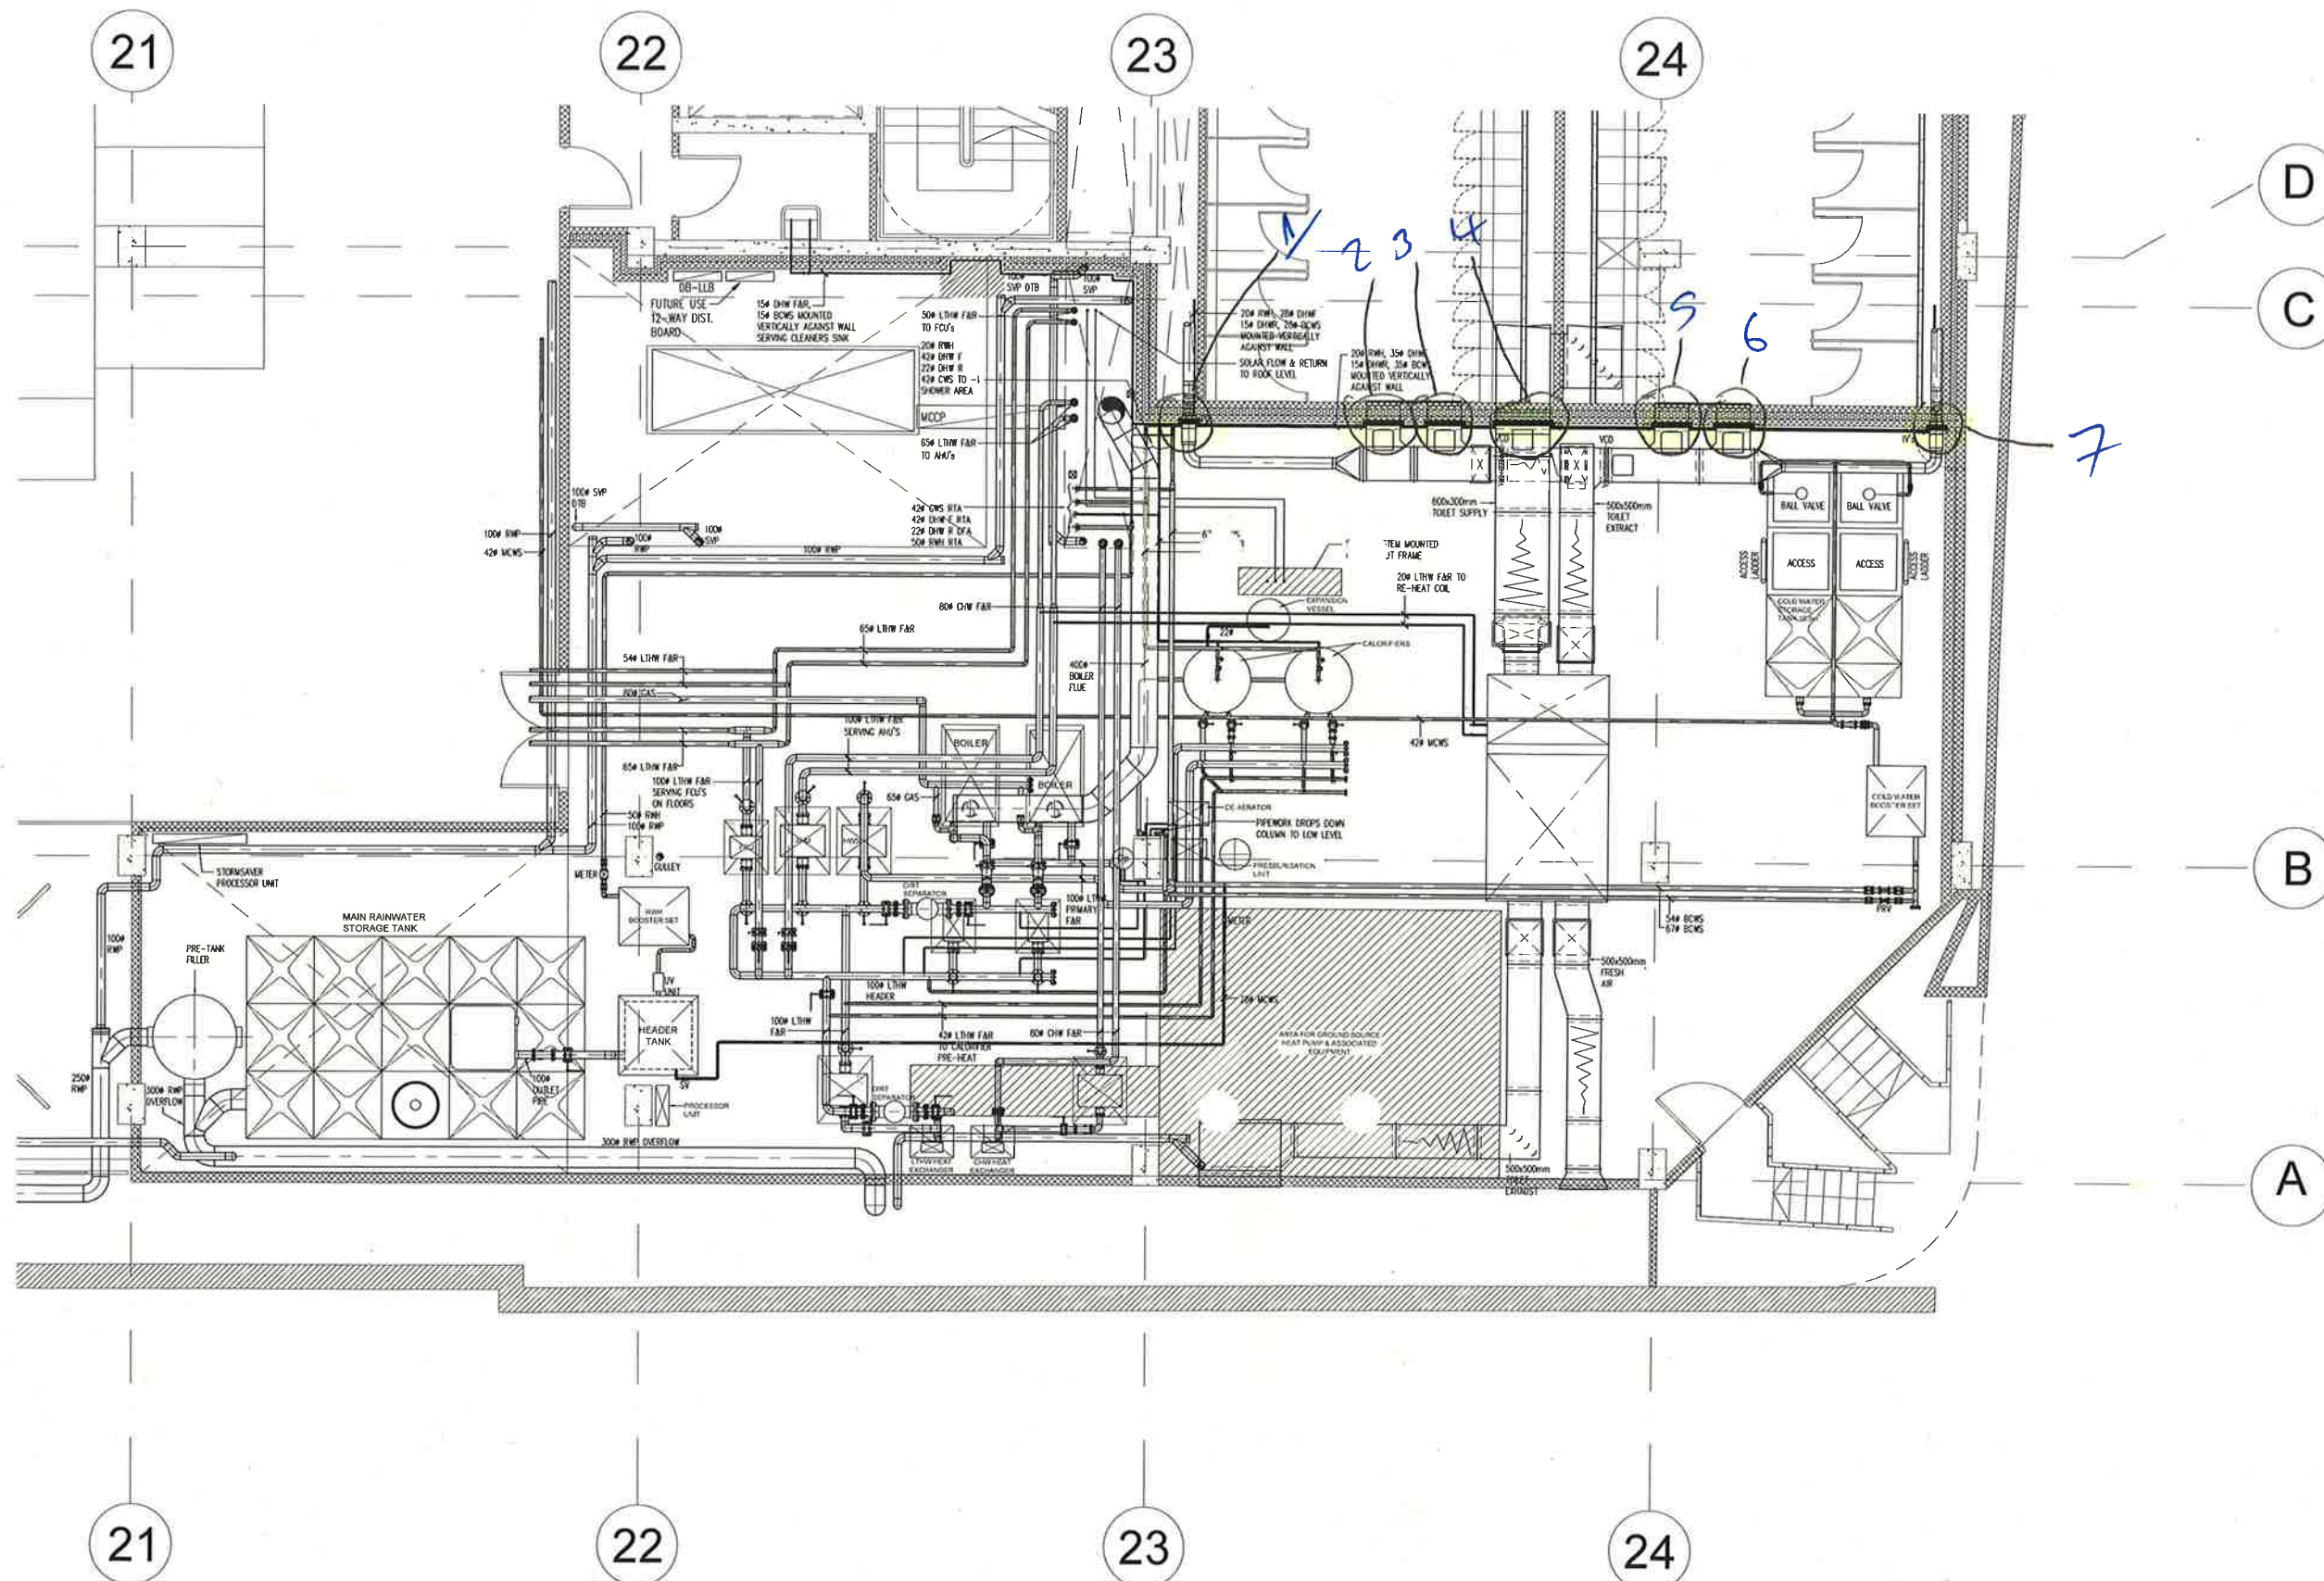

REV	DATE	AMENDMENT	SIG.
RD	23/11/10	DRAWING AMENDED TO AS INSTALLED STATUS	N.Z.
C2	01/12/09	RAIN WATER HARVESTING EQUIPMENT ADDED. GAS SUPPLY TO BOILERS AMENDED	N.Z.
C1	20/11/09	MECHANICAL SERVICES AMENDED & ISSUED FOR CONSTRUCTION	N.Z.

THIS DRAWING IS ISSUED FOR INSTALLATION ONLY AND HAS BEEN COMPILED FROM THE CONTRACT DESIGN DRAWINGS

MJN COLSTON
Building Services Engineering
Eden House, Unit 10, Eastgate Office Centre, Eastgate Road
Bristol BS5 6XY Tel: 0117 301 3000 Fax: 0117 301 3001
Unit 9, Bridgend Business Centre
Bridgend Ind. Est. Bridgend CF31 3SH
Tel: 0165 666 1806 Fax: 0165 666 0473
Davis House, 7th Floor, 69-73 High Street
Croydon Surrey CR9 1PY
Tel: 020 8686 5577 Fax: 020 8681 3114
Passmore House, Grafton Road
Marsh Barton Tring, East. Essex SG2 9QA
Tel: 0138 227 7352 Fax: 0138 225 3150

ARCHITECT
Alec French Architects
27 Trenchard Street
Bristol
BS1 5AN

CLIENT
Sir Robert McAlpine
100 Park Avenue
Aztec West
Bristol
BS32 4TT

DESIGN
HOARE LEA
CONSULTING ENGINEERS
www.hoarelea.com
BIRMINGHAM BRISTOL CARDIFF LONDON MANCHESTER NEWCASTLE
Issued By: BRISTOL OFFICE Tel: 01454 201020

PROJECT
CABOT HOUSE
DEANERY ROAD, BRISTOL


DRAWING TITLE
OFFICE A
LEVEL -1
PLANT ROOM LAYOUT

DRG. No. BC0022/OA/M/220 Rev RD

DRAWN	W.A.	DATE	JULY 09
SCALE	1:50 (A1)	CHECKED	A.M.

AUTOCAD RELEASE 2008

RECORD DRAWING

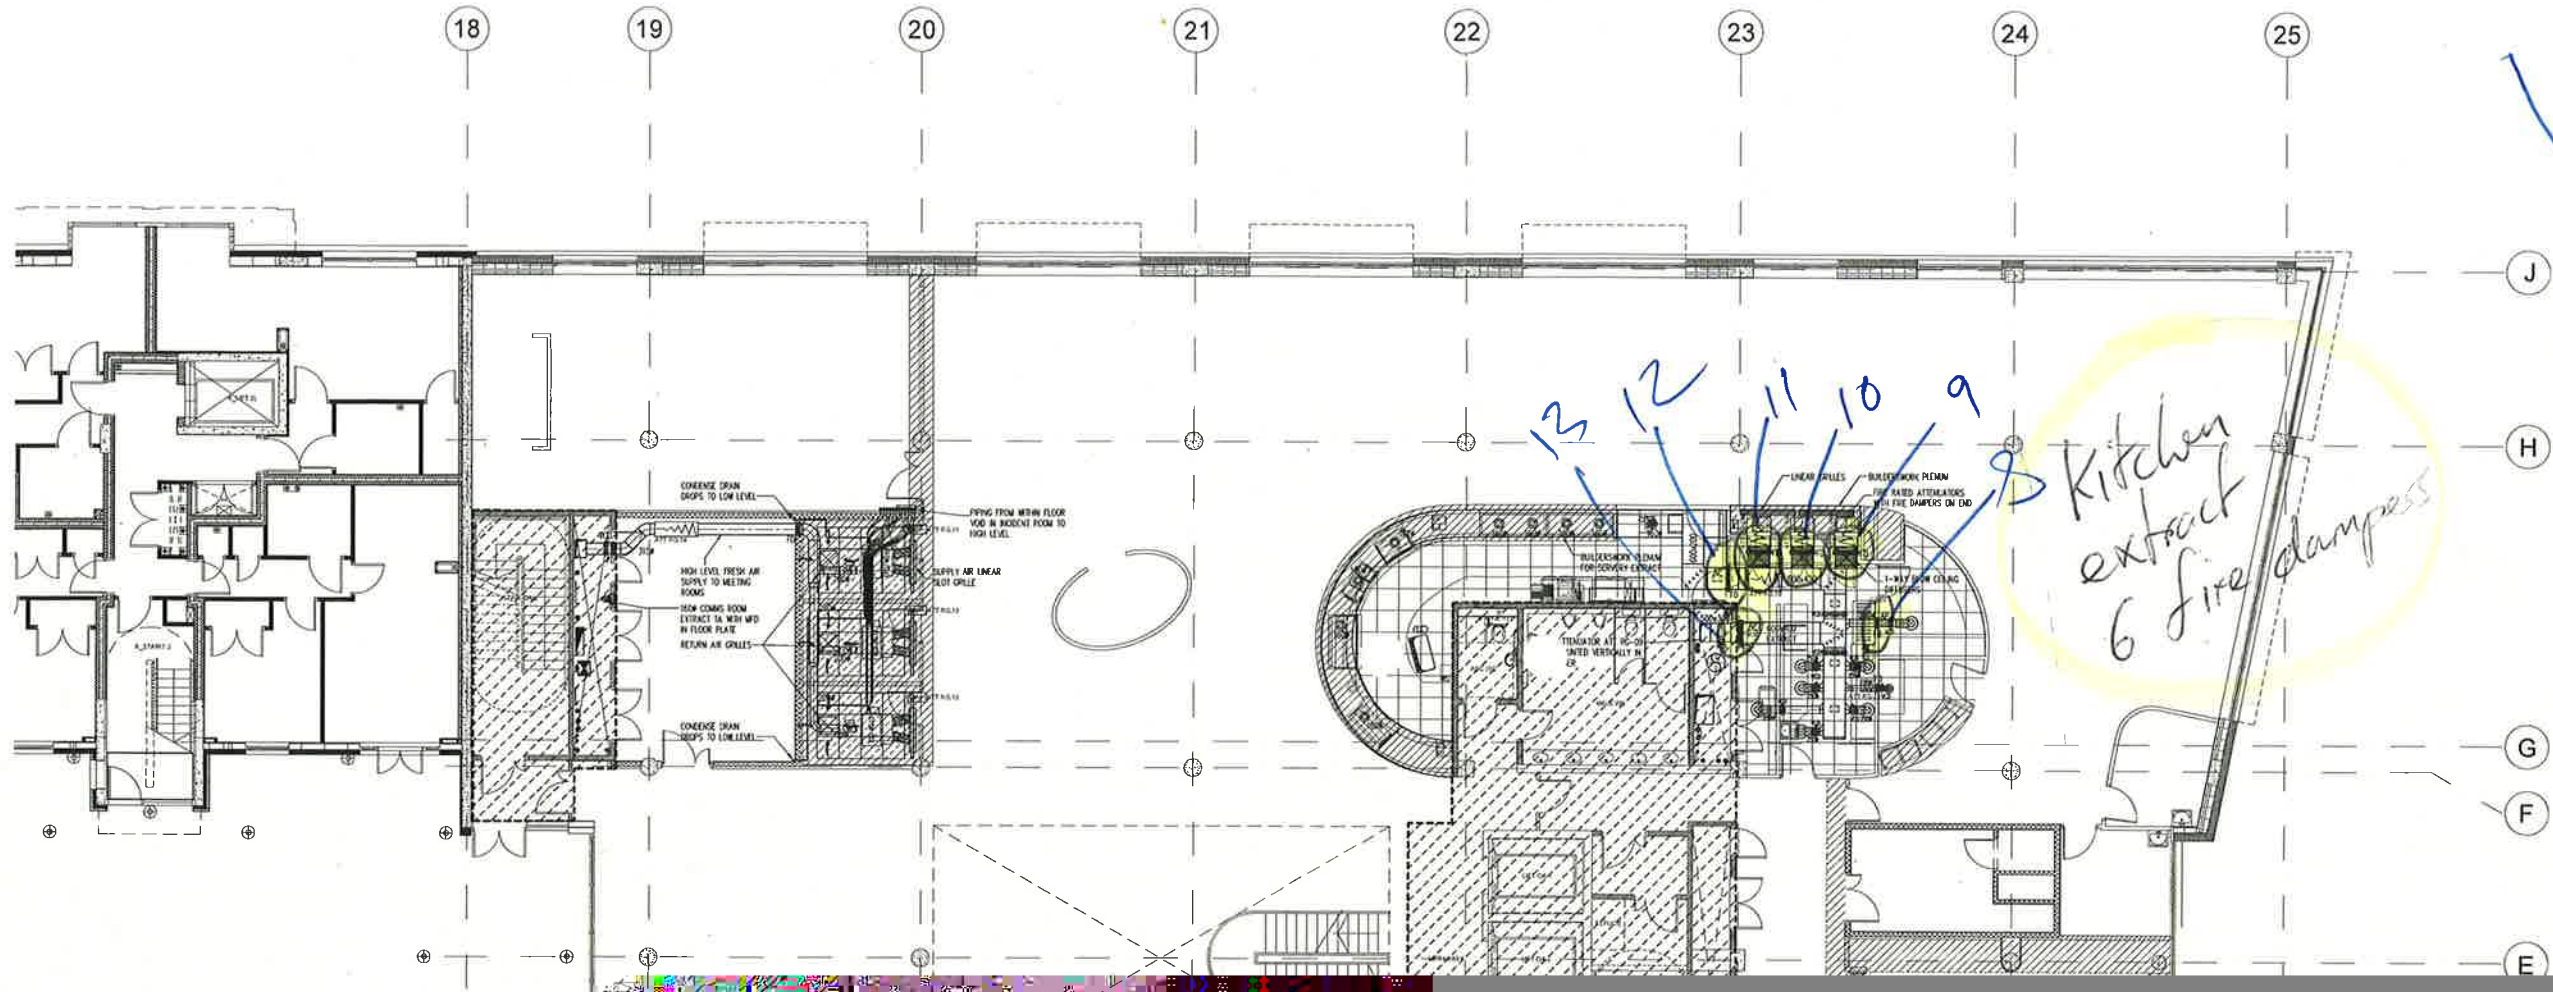

RD	23/11/10	DRAWING AMENDED TO AS INSTALLED STATUS	N.Z.
C1	22/04/10	INITIAL ISSUE NO REVISION	N.Z.
REV	DATE	AMENDMENT	SIG.
THIS DRAWING IS ISSUED FOR INSTALLATION ONLY AND HAS BEEN COMPILED FROM THE CONTRACT DESIGN DRAWINGS			



Building Services Engineering
 Eden House, Unit 10 Eastgate Office Centre, Eastgate Road
 Bristol BS5 8XY Tel: 0117 301

Bridgend Ind. Est. Bridgend CF31 3SH
 Tel: 0165 666 1808 Fax: 0165 666 0473

Davies House, 7th Floor, 69-73 High Street
 Croydon Surrey CR9 1PY
 Tel: 020 8696 5577 Fax: 020 8681 3114

Passmore House, Glance Road
 Marsh Barton Trigg Est Exeter EX2 8QA
 Tel: 0139 227 7352 Fax: 0139 225 3150

ARCHITECT
 Alec French Architects
 27 Trenchard Street
 Bristol
 BS1 5AN

CLIENT
 Sir Robert McAlpine
 100 Park Avenue
 Aztec West
 Bristol
 BS32 4TT

C N
www.hoarelea.com


BIRMINGHAM BRISTOL CARDIFF LEEDS
 LONDON MANCHESTER OXFORD PLYMOUTH
 Issued By BRISTOL OFFICE Tel: 01454 201020

PROJECT
 CABOT HOUSE
 DEANERY ROAD, BRISTOL

OFFICE A, LEVEL 0
 HIGH LEVEL MECHANICAL SERVICES LAYOUT

DRG No BC0022/OA/M/250 RD
 DRAWN N.Z. DATE APR 2010
 SCALE 00 (A) A M

Picture - hole in wall - damper on floor !!

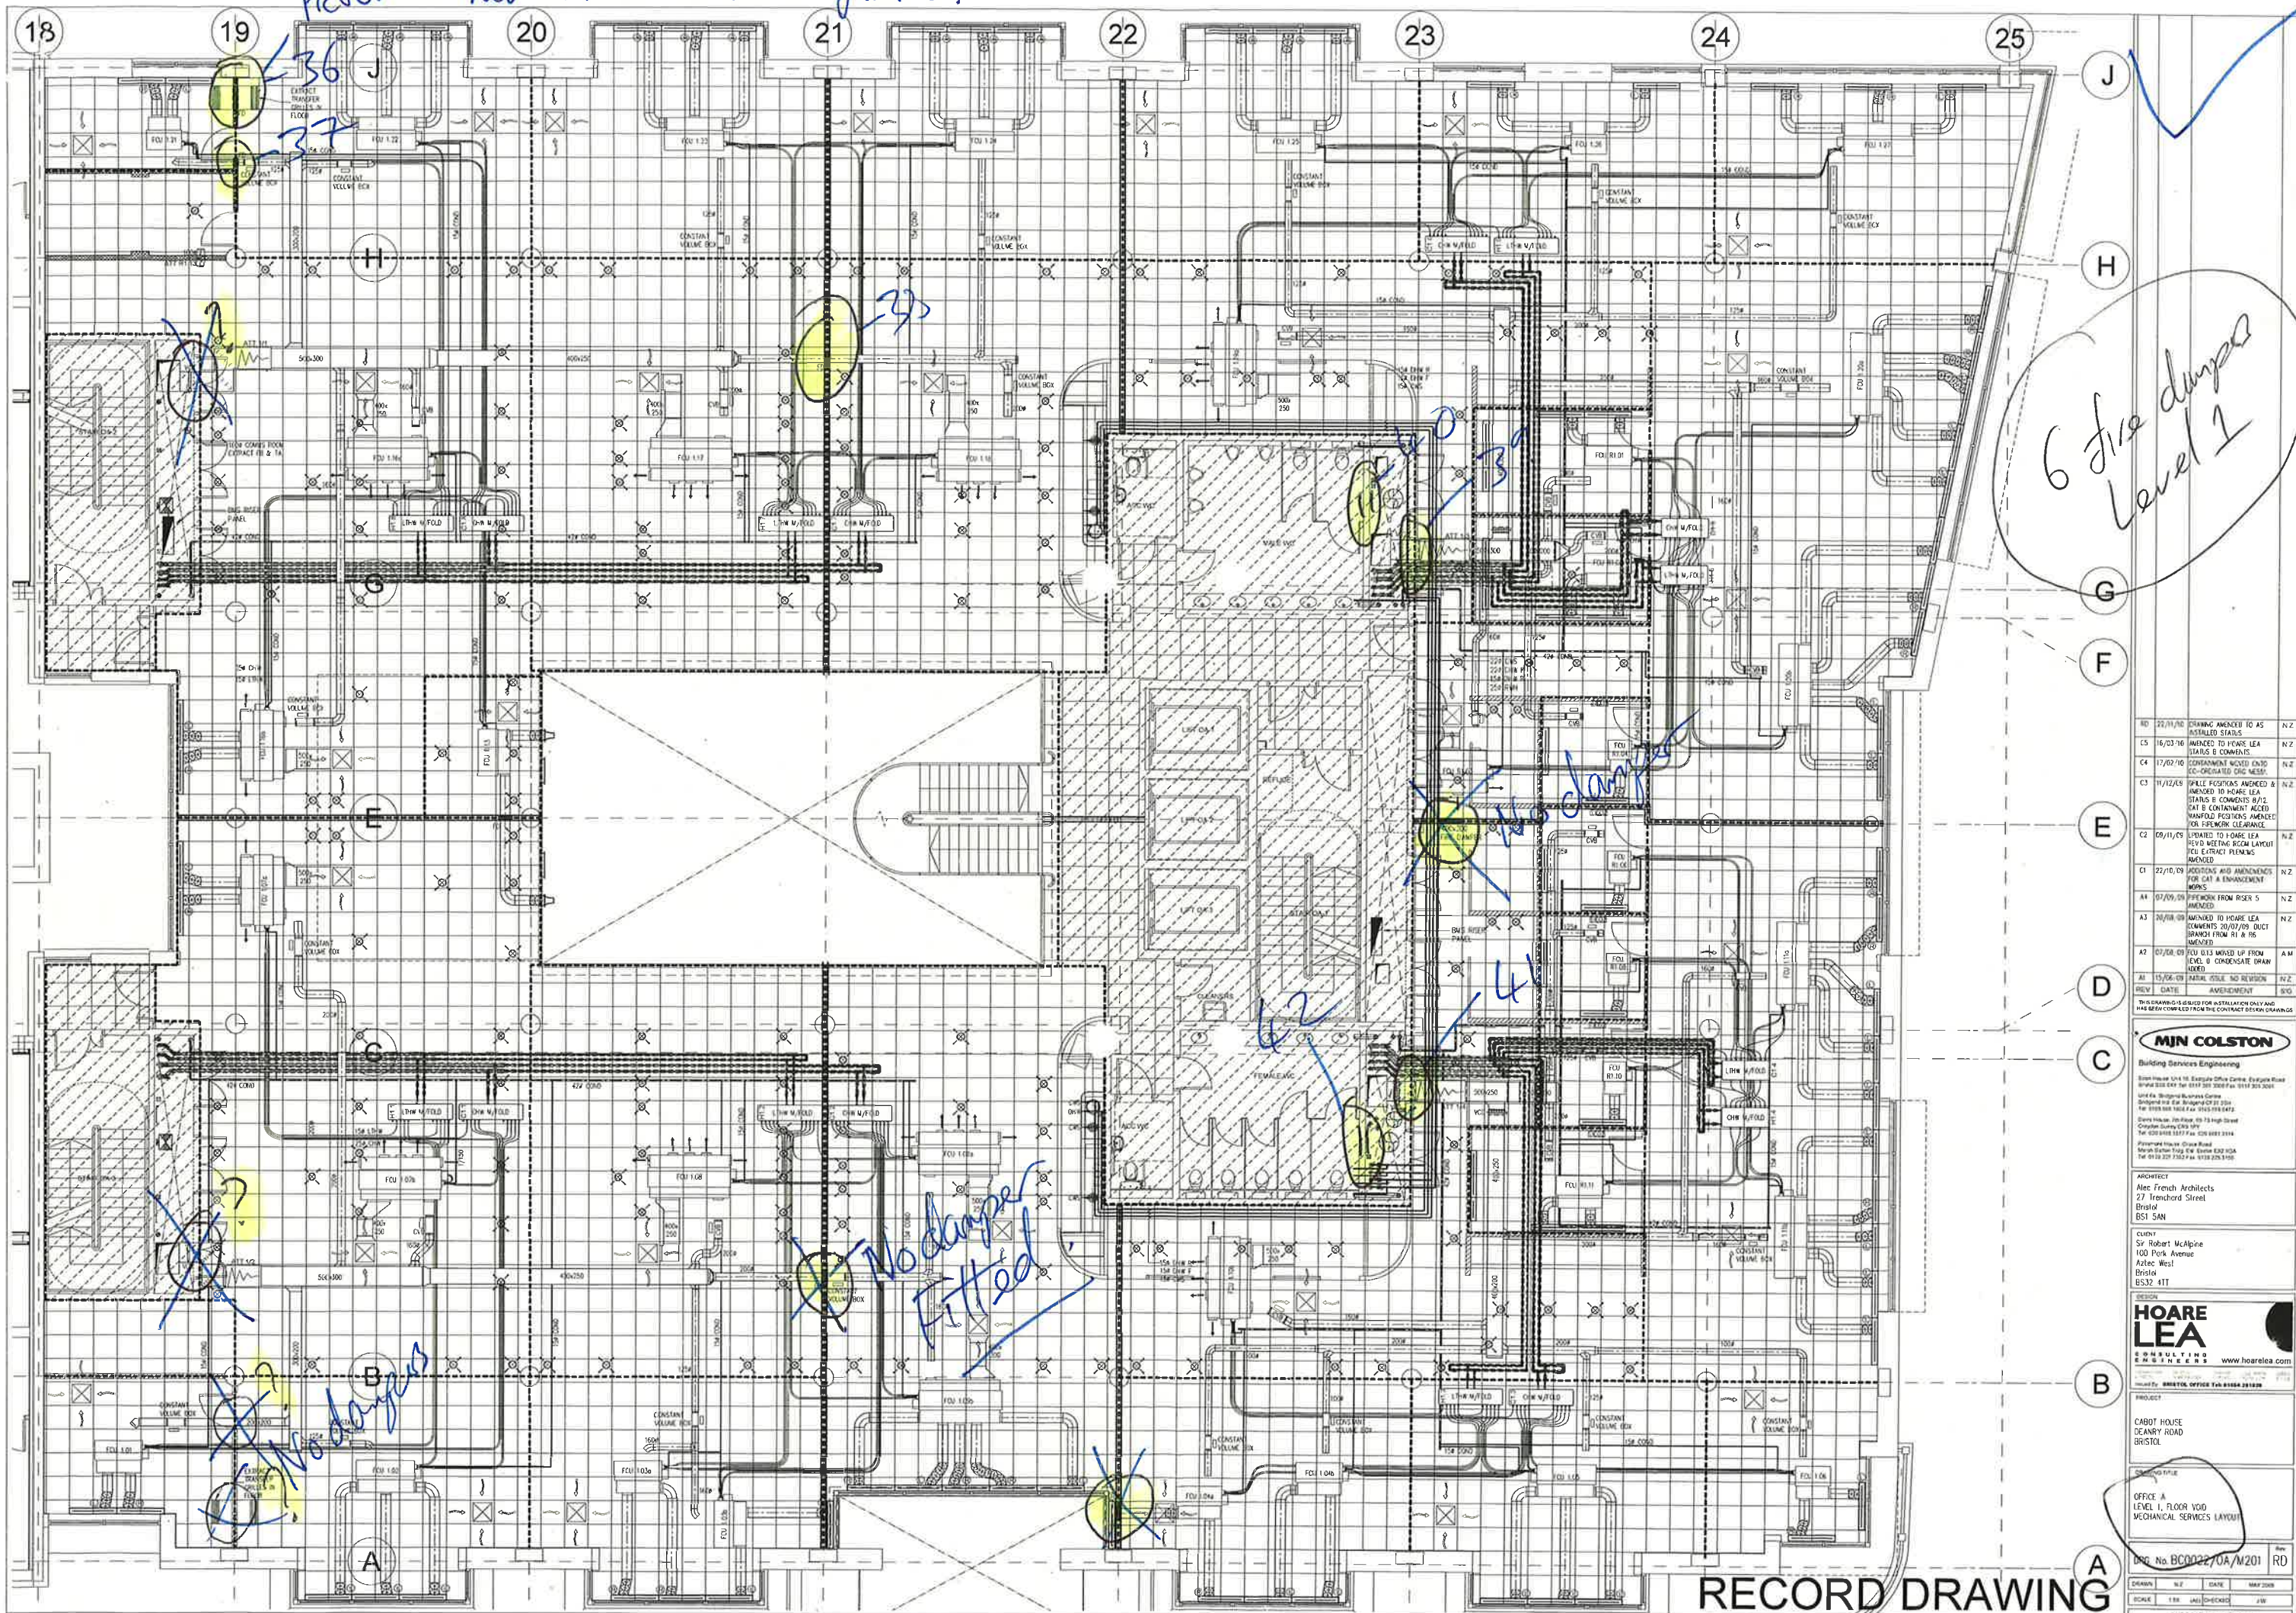

6 fire dampers
Level 1

No damper
Fitted

No damper

RECORD DRAWING

NO	22/11/10	DRAWING AMENDED TO AS	NZ
C5	16/03/10	AMENDED TO HOARE LEA	NZ
C4	17/02/10	CONTAINMENT NOVELT ONTO	NZ
C3	11/12/09	SPECIFIC POSITIONS AMENDED	NZ
C2	09/11/09	UPDATED TO HOARE LEA	NZ
C1	22/10/09	ADDITIONS AND AMENDMENTS	NZ
A4	07/09/09	DIFFERENCES FROM RISER 5	NZ
A3	26/08/09	AMENDED TO HOARE LEA	NZ
A2	07/08/09	FOU DLS WROTE UP FROM	AM
A1	15/06/09	REVISION: NO REVISION	NZ
REV	DATE	AMENDMENT	NO

MJN COLSTON
Building Services Engineering
1000 House Unit 10, Example Office Centre, Example Road
Example City, Example State, Example Postcode
Example Tel: 01234 567890 Fax: 01234 567891
Example Email: info@example.co.uk
Example Website: www.example.co.uk


ARCHITECT
Mec French Architects
27, Tronchard Street
Bristol
BS1 5AN

CLIENT
Sir Robert McAlpine
100 Park Avenue
Aston, West
Bristol
BS32 4TT

DESIGN
HOARE LEA
MECHANICAL SERVICES ENGINEERS
www.hoarelea.com

PROJECT
CABOT HOUSE
DEANARY ROAD
BRISTOL

OFFICE A
LEVEL 1, FLOOR VDU
MECHANICAL SERVICES LAYOUT
DRG No BC0022/0A/M201 RD
DRAWN: MFC DATE: MAY 2009
SCALE: 1:50 (AS SHOWN) JWB
AUTOCAD RELEASE 2009

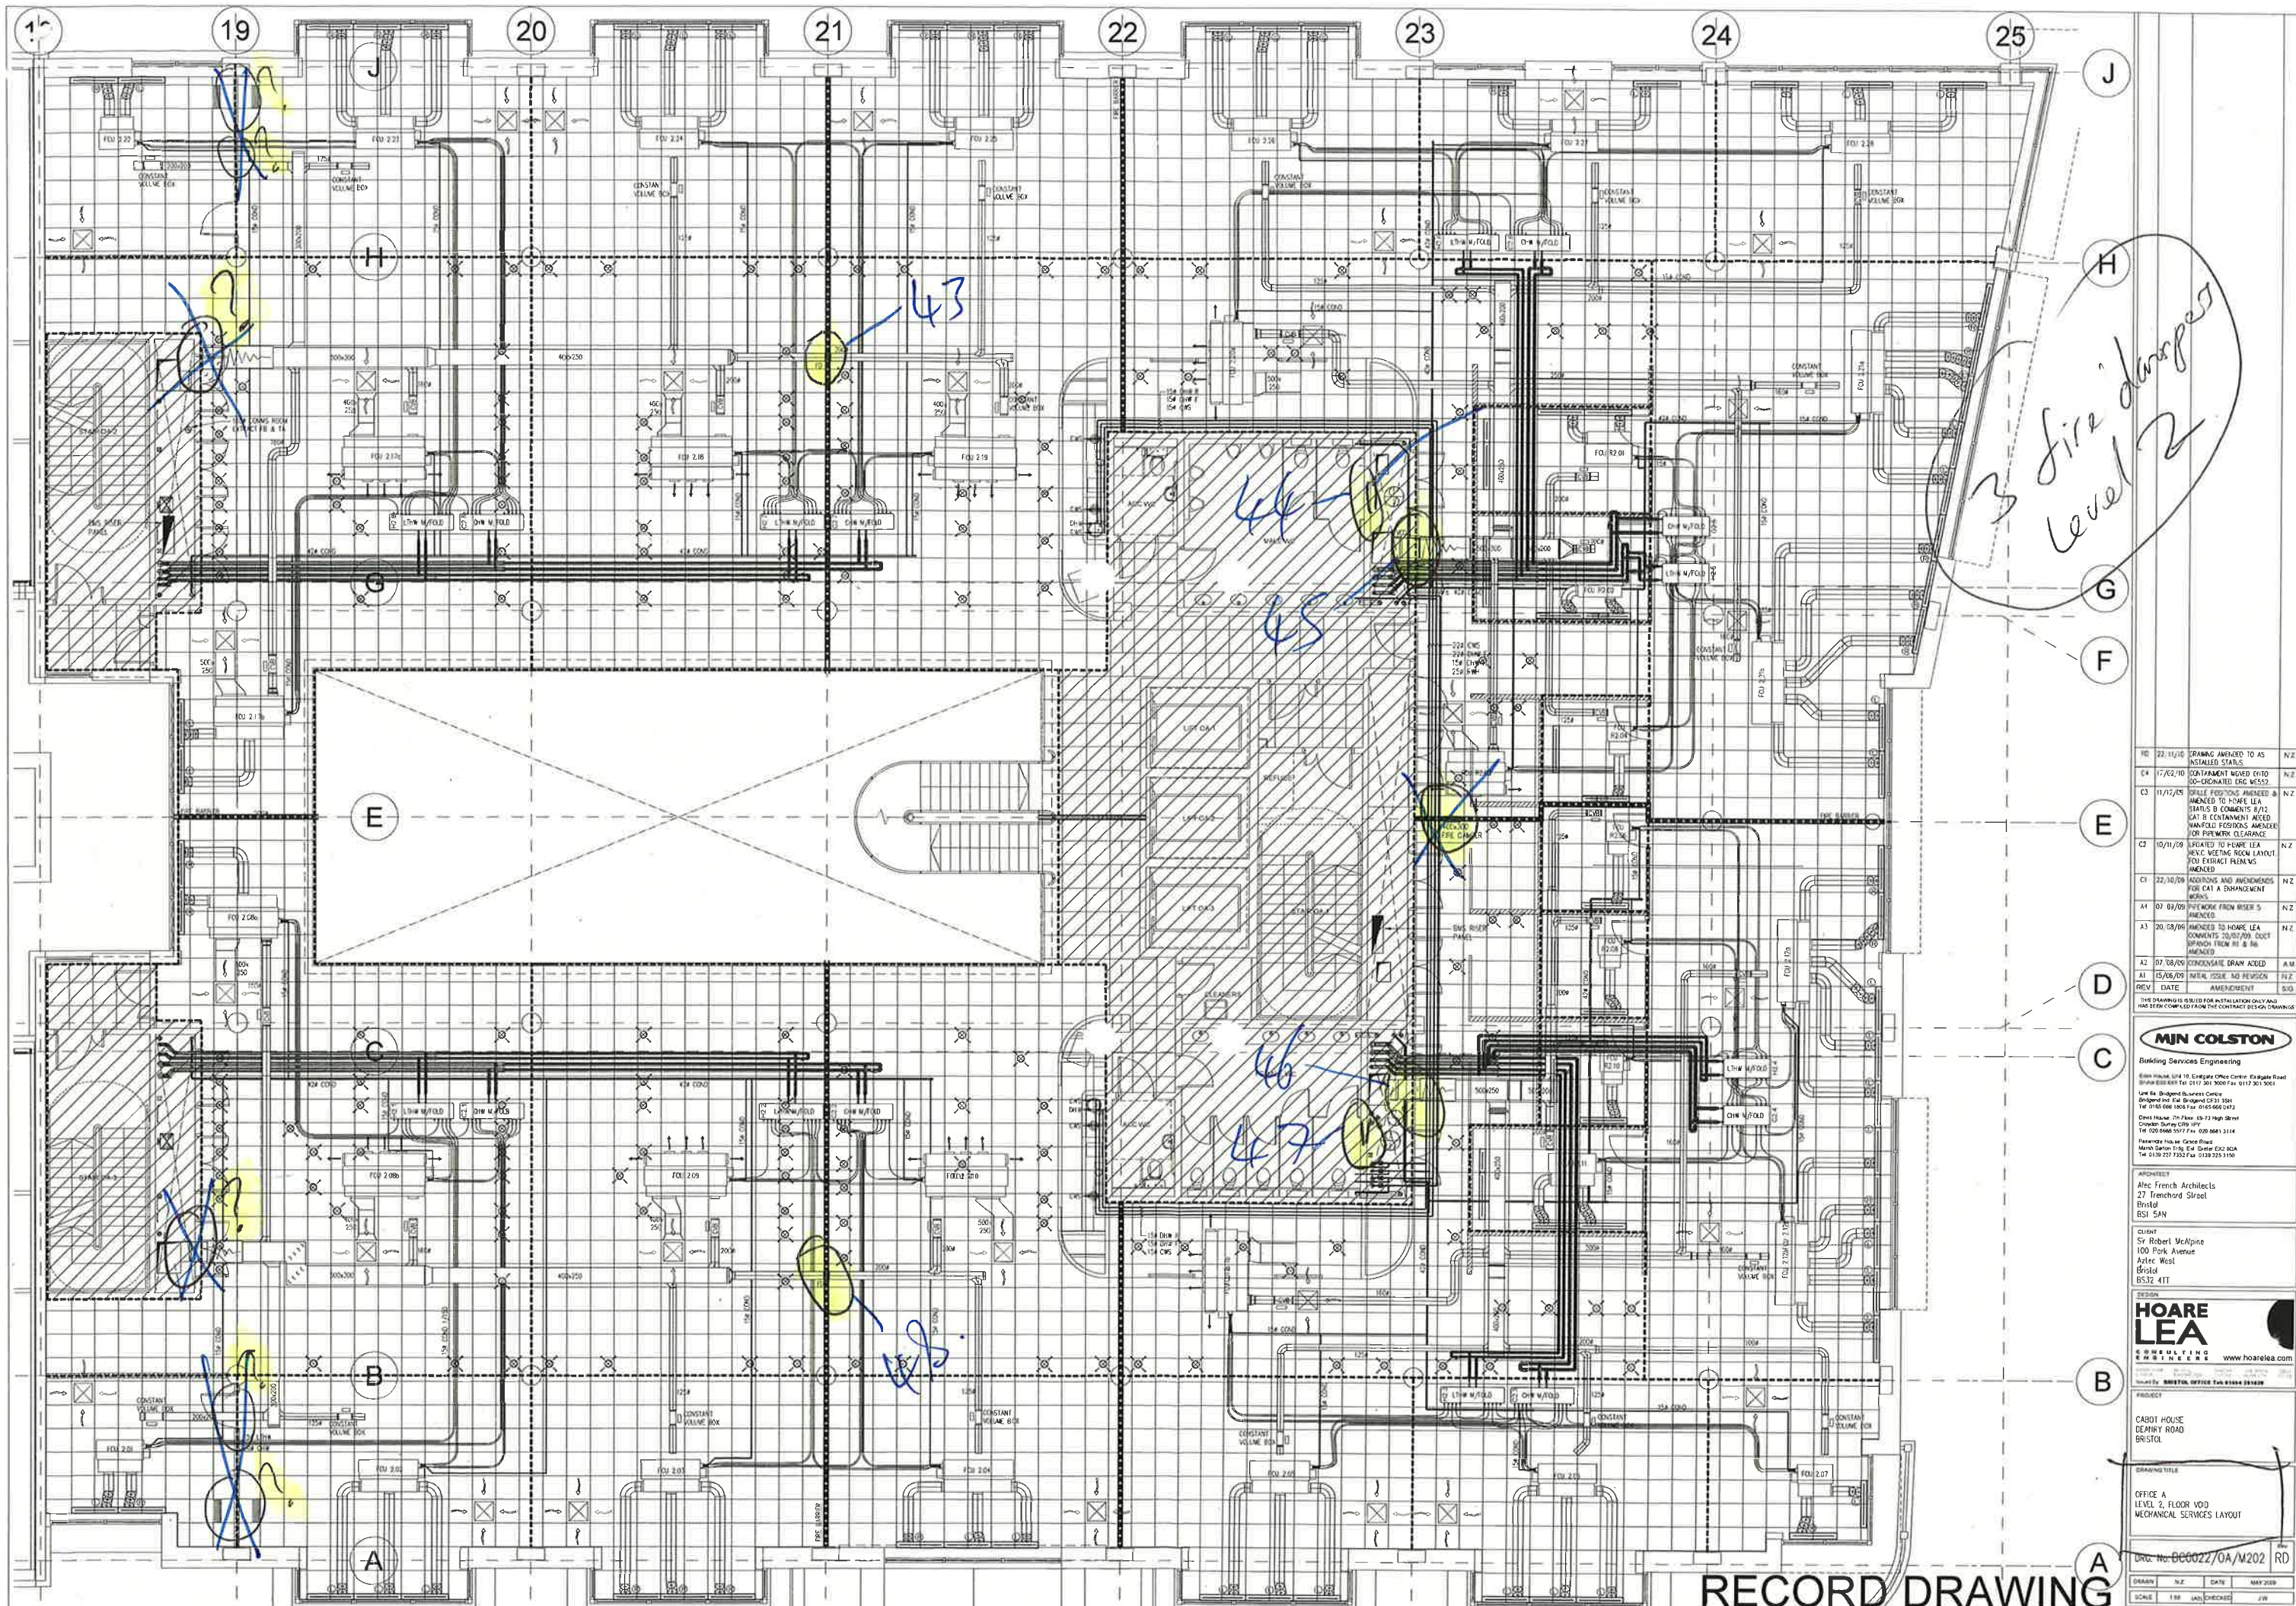

RECORD DRAWING

22/11/10	DRAWING AMENDED TO AS INSTALLED STATUS	N.Z.
17/02/10	CONTAINMENT MOVED OUT TO 100-DIGITIZED DRG W/500	N.Z.
11/12/05	SHALL BE POSITION AMENDED TO AMENDED TO HAVE LEA STARTS & COMMENTS 6/12 CAT 15 ESTIMATED ACCO. HANDFOLD FIBROUS AMENDED FOR FUTURE CLEARANCE	N.Z.
10/11/09	UPGRADED TO HAVE LEA MEV. MEETING ROOM LAYOUT FOR EXTRACT FLEXIBLES AMENDED	N.Z.
22/10/09	ADDITIONS AND AMENDMENTS FOR CAT 15 ENHANCEMENT WORKS	N.Z.
07/03/09	UPGRADE FROM RISER 5 AMENDED	N.Z.
20/08/06	AMENDED TO HAVE LEA COMMENTS 20/07/06. DUCT BRANCH FROM R1 & R6 AMENDED	N.Z.
07/08/09	CONDENSATE DRAIN ADDED	N.W.
15/06/09	INITIAL ISSUE. NO REVISION	N.Z.
REV	DATE	AMENDMENT

MJN COLSTON
Building Services Engineering
1000 HAWK, UNIT 10, Enbridge Office Centre, Enbridge Road
Bristol BS1 5AN
Tel: 0117 361 3000 Fax: 0117 361 3001
Email: mjncolston@bt.com
Our 24-hour Emergency Services Contact
Tel: 0117 361 3000 Fax: 0117 361 3001
Our 24-hour Emergency Services Contact
Tel: 0117 361 3000 Fax: 0117 361 3001
Our 24-hour Emergency Services Contact
Tel: 0117 361 3000 Fax: 0117 361 3001

ARCHITECT
Alec French Architects
27 Trenchard Street
Bristol
BS1 5AN
CLIENT
Sir Robert McAlpine
100 Park Avenue
Aston West
Bristol
BS32 4TT


DESIGN
HOARE LEA
100 Park Avenue
Aston West
Bristol
BS32 4TT
www.hoarelea.com

PROJECT
CABOT HOUSE
DEANARY ROAD
BRISTOL

DRAWING TITLE
OFFICE 2, FLOOR VOD
MECHANICAL SERVICES LAYOUT

DRG. NO. 060022/0A/M202 RD

DRAWN	N.Z.	DATE	MAY 2009
SCALE	1:50	CHECKED	J.W.
AUTOCAD RELEASE 2008			

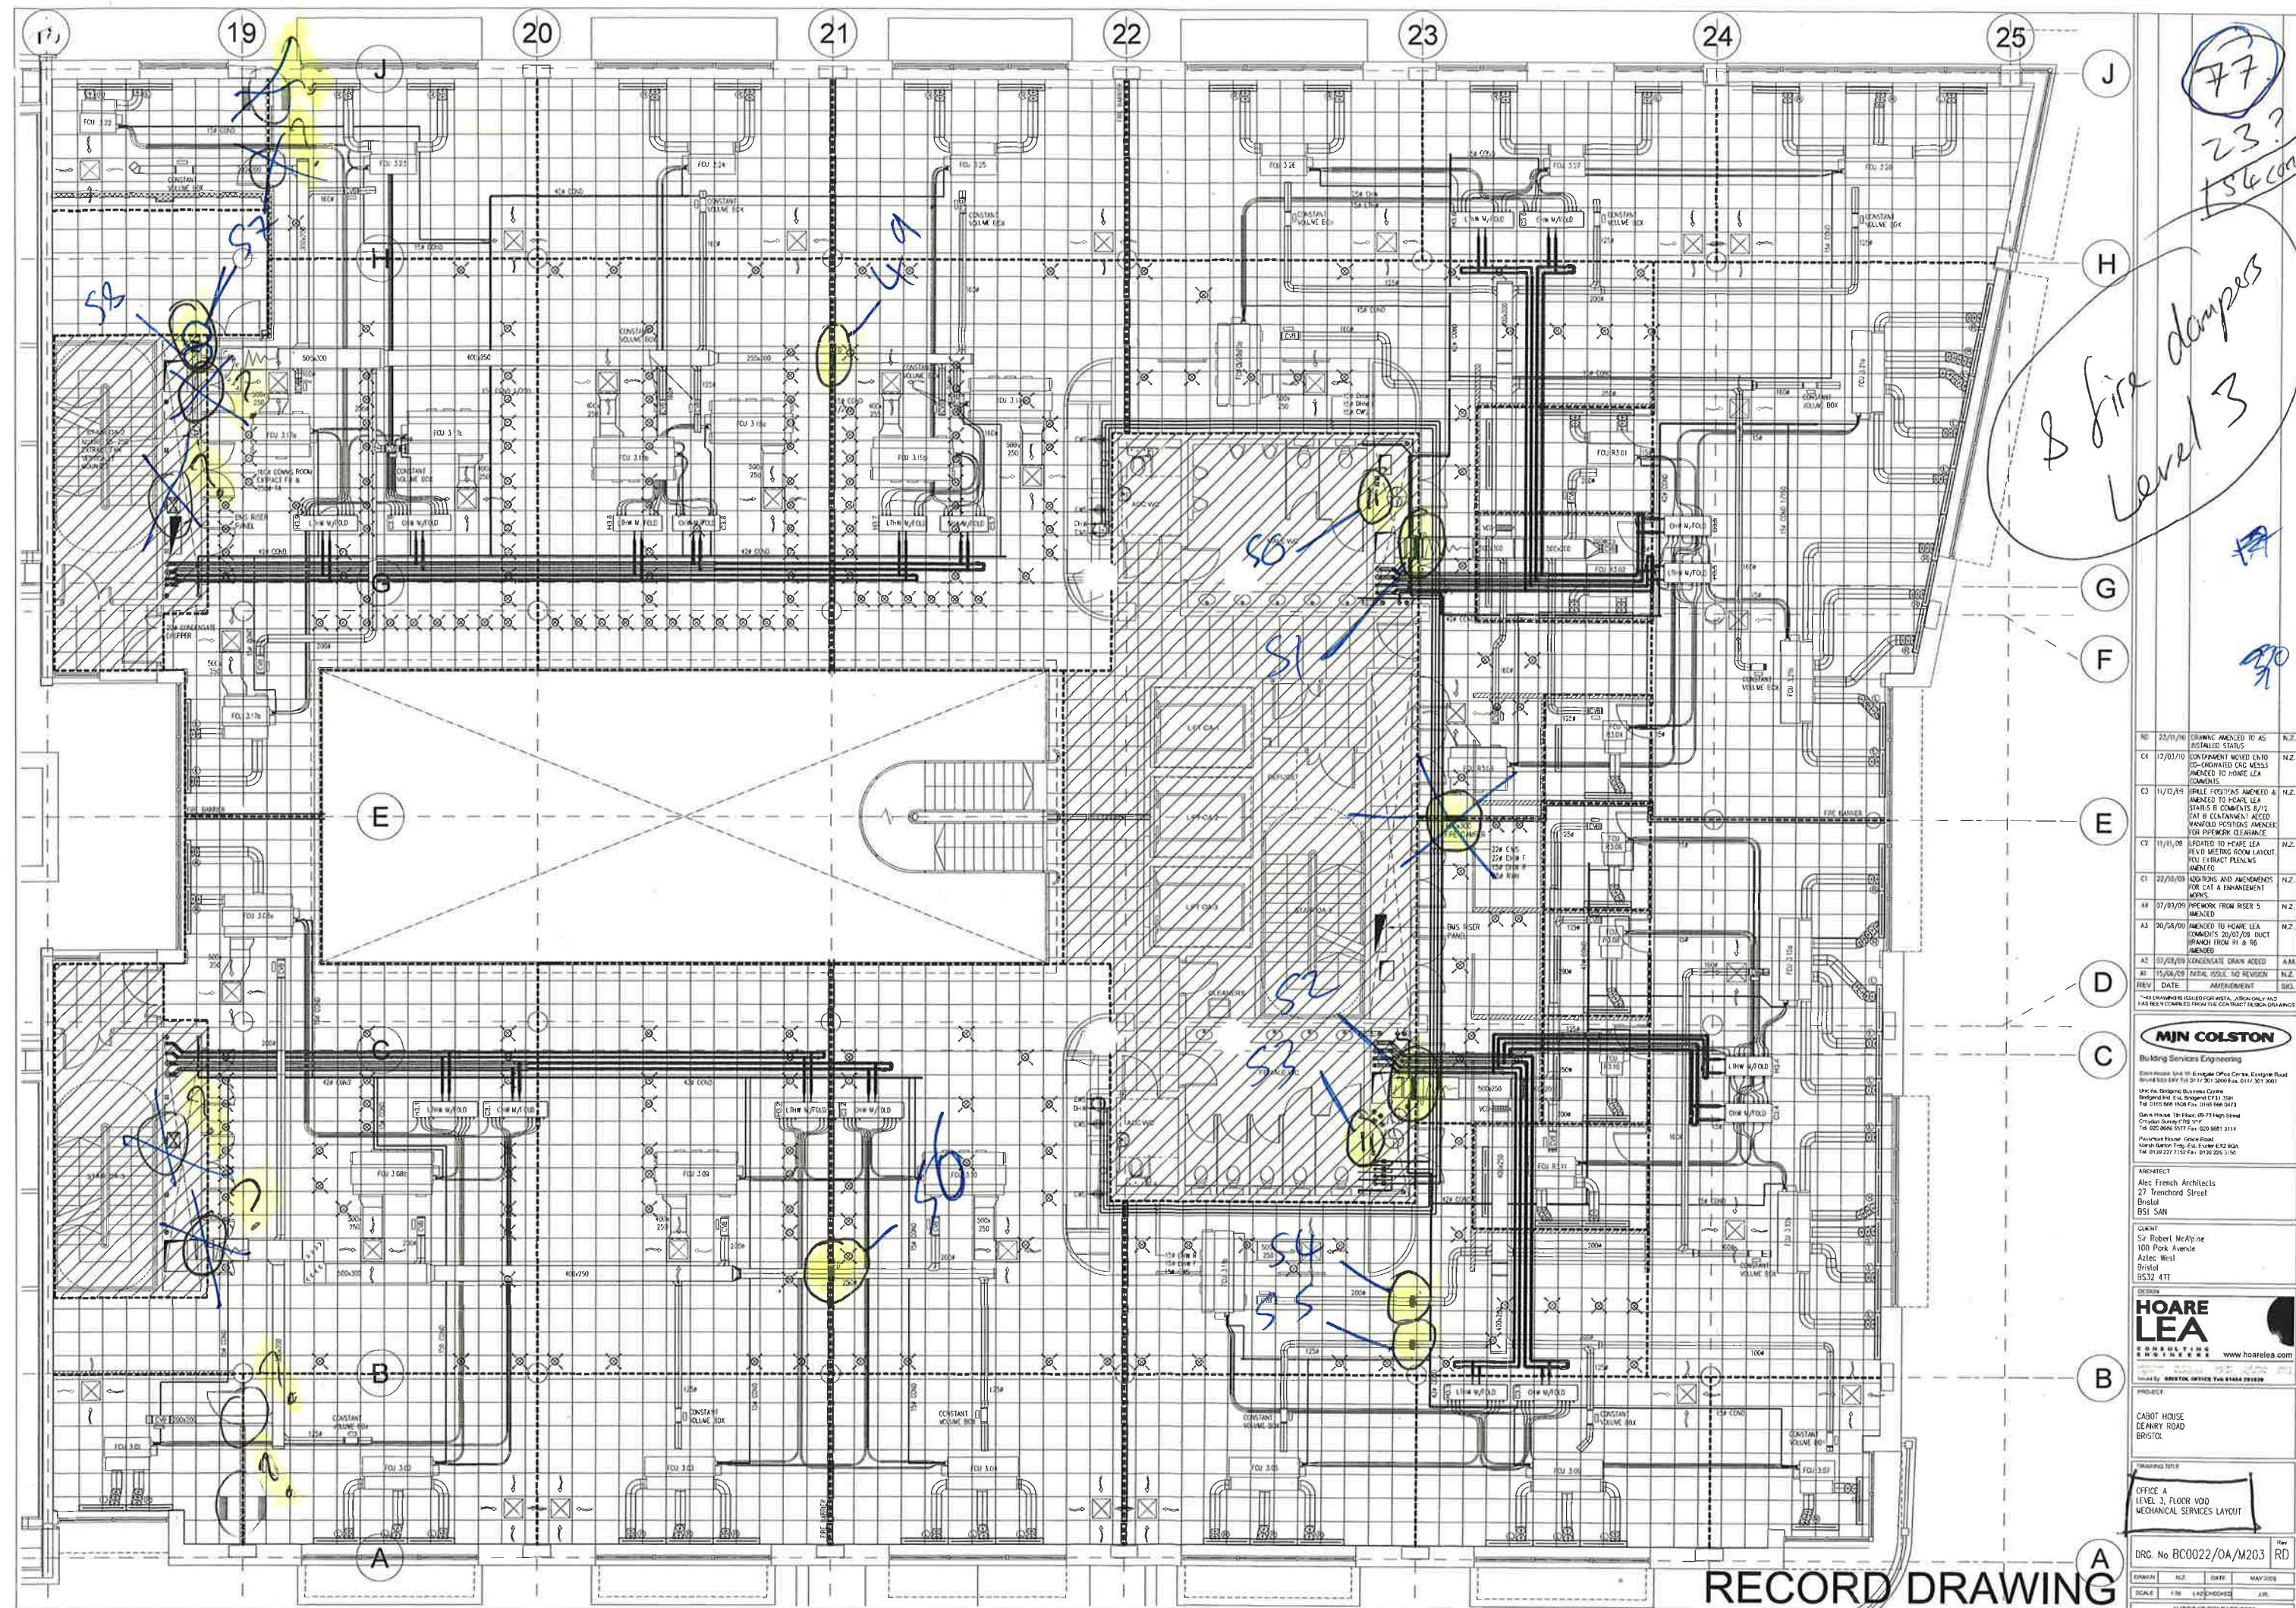

77
23?
1st 6 continue

8 fire dampers
Level 3

NO	22/11/10	DRAWING AMENDED TO AS	N.Z.
C1	12/03/10	CONTAINMENT WORK INTO	N.Z.
		CO-ORDINATED FAS MESS	
		AMENDED TO HOME LEA	
		CAMENTS	
C3	11/12/09	BRILL FIGHTERS AMENDED &	N.Z.
		AMENDED TO HOME LEA	
		STAIRS & COMMENTS 6/12	
		CAT B CONTAINMENT ACCED	
		MANFOLD POSITIONS AMENDED	
		FOR POSITIVE CLEARANCE	
C2	11/11/09	UPDATED TO HOME LEA	N.Z.
		REV'D MEETING ROOM LAYOUT	
		REV'D EXTRACT PRELIMS	
		AMENDED	
C1	22/10/09	ADDITIONS AND AMENDMENTS	N.Z.
		FOR CAT A ENHANCEMENT	
		WORKS	
A4	07/07/09	MEMORANDUM FROM RISER 5	N.Z.
		AMENDED	
A3	20/06/09	AMENDED TO HOME LEA	N.Z.
		COMMENTS 20/07/09 DUCT	
		BRANCH FROM R1 & R6	
		AMENDED	
A2	03/06/09	CONDENSATE DRAIN ADDED	N.Z.
		AMENDED	
A1	15/06/09	REVAL ISSUE, NO REVISION	N.Z.
REV	DATE	AMENDMENT	SHD.
*ALL DRAWINGS ISSUED FOR INST. ACTION ONLY AND			
HAS BEEN COMPILED FROM THE CONTRACT DESIGN DRAWINGS			

MIN COLSTON

Building Services Engineering

22/11/10

22/11/10

