

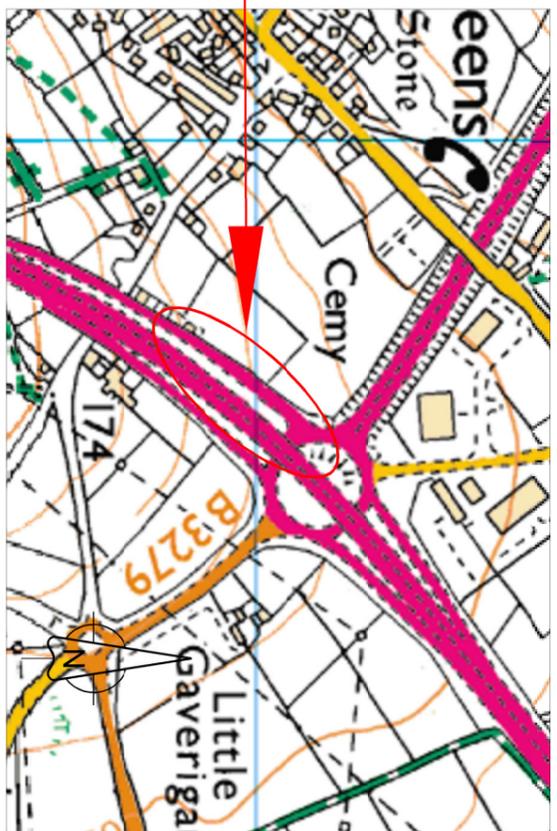


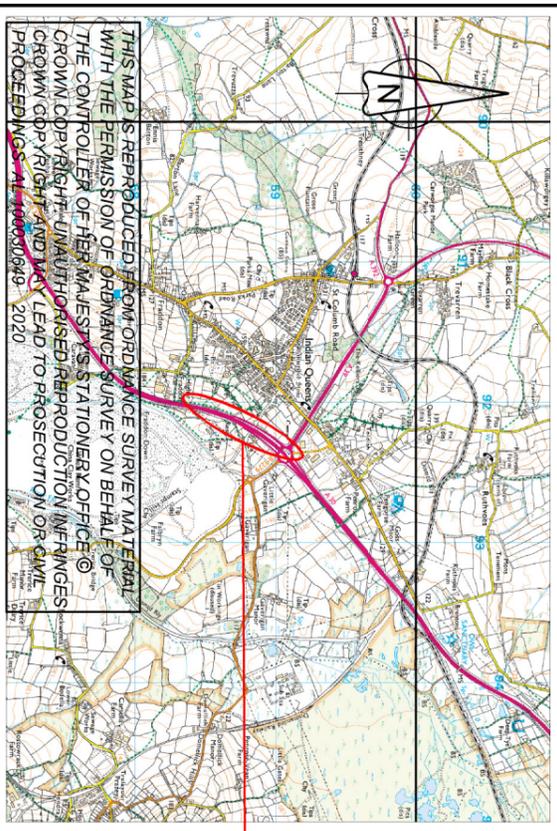

Chainage 0 to be taken at the start of the buff High Friction Surfacing

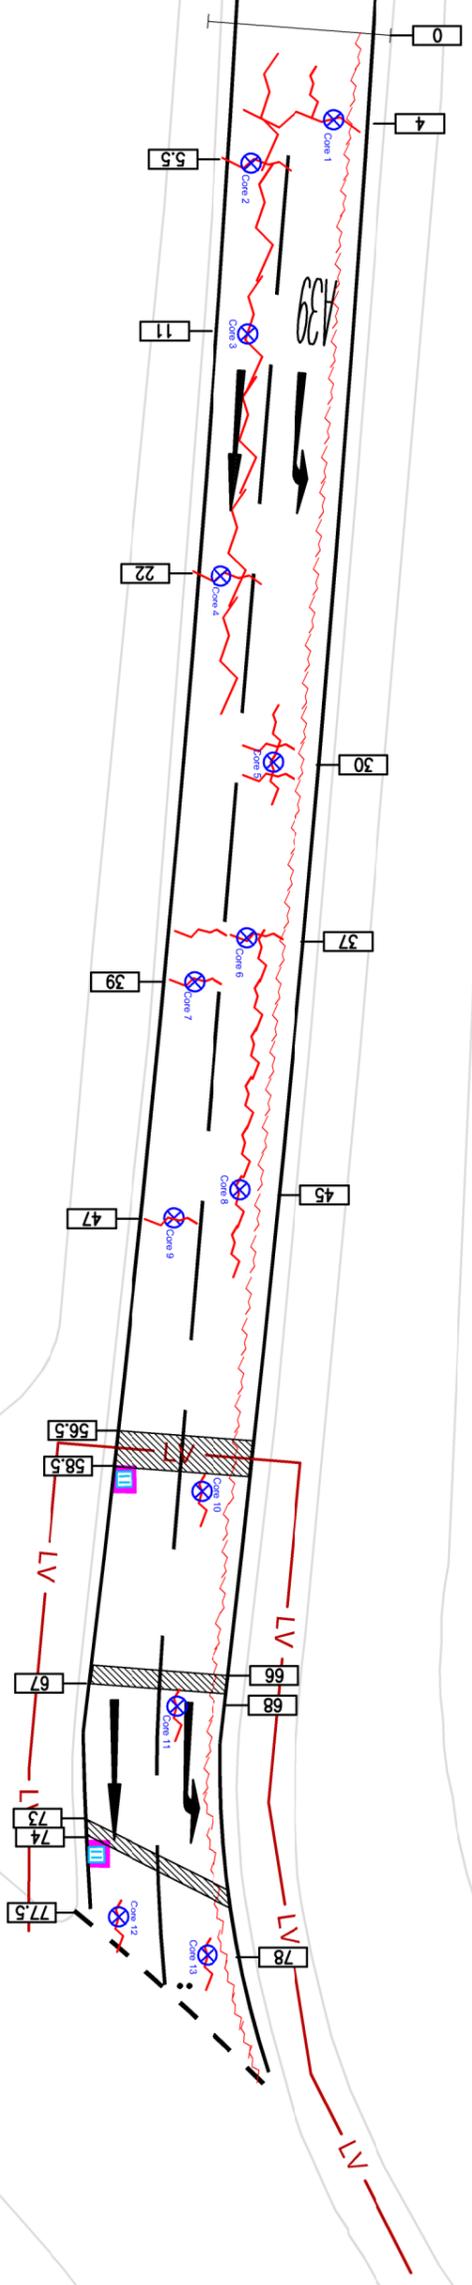

KEY

	Slight		HE Section Nodes		Depression around gully
	Medium		Core Sample Location		Surface Change
	Wide		Underground low voltage power		Patch
	Transverse crack		Gully		Chainage
	Open Joint				

CLIENT

SCHEME NAME

A30 Fraddon to Goss Moor EB & WB

DRAWING TITLE

Highgate Hill EB Off-slip
Core Sampling Location Plan

DRAWN : MC

DESIGN : MC

CHKD : CT

APPD : CT

DATE : 16/03/2020

SUITABILITY : S2

REV	DETAILS	CHKD	APPD	DATE
1	Ch 0 location note added	CT	CT	28/04/2020

AGENT

DRAWING STATUS

NOT TO SCALE

DIMENSIONS : AS STATED

ORIG DWG SIZE: A3

COPYRIGHT © KIER

AS-BUILT

DRAWING NUMBER

PROJECT HE - 601961

ORIGINATOR KIER

VOLUME VPS

LOCATION A30_S463_SL_B

TYPE DE

ROLE CH

NUMBER 0700 - 01

SCHEME REFERENCE No. 601961

REVISION C 2