



MAINS DISTRIBUTION

Legend

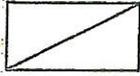


Distribution Board

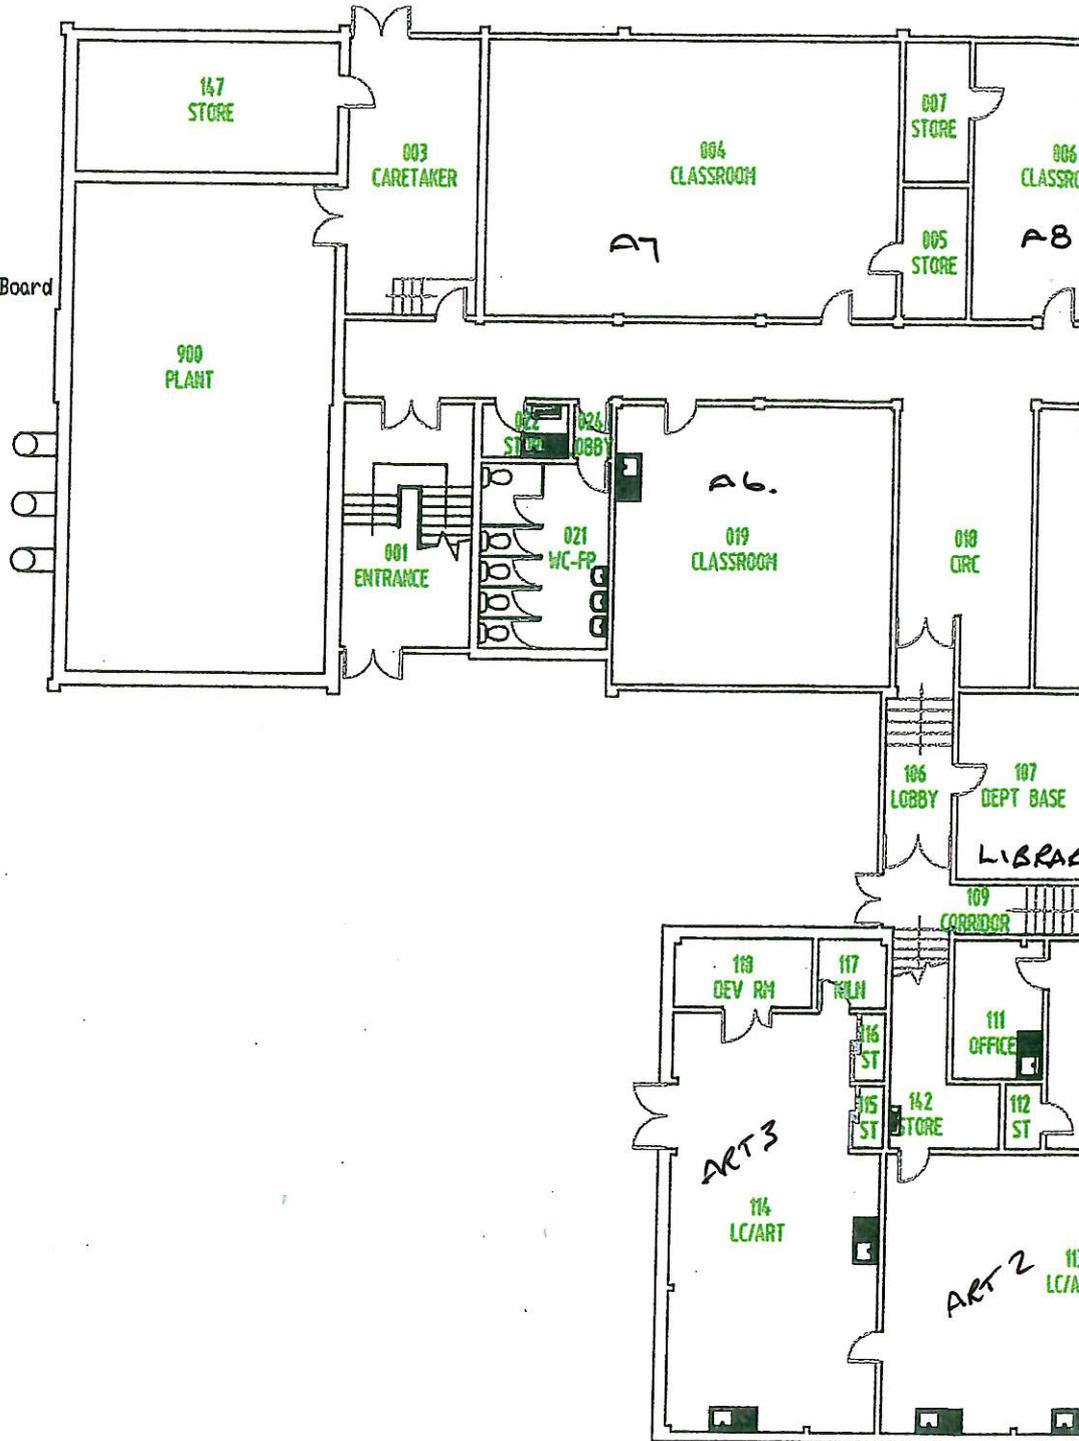


Prop

AS INSTALLED

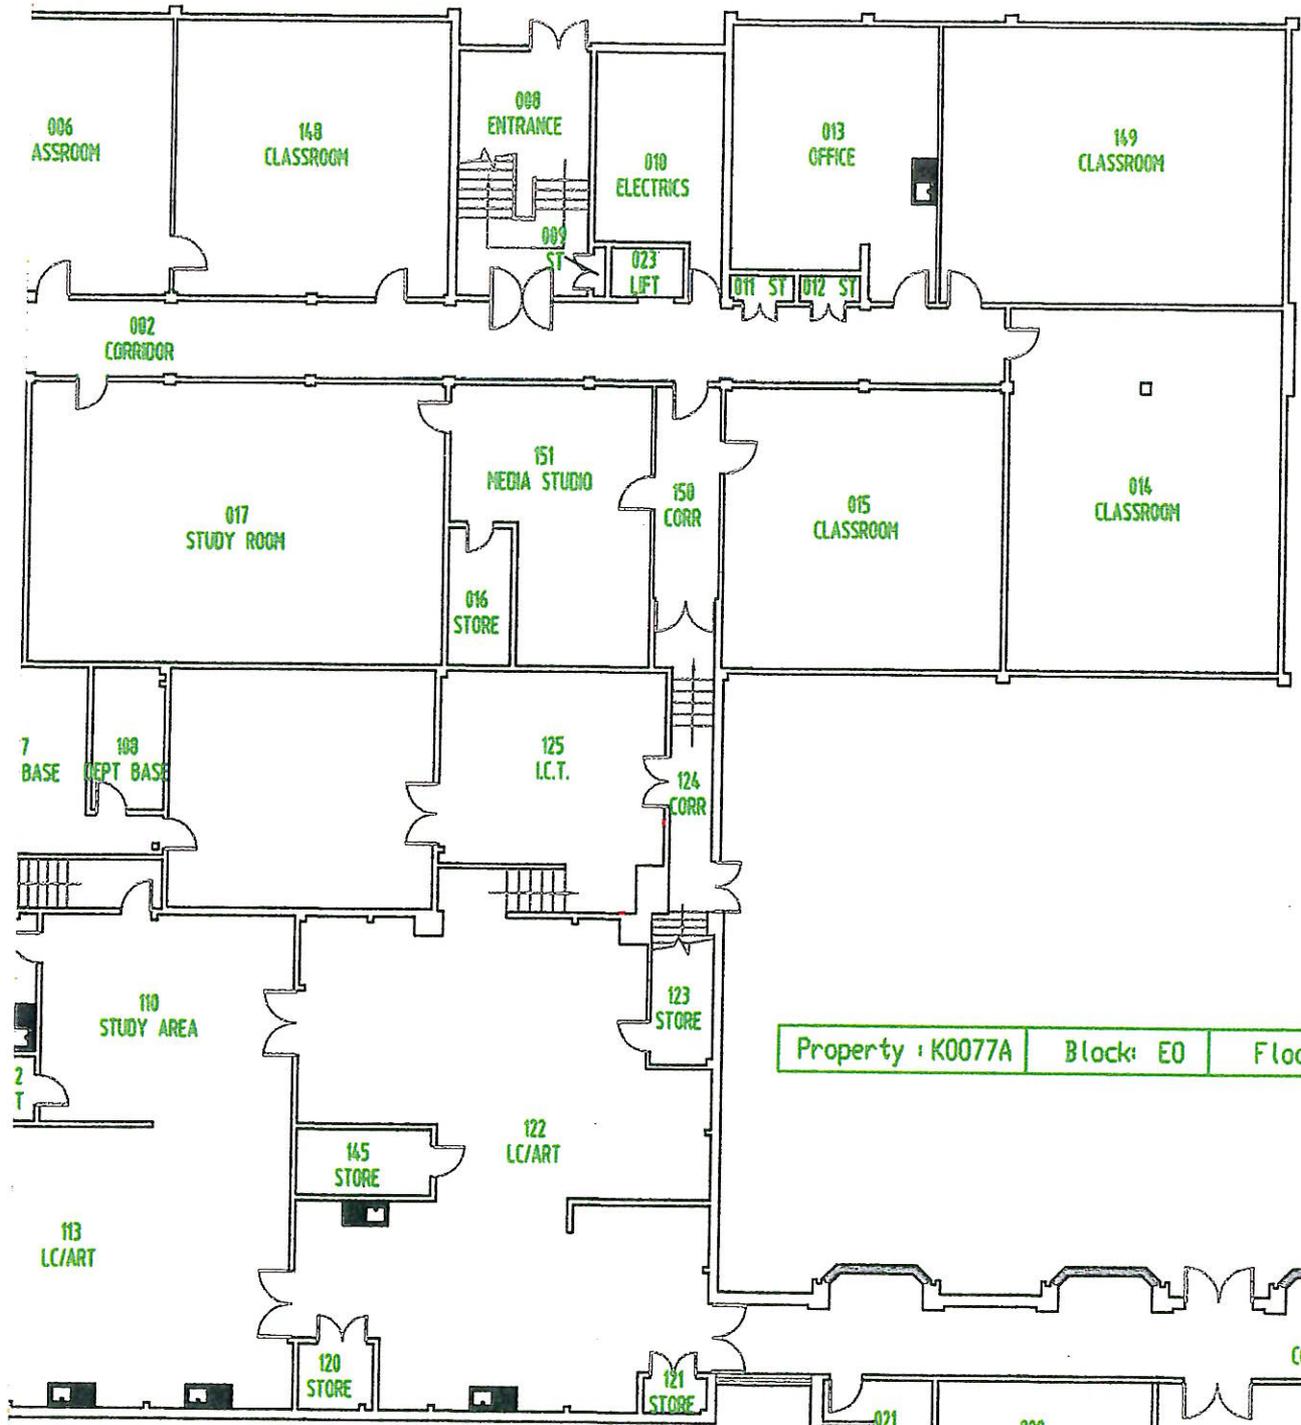

Property : K0077A | Block: EO | Floor: GROUND


Property : K0077A | Block: AO | Floor: LVR GROUND

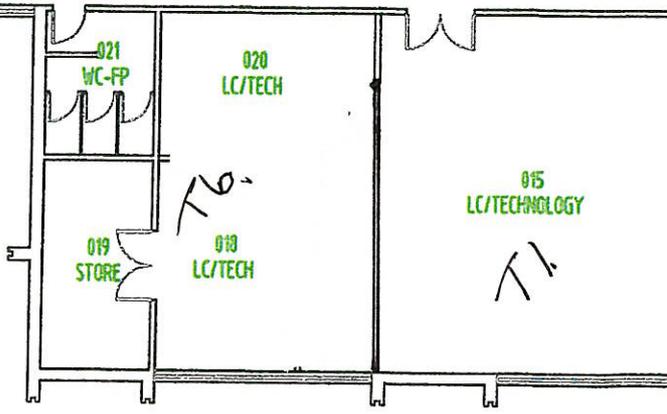


AS INSTALLED

MAINS DISTRIBUTION


Legend

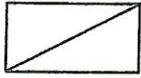

Distribution Board

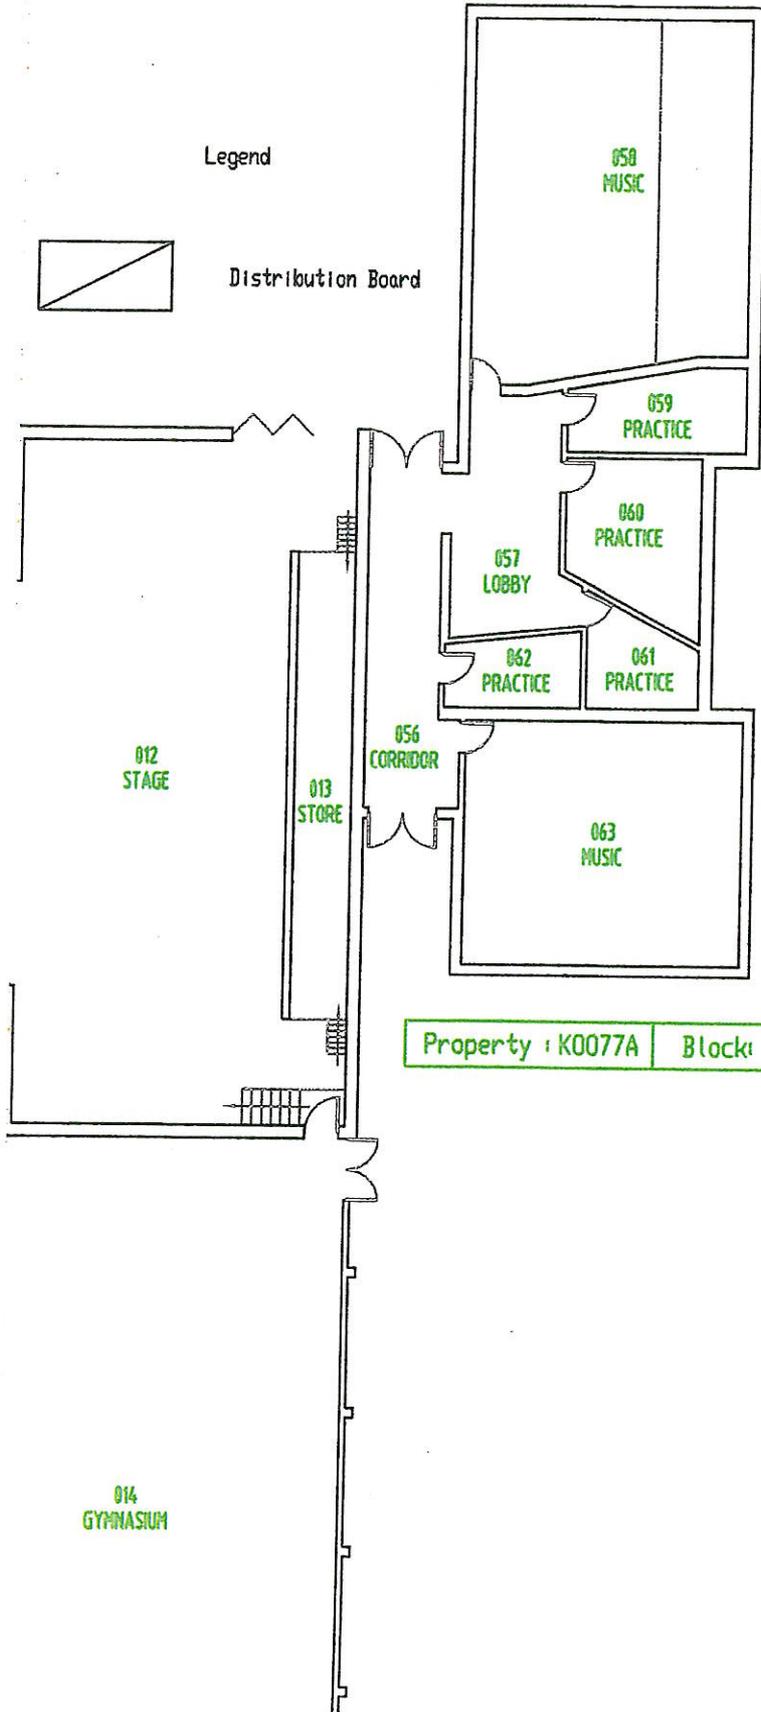

Property : K0077A | Block: D0 | Floor:

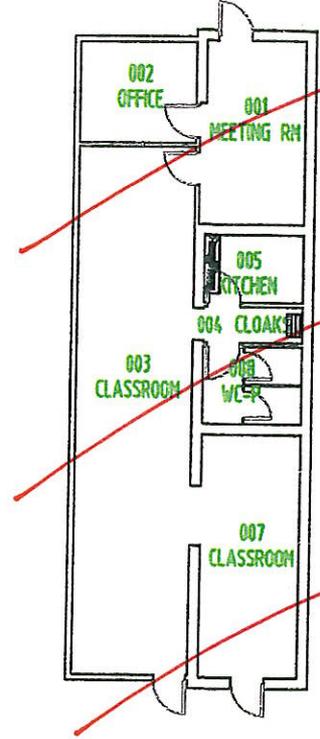

Property : K0077A | Block: B0 | Floor: GROUND

Property : K0077A


Property : K0077A

AS INSTALLED


MAINS DISTRIBUTION



Legend

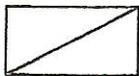


Distribution Board

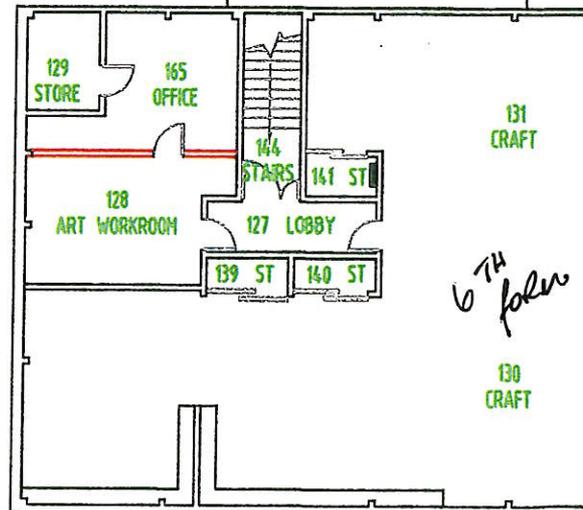


AS INSTALLED

MAINS DISTRIBUTION

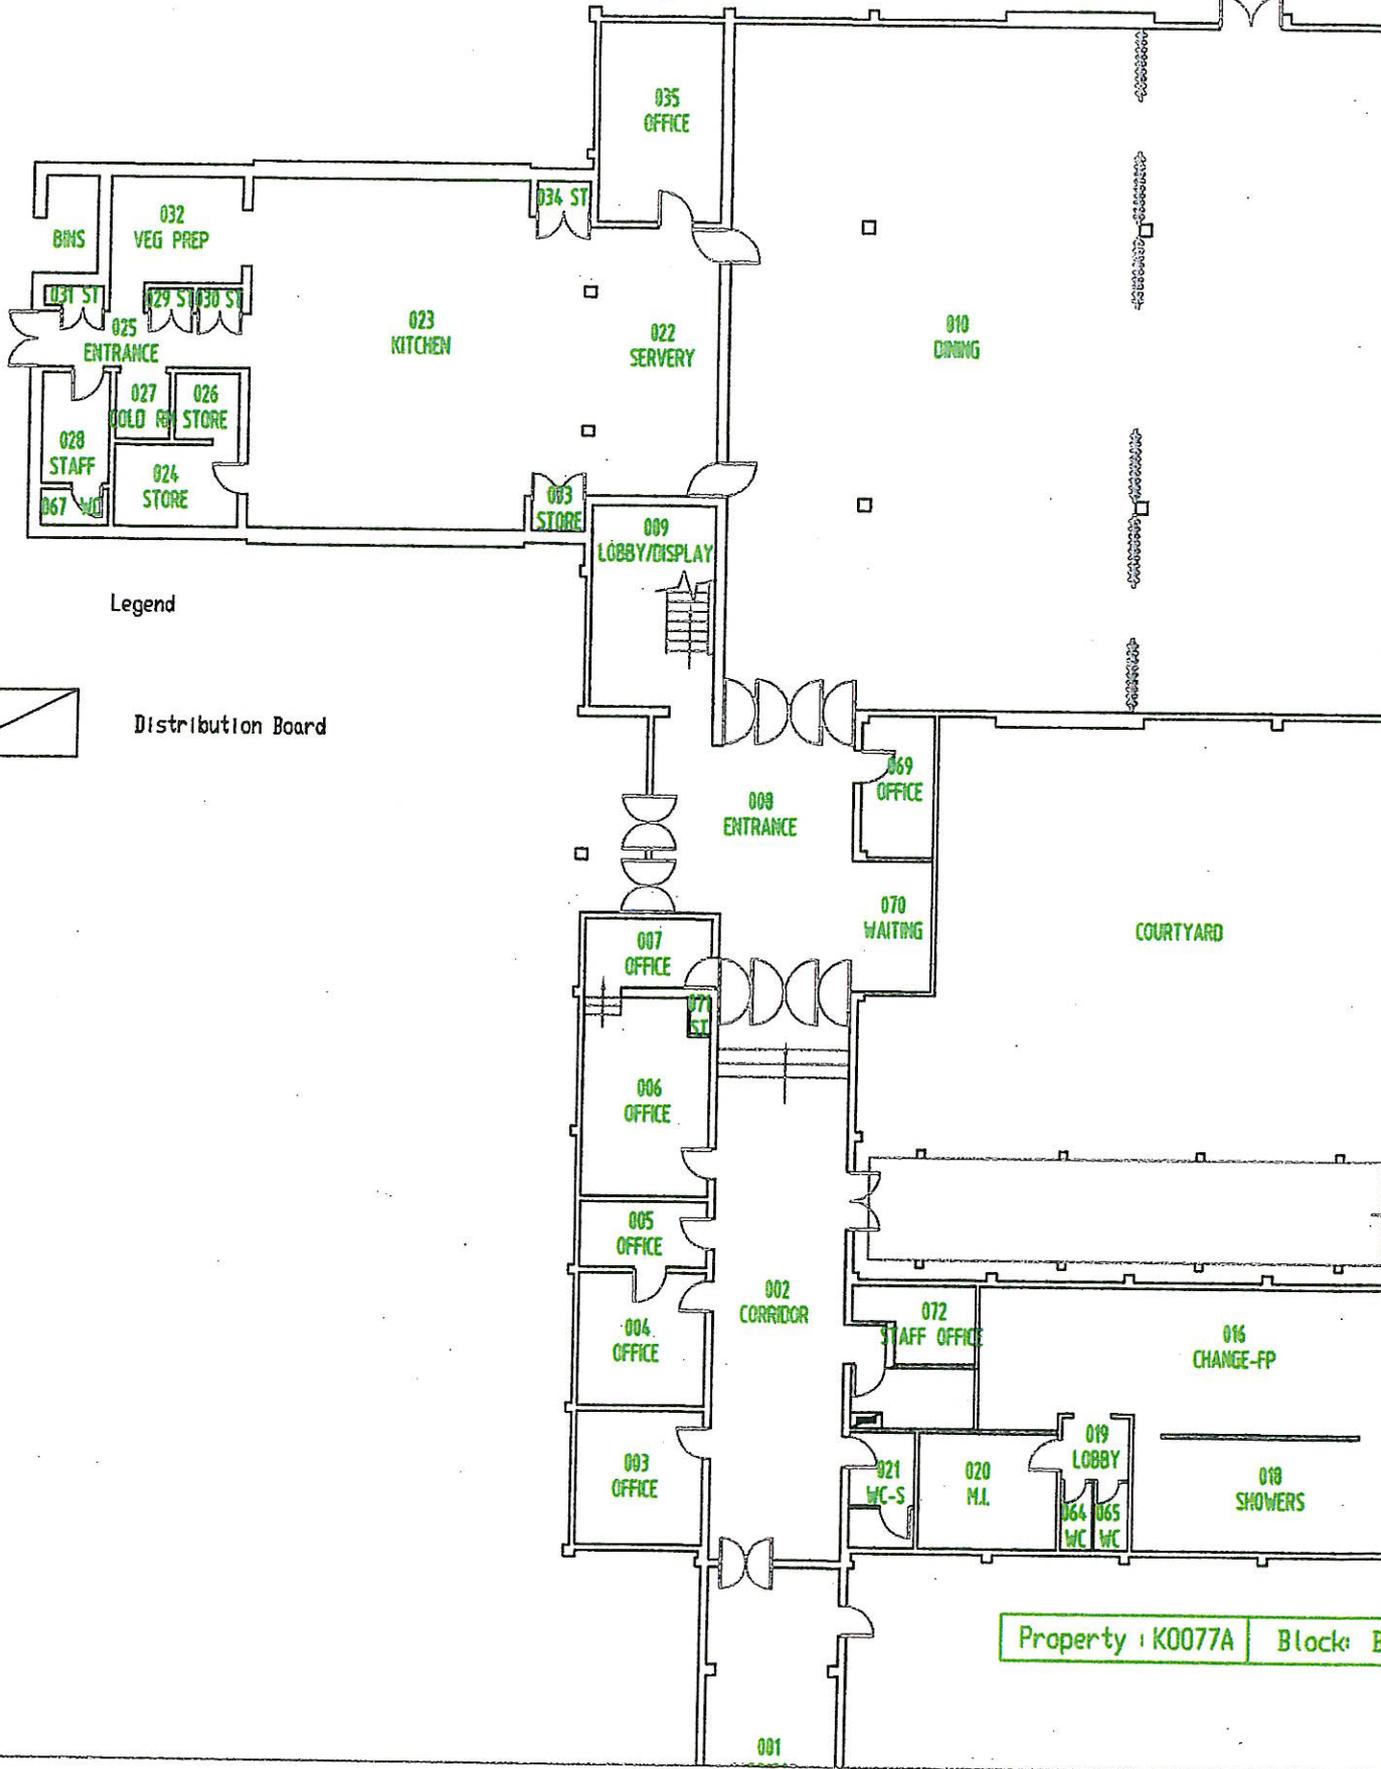

Legend

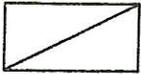


Distribution Board

Property: K0077A Block: B


AS INSTALLED

MAINS DISTRIBUTION


Legend

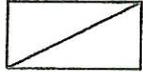

Distribution Board

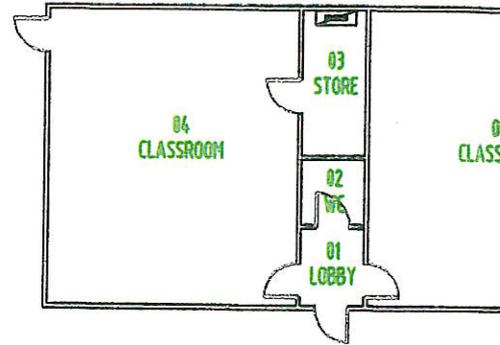

Property : K0077A | Block: M945 | FL

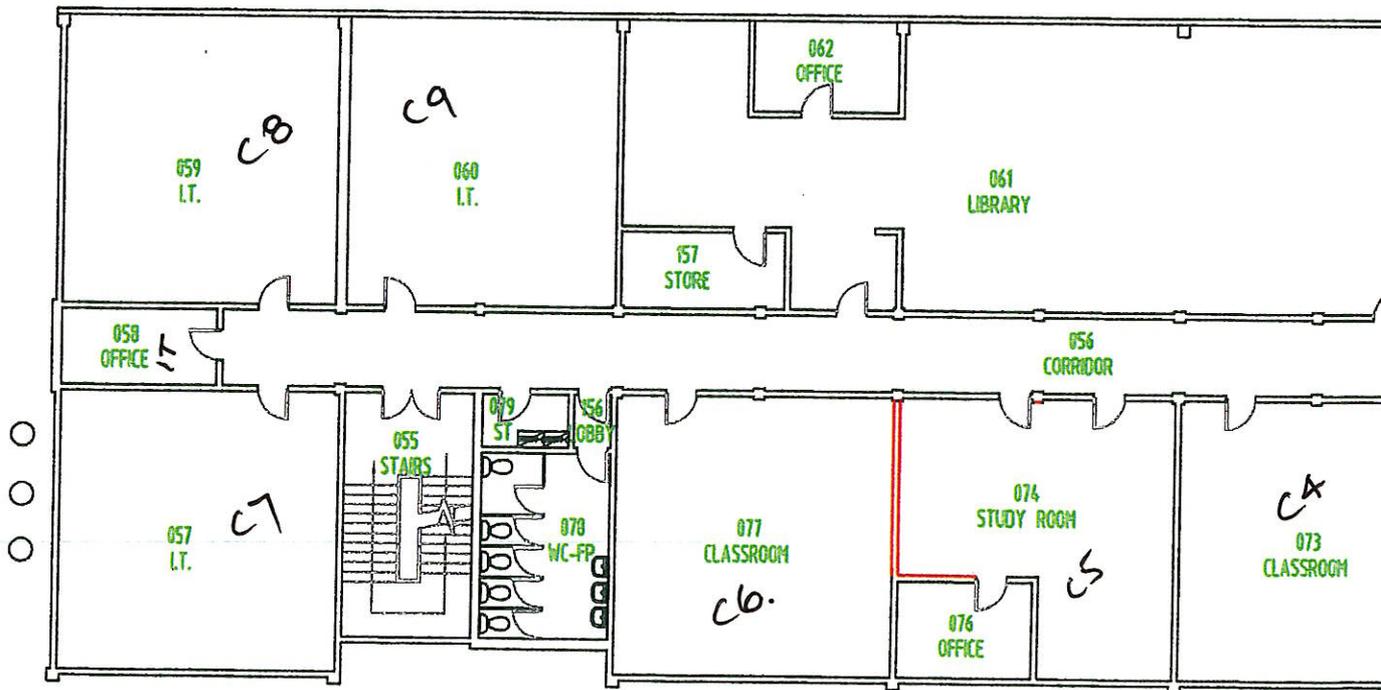



AS INSTALLED

MAINS DISTRIBUTION




AS INSTALLED

FIRE BREAKS

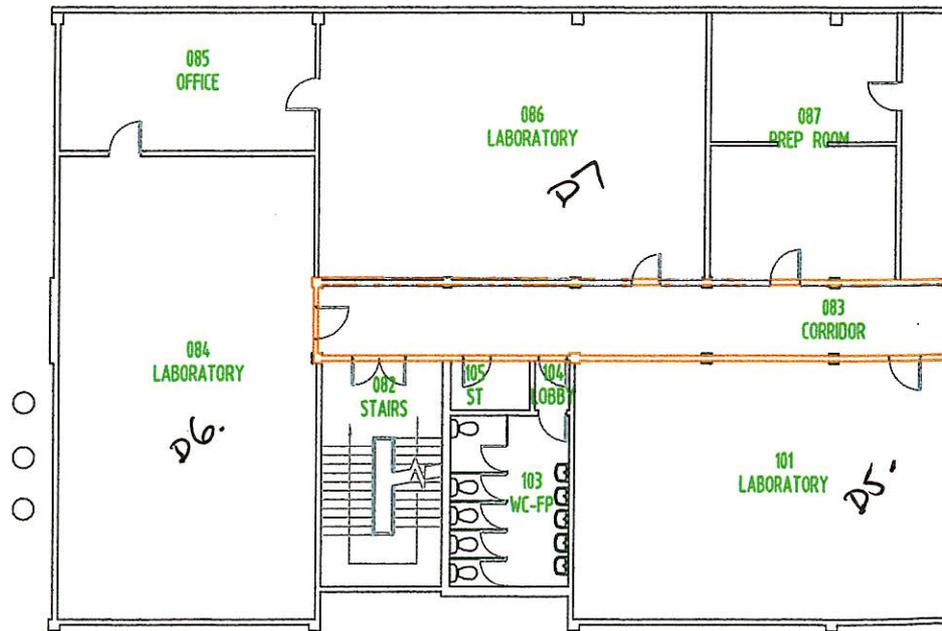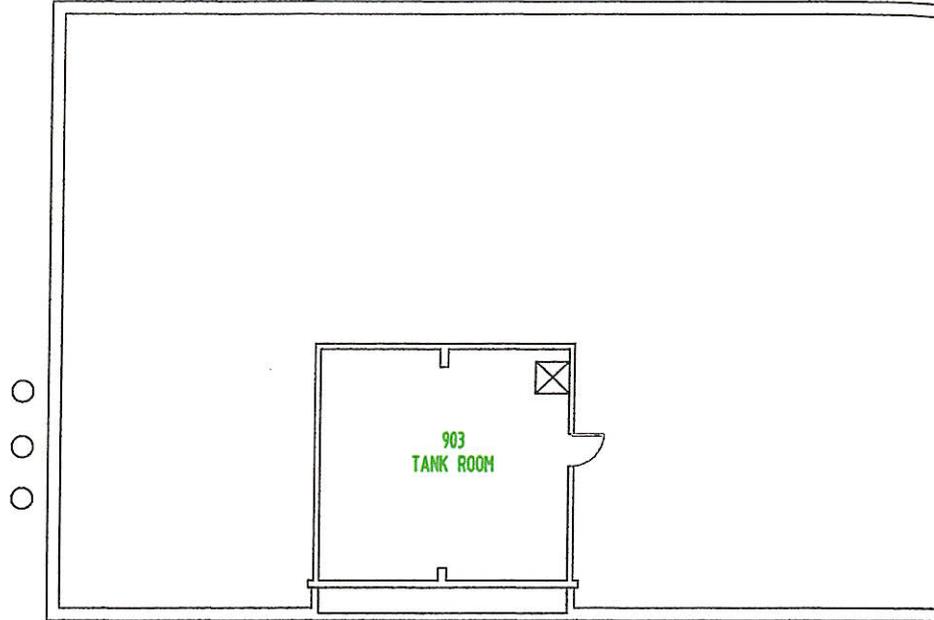

CONSTRUCTION

Property : K0077A Block: JO Floor: GROUND

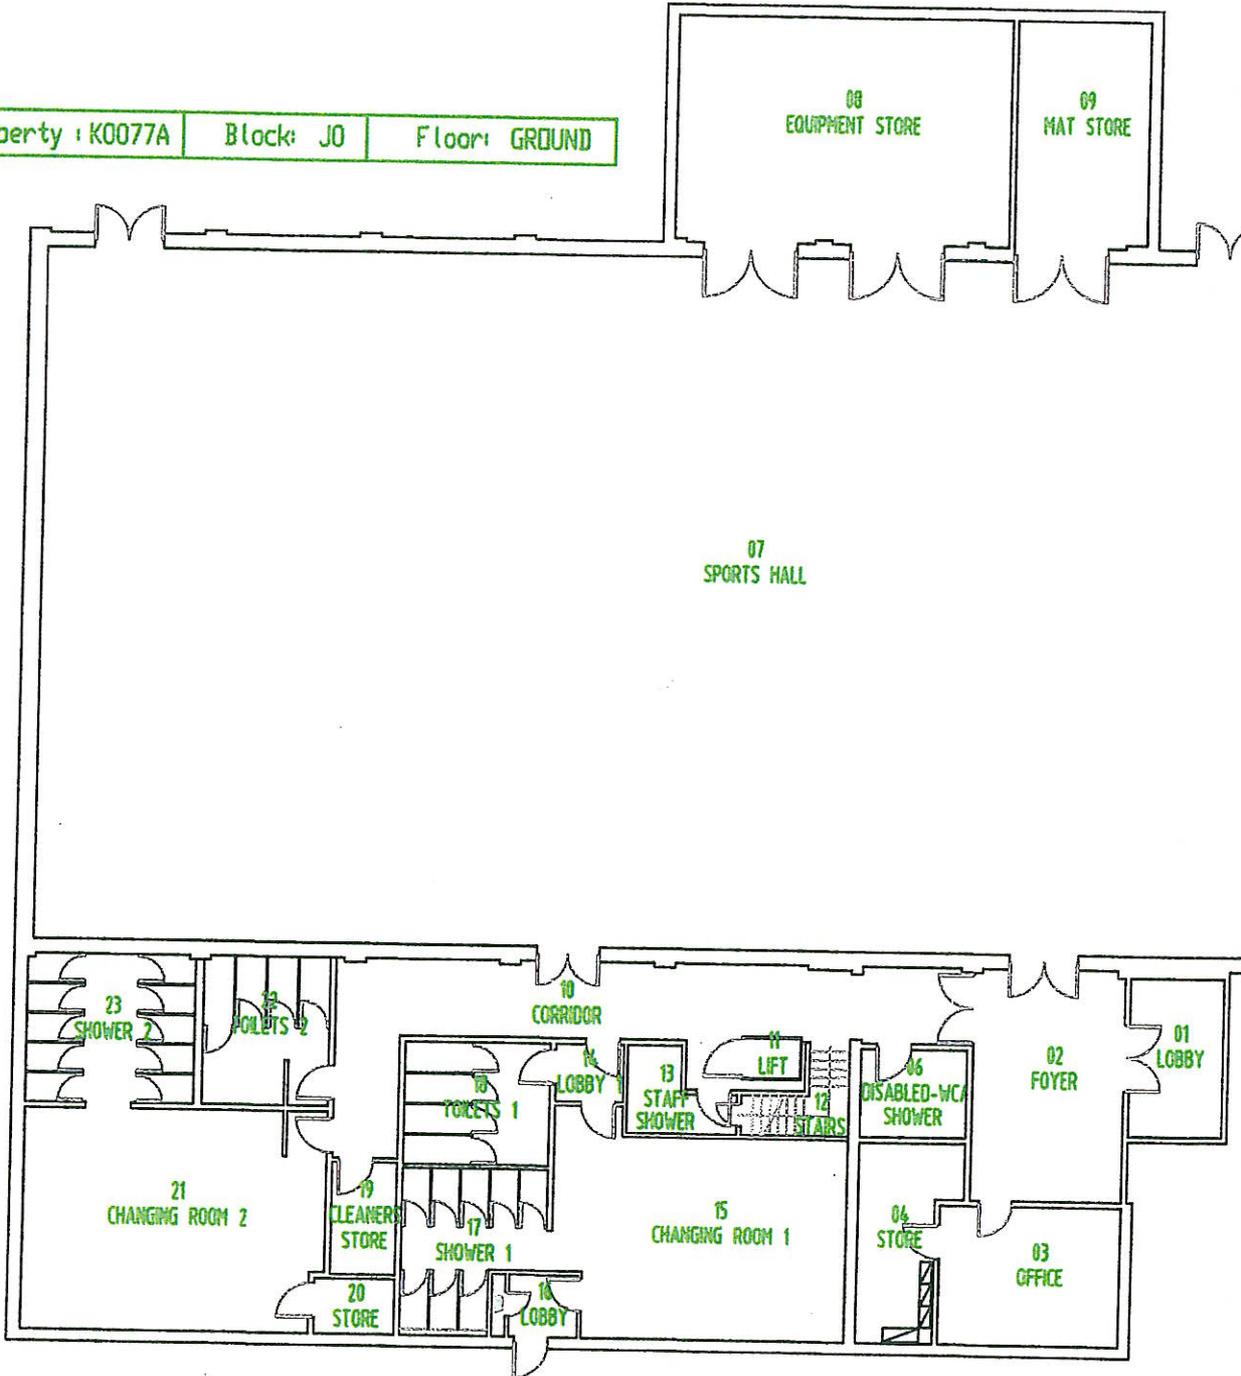

Property : K0077A Block: J1 Floor: GROUND

AS INSTALLED