


Ref. No.	Ditch Topsoil Level (m)	Invert Level (m)	Easting (m)	Northing (m)
D10	50.545	50.019	4967.479	7956.847
D11	50.535	49.852	4937.741	7972.291
D12	50.675	49.689	4925.474	7999.871
D13	51.365	49.949	4948.083	8066.274
D14	51.525	50.096	4965.746	8076.312
D15	51.445	50.241	4987.060	8072.256
D16	51.375	50.350	4997.044	8060.781
D17	51.205	50.548	4998.874	8031.147

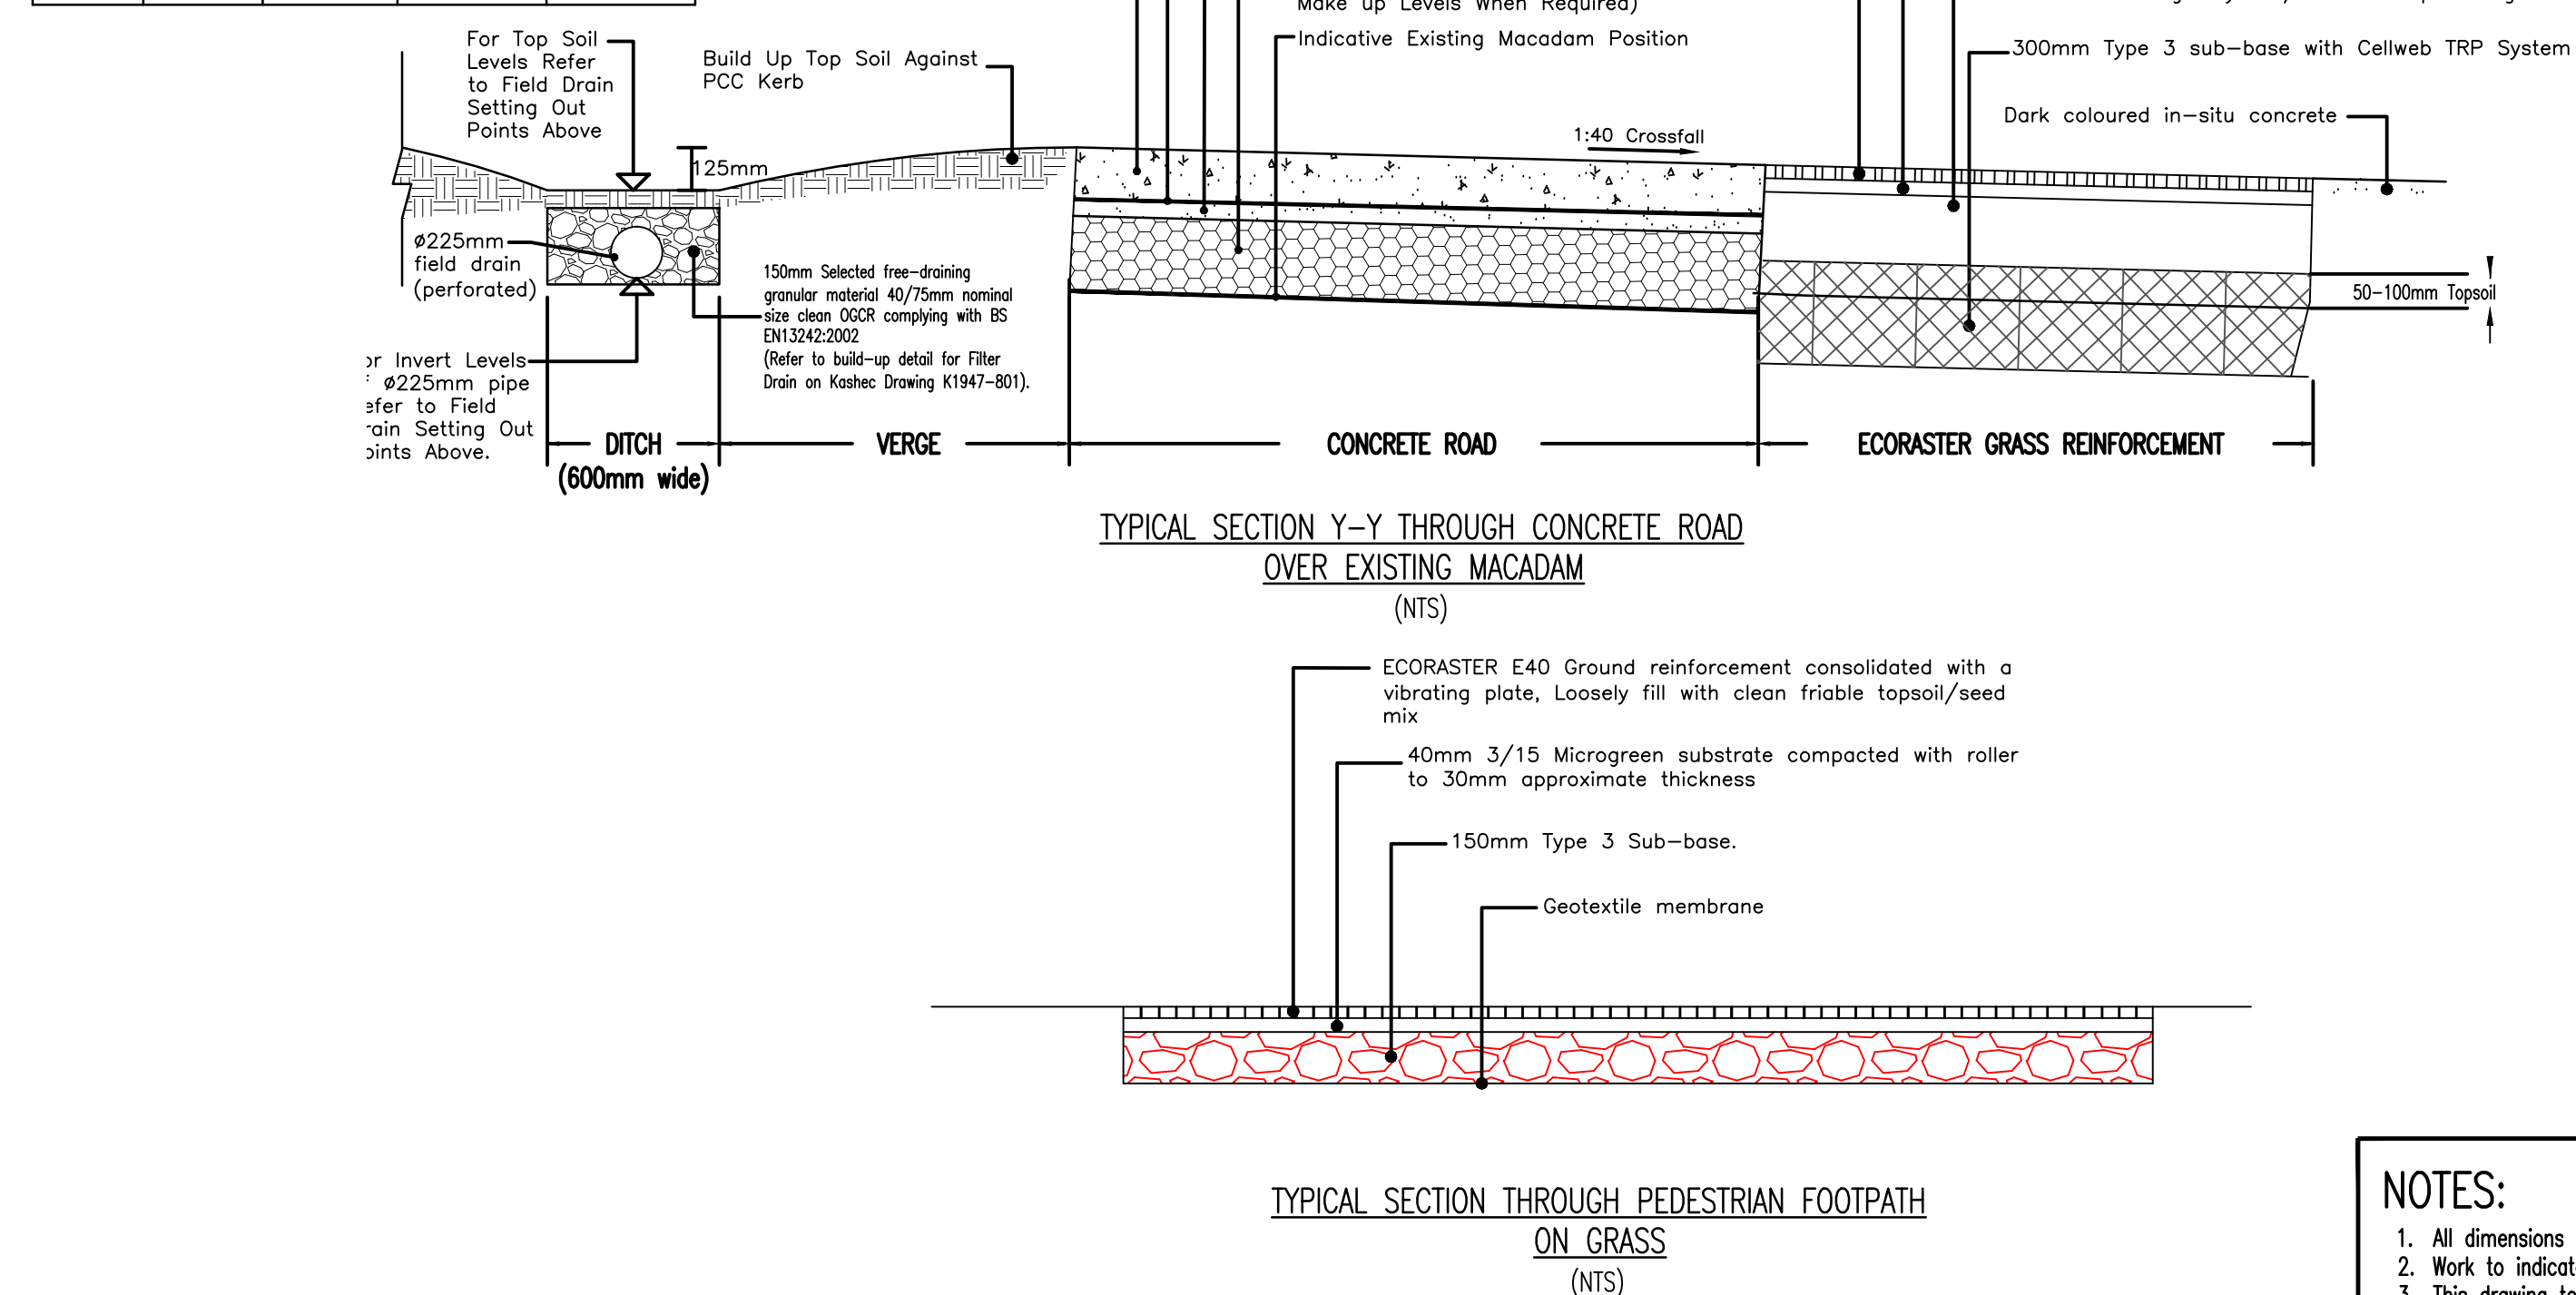

NOTE
Read in conjunction with drawings K1947-800 (Drainage Scheme Sheet 1) and K1947-801 (Drainage Scheme Sheet 2 - Sections).

NOTES:

- All dimensions are in millimetres (mm) & levels in metres (m) unless noted otherwise.
- Work to indicated dimensions only. Do not scale this drawing.
- This drawing is to be read in conjunction with all relevant Architects, Engineers and Specialists drawings and the specification.
- All work to comply with the relevant British Standards, Codes of Practice and the Building Regulations.
- This drawing is to be carefully checked by main contractor against site conditions and any discrepancy reported to KASHEC before construction commences.
- All manholes and inspection chambers to be fitted with D400 load class access covers.
- All channel drains/slot drains to be to D400 load class rated.

REV	DATE	AMENDMENT	BY	CHK	APPR
C6	21-11-17	AS BUILT	REA	VG	
C5	14-09-17	REVISED WHERE CLOUDED	REA	VG	
C4	18-08-17	REVISED WHERE CLOUDED	REA	VG	
C3	16-08-17	Chamber S8 delete	REA	VG	
C2	05-05-17	Info for field drain added and revisions as clouded.	AA	VG	
C1	25-04-17	Revised as clouded.	AA	VG	
C0	17-03-17	Issued For Construction	AA	VG	

KASHEC	KASHEC HOUSE MARKET HILL, ROYSTON HERTFORDSHIRE SG8 9JN UK TEL: +44 (0) 01763 247131 FAX: +44 (0) 01763 247029
CLIENT SDC	PROJECT RAF M Hendon
TITLE Drainage Scheme Sheet 3	PURPOSE OF ISSUE AS BUILT

DRAWN	CHECKED	APPROVED	DATE	SCALE
MA	VG	PS	17-03-2017	1:250@A0
DRG. NO. K1947-803				REVISION C6