
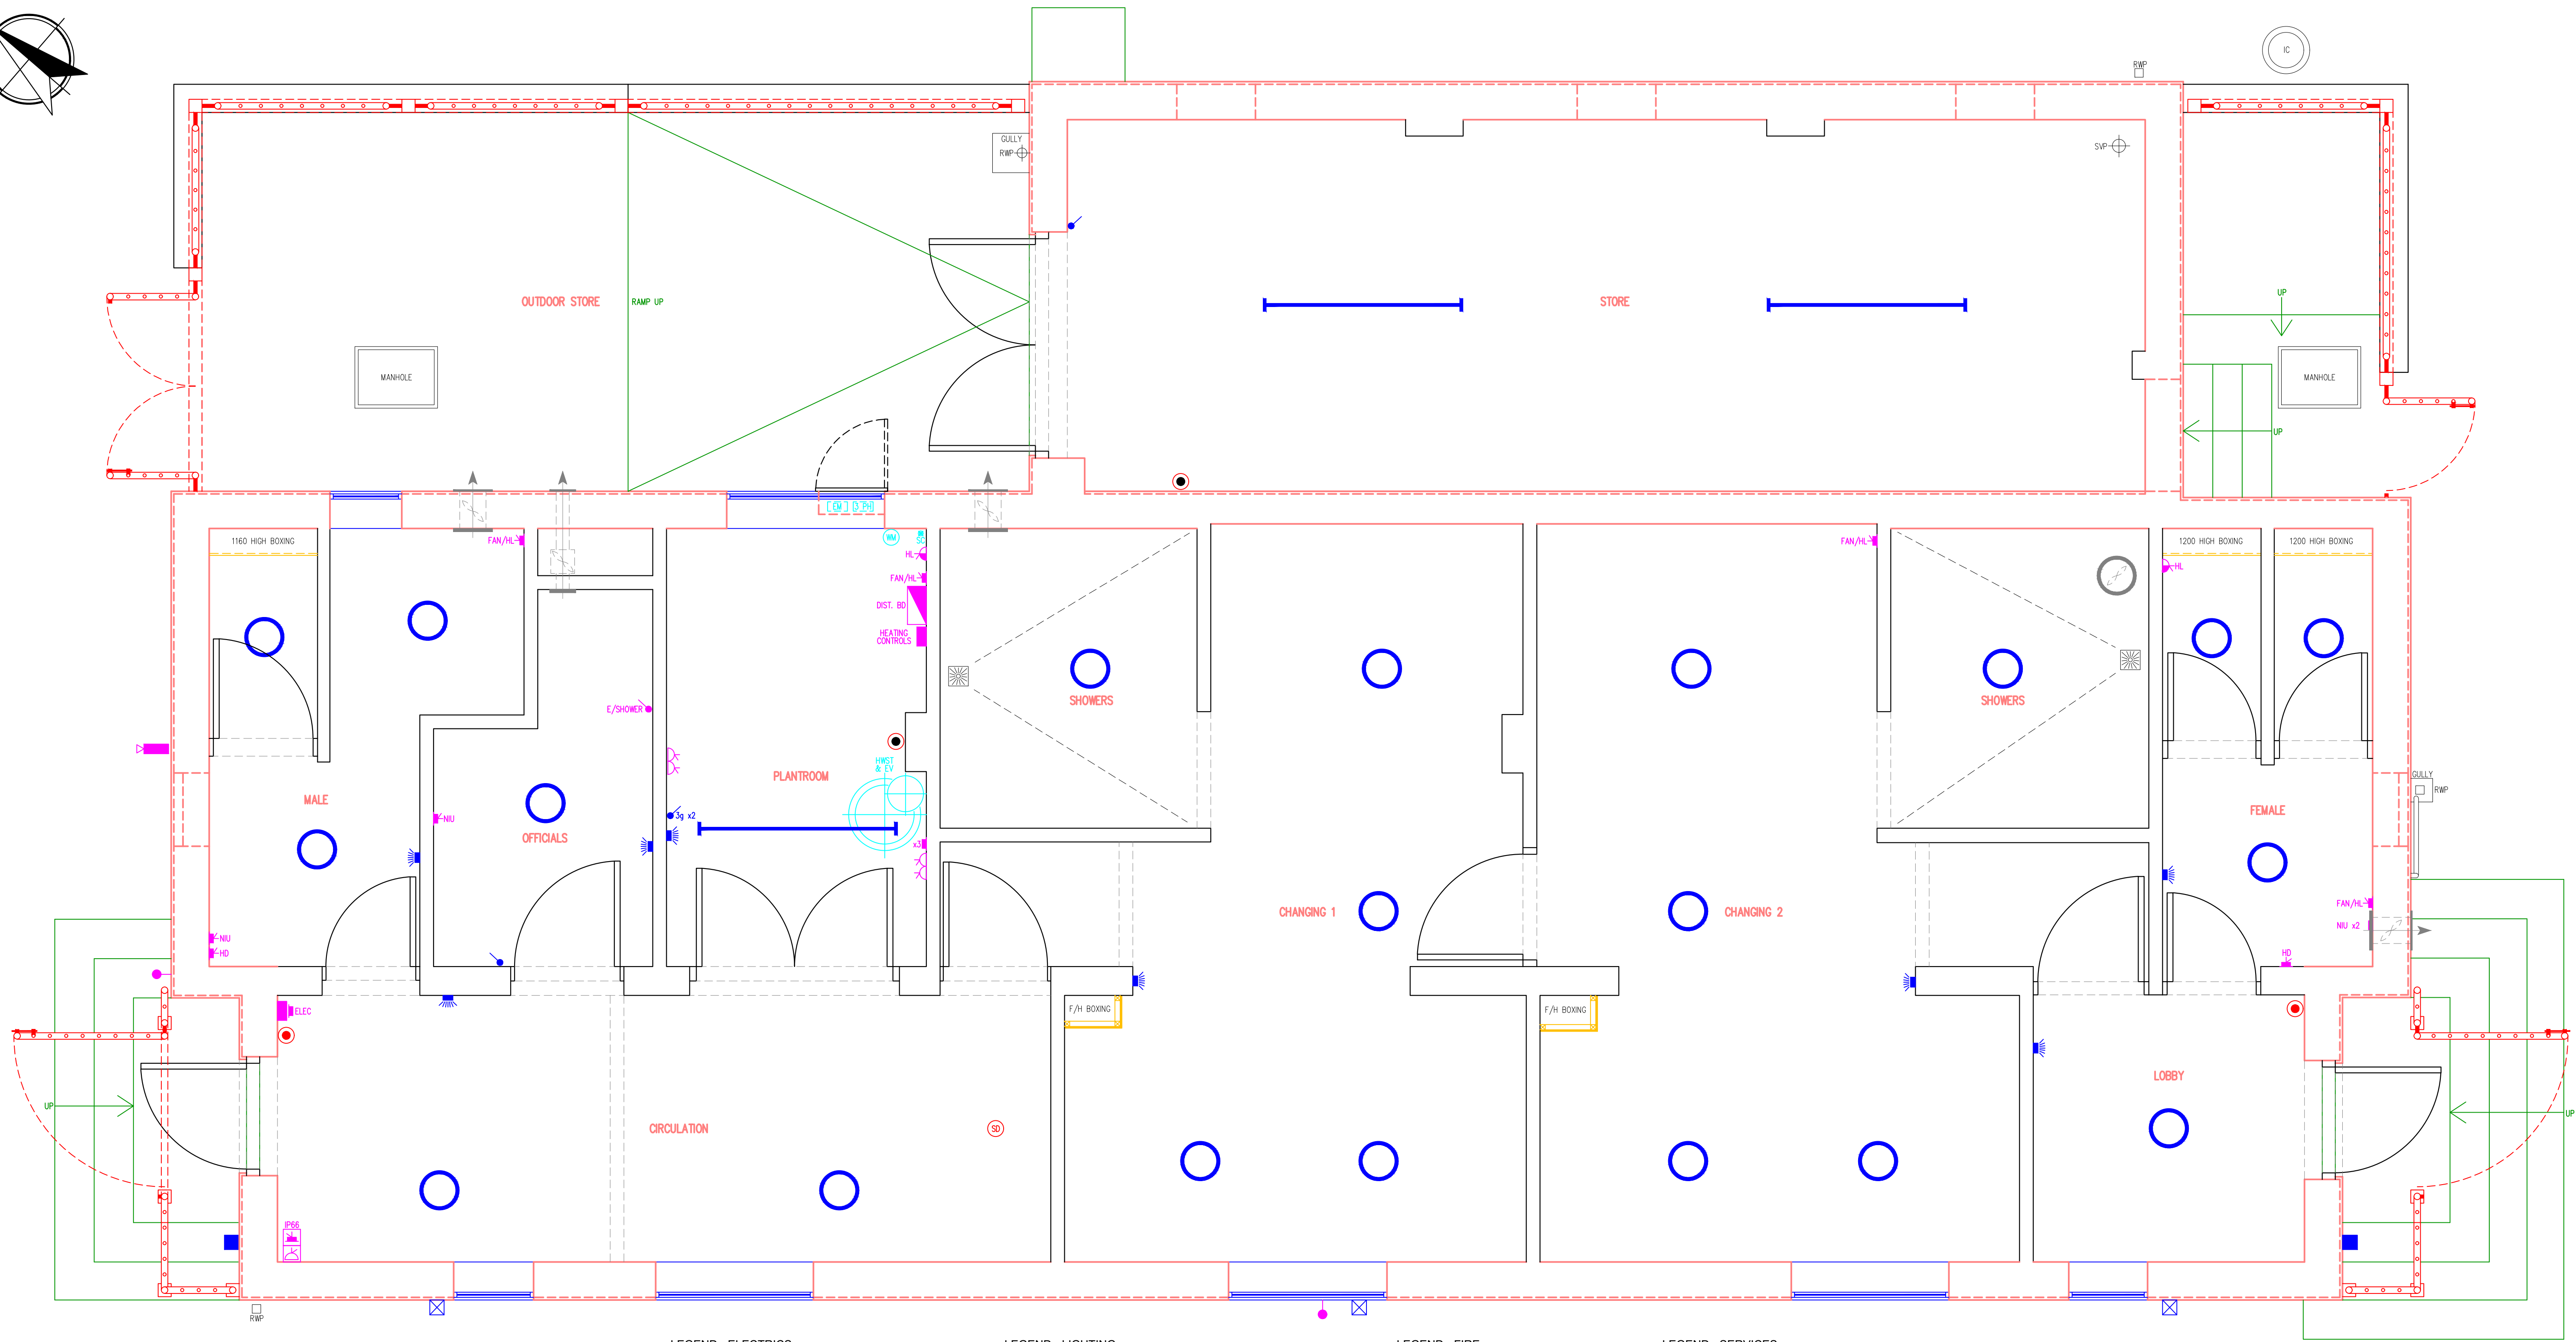


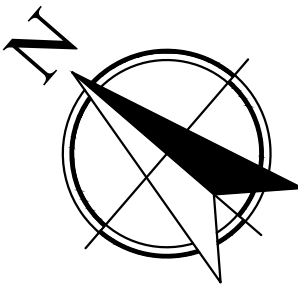

LEGEND - ELECTRICS

- CCTV CAMERA (CAGED)
- WIFI ANTENNA
- 13A SWITCHED DOUBLE SOCKET
- 13A SWITCHED FUSED SPUR
- HD - DENOTES HAND DRYER
- NIU - DENOTES NOT IN USE
- FAN/HL - EXTRACT FAN SUPPLY AT HIGH LEVEL
- 13A FUSED SPUR
- CONTROL SWITCH AT HIGH LEVEL
- 13A SWITCHED SINGLE SOCKET
- LOCATED IN IP68 CASING
- 13A SWITCHED FUSED SPUR
- LOCATED IN IP68 CASING
- ELECTRIC SHOWER CONTROL PULL CORD
- MAIN DISTRIBUTION BOARD

LEGEND - LIGHTING

- 1500 BATTEN FITTING
- 3000 SURFACE FITTING
- EXTERNAL BULKHEAD FITTING
- EXTERNAL SPOTLIGHT FITTING (CAGED)
- LIGHT SWITCH - (X DENOTES GANGS)
- WALL MOUNTED LIGHT PIR UNIT

LEGEND - FIRE

- SMOKE DETECTOR
- WATER FIRE EXTINGUISHER
- CO2 FIRE EXTINGUISHER

LEGEND - SERVICES

- ELECTRIC METER
- 3 PHASE INCOMER
- WATER METER
- STOP COCK
- HOT WATER STORAGE TANK
- EXPANSION VESSEL

Safety, Health & Environmental Information

All works are to be carried out by a person competent to undertake the type of work indicated on this drawing. This drawing is to be read in conjunction with the risk register produced for inclusion in the Health & Safety Plan. In addition to the hazards/risks normally associated with the types of works detailed on the drawing, note the following.

Construction: Refer to relevant H/S & risk register
Maintenance/Cleaning: Refer to relevant manual
Demolition/Adaption: Refer to relevant manual
Environmental: Refer to Asbestos Survey

All works are to comply with latest Building Regulation Requirements

Notes.
1. All dimensions are to be checked on site prior to any works taking place.

Do Not Scale from Drawing

Client



Meadowcroft Community Centre
Addison Crescent, Swindon, SN2 7JX
T e l : 0 1 7 9 3 8 2 3 7 6 1

Contractor



Hyde Road, Upper Stratton, Swindon, SN2 7RB
Tel: 01793 835 765 Fax: 01793 825 725
Email: enquires@edmont.co.uk Web: www.edmont.co.uk

Project



The Pavilion Reburishment

DRAWING STATUS

- ☒ PRELIMINARY/FOR INFORMATION ONLY
- ☐ WORKING DRAWING
- ☐ FOR CONSTRUCTION
- ☐ FOR APPROVAL
- ☐ APPROVED
- ☒ RECORD DRAWING

FI	FOR INFORMATION	19.7.24
Rev.	Description.	Date.

Drawing Title

Ground Floor
Existing Services Layout

Drawn By	Date	Scale	Sheet Size
LJH	Jul.2024	1:25	A1
Project No.	Discipline	Drawing No.	Revision
GE1610	FO	002	FI