


DO NOT SCALE

THIS DRAWING IS TO BE USED FOR ELECTRICAL INFORMATION ONLY

KEY

-  RECESSED FITTING WITH COMPACT FLUORESCENT LAMP
-  FLUORESCENT STRIP LIGHT
-  ENCLOSED FLUORESCENT STRIP LIGHT
-  WALL LIGHT
-  LIGHTING TRACK
-  DIMMER CONTROL PLATE
-  KEYSWITCH
-  RETRACTIVE SWITCH
-  2 WAY SWITCH WITH LED LOCATOR
-  CENTRAL BATTERY FOR EMERGENCY LIGHTING
-  INTERNALLY ILLUMINATED EMERGENCY EXIT SIGN
-  STATIC INVERTER FOR EXTERNAL EMERGENCY LIGHTING
-  LIGHTING CIRCUIT
-  EMERGENCY LIGHTING CIRCUIT

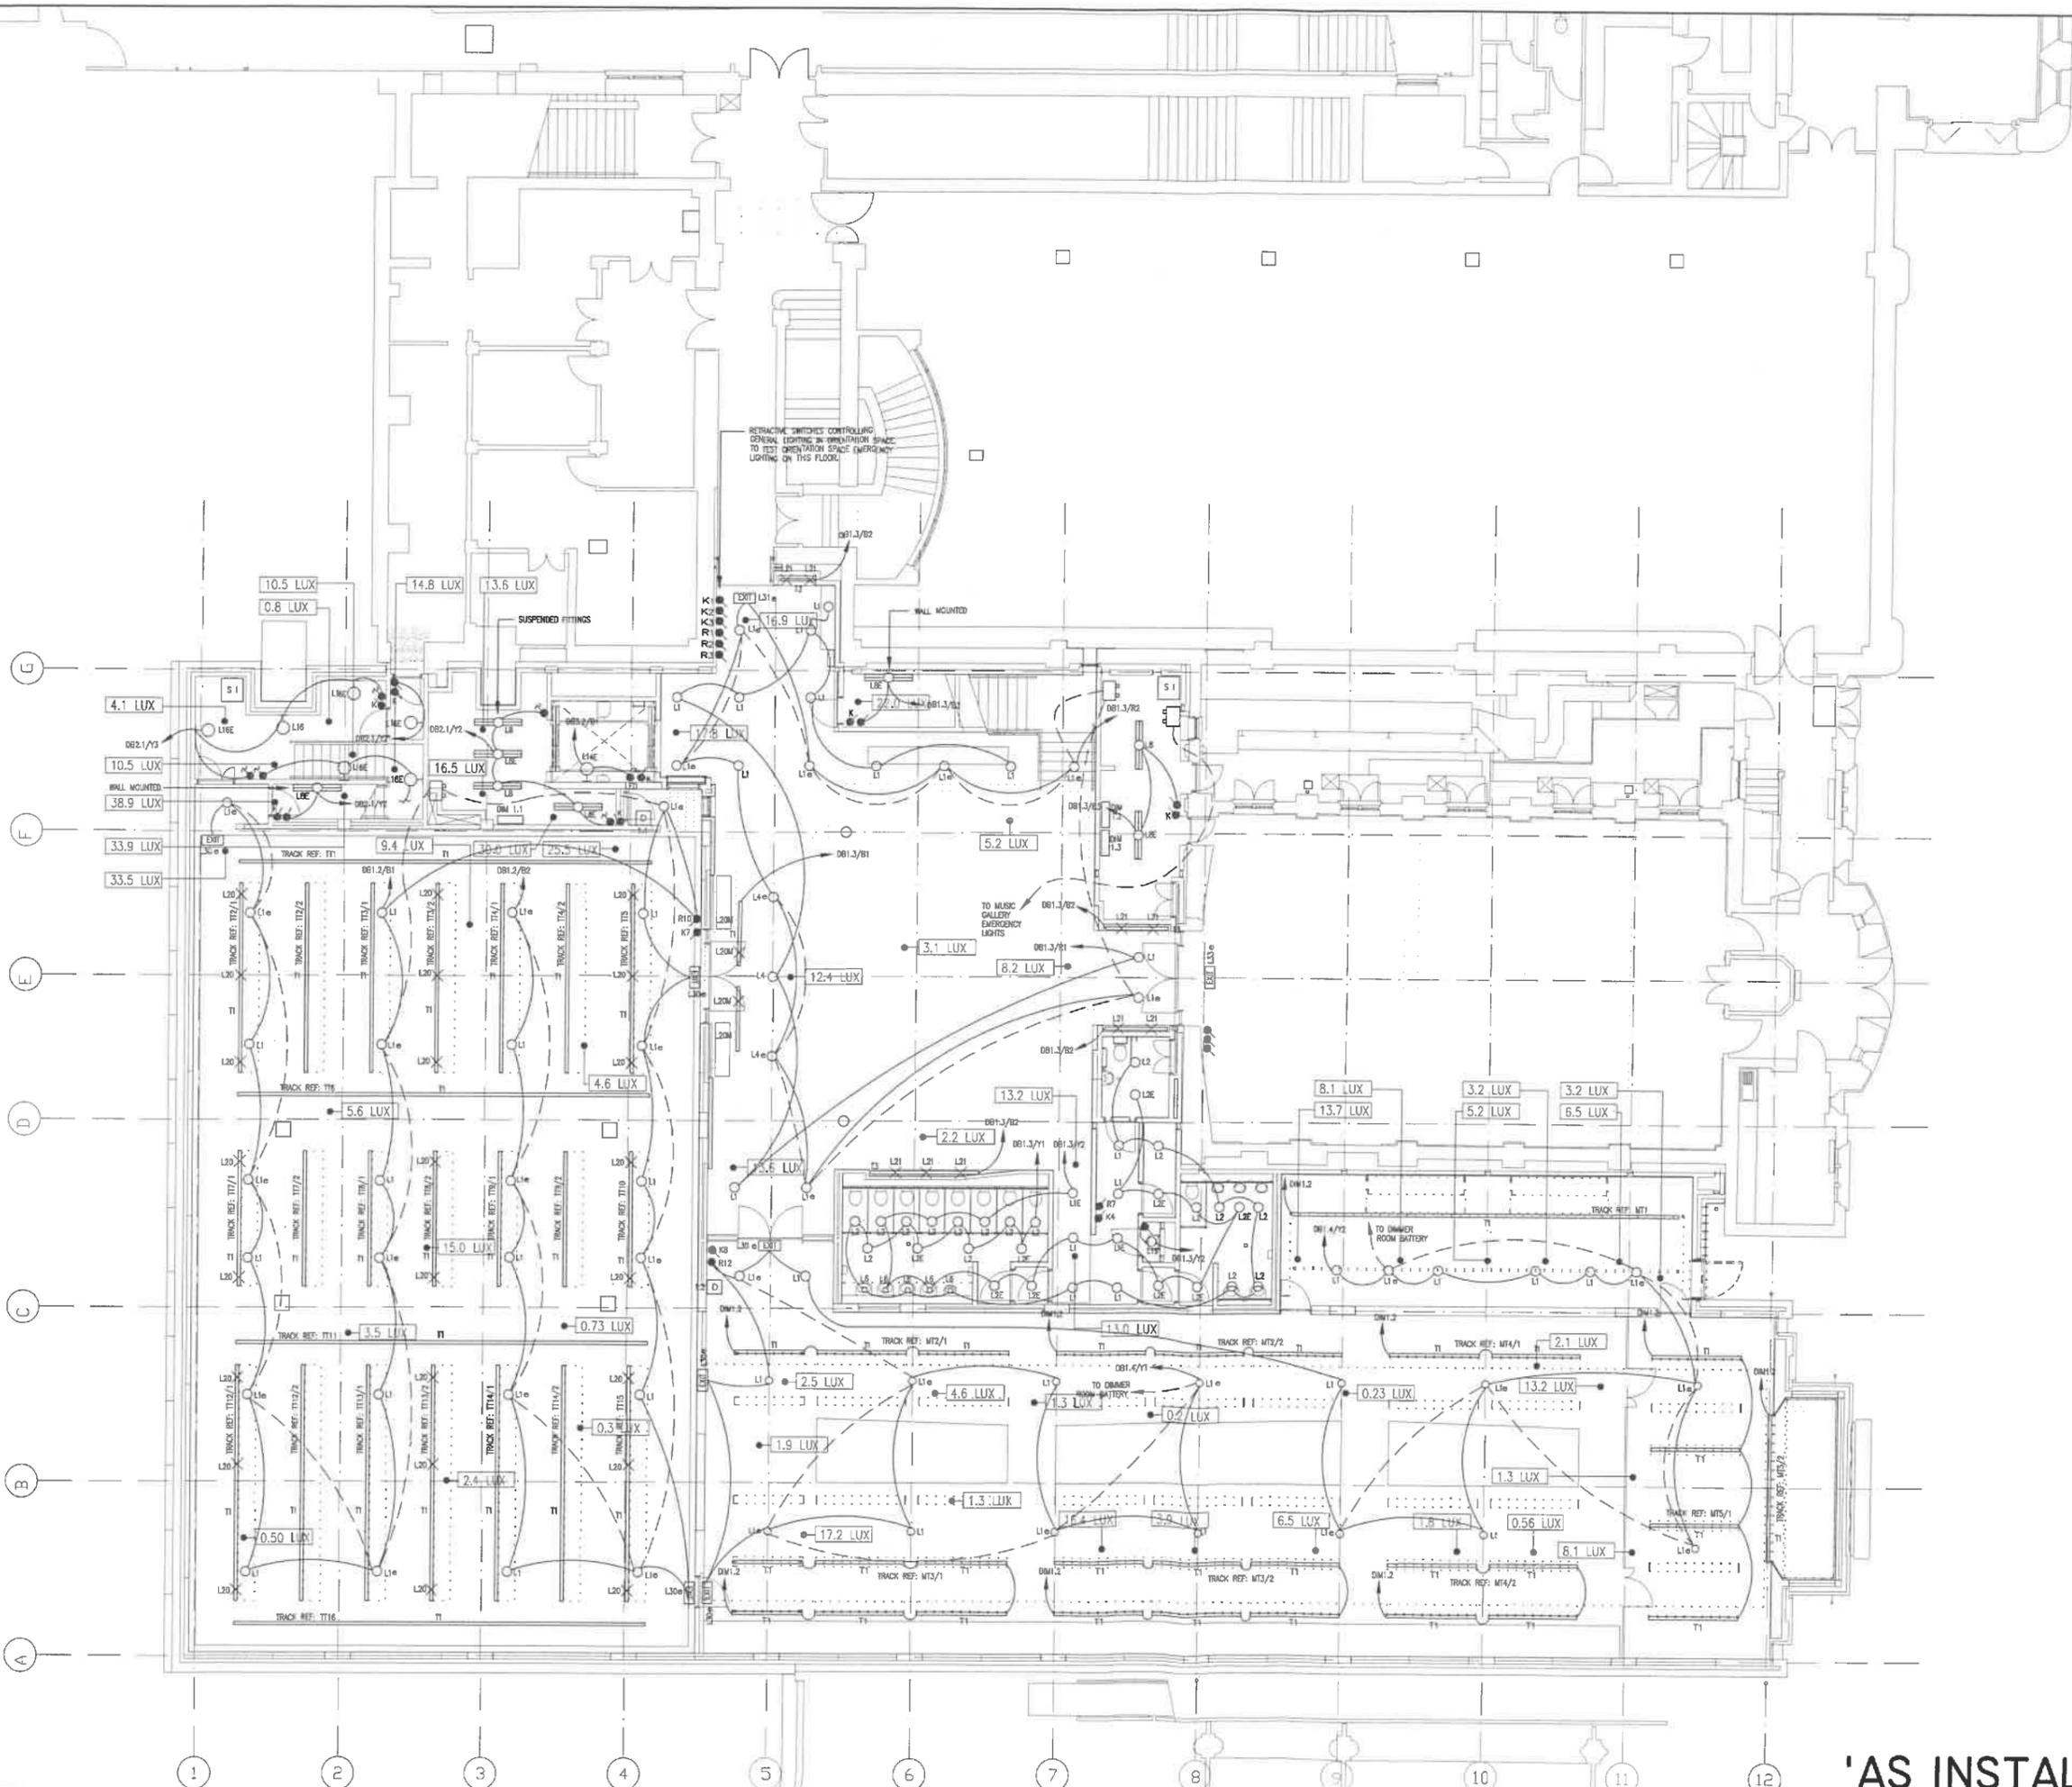

'AS INSTALLED'



CLIMBOR ROAD, WOOTTON, BOARS HILL, OXFORD OX1 5JW
 TEL. No. OXFORD 730881
 FACSIMILE No. 01885 326750

JOB **HORNIMAN 2001
 MAIN BUILDING (PHASE II)**

TITLE **LIGHTING
 LEVEL I**

DATE DEC. 01	SCALE 1:100@A1
DRAWN LO	CHECKED VS
DRAWING No. 1714 V(21)001	REVISION