




KEY FOR UNDERGROUND SERVICES	
AR	assumed route
BD	base band
BP	backdrop
CP	cable pit
CL	cover level
CR	cable riser
DP	down pipe
EDT	end of trace
EP	electricity pole
FH	fire hydrant
G	gully
GV	gas valve
HOR	head of run
HL	high level
IC	inspection chamber
IR	invert level
MR	manhole
PR	pipe riser
RE	rodding eye
RWP	rainwater pipe
SV	stop valve
SVP	soil vent pipe
TE	trapped exit
TFR	taken from records
TP	telegraph pole
UTL	unable to find
UTL	unable to lift
UTS	unable to survey
UTT	unable to trace
VP	vent pipe
WL	water level
WM	water meter
WO	wash out valve

Where chamber extents are significantly greater than the cover size, their approximate extents are shown thus:

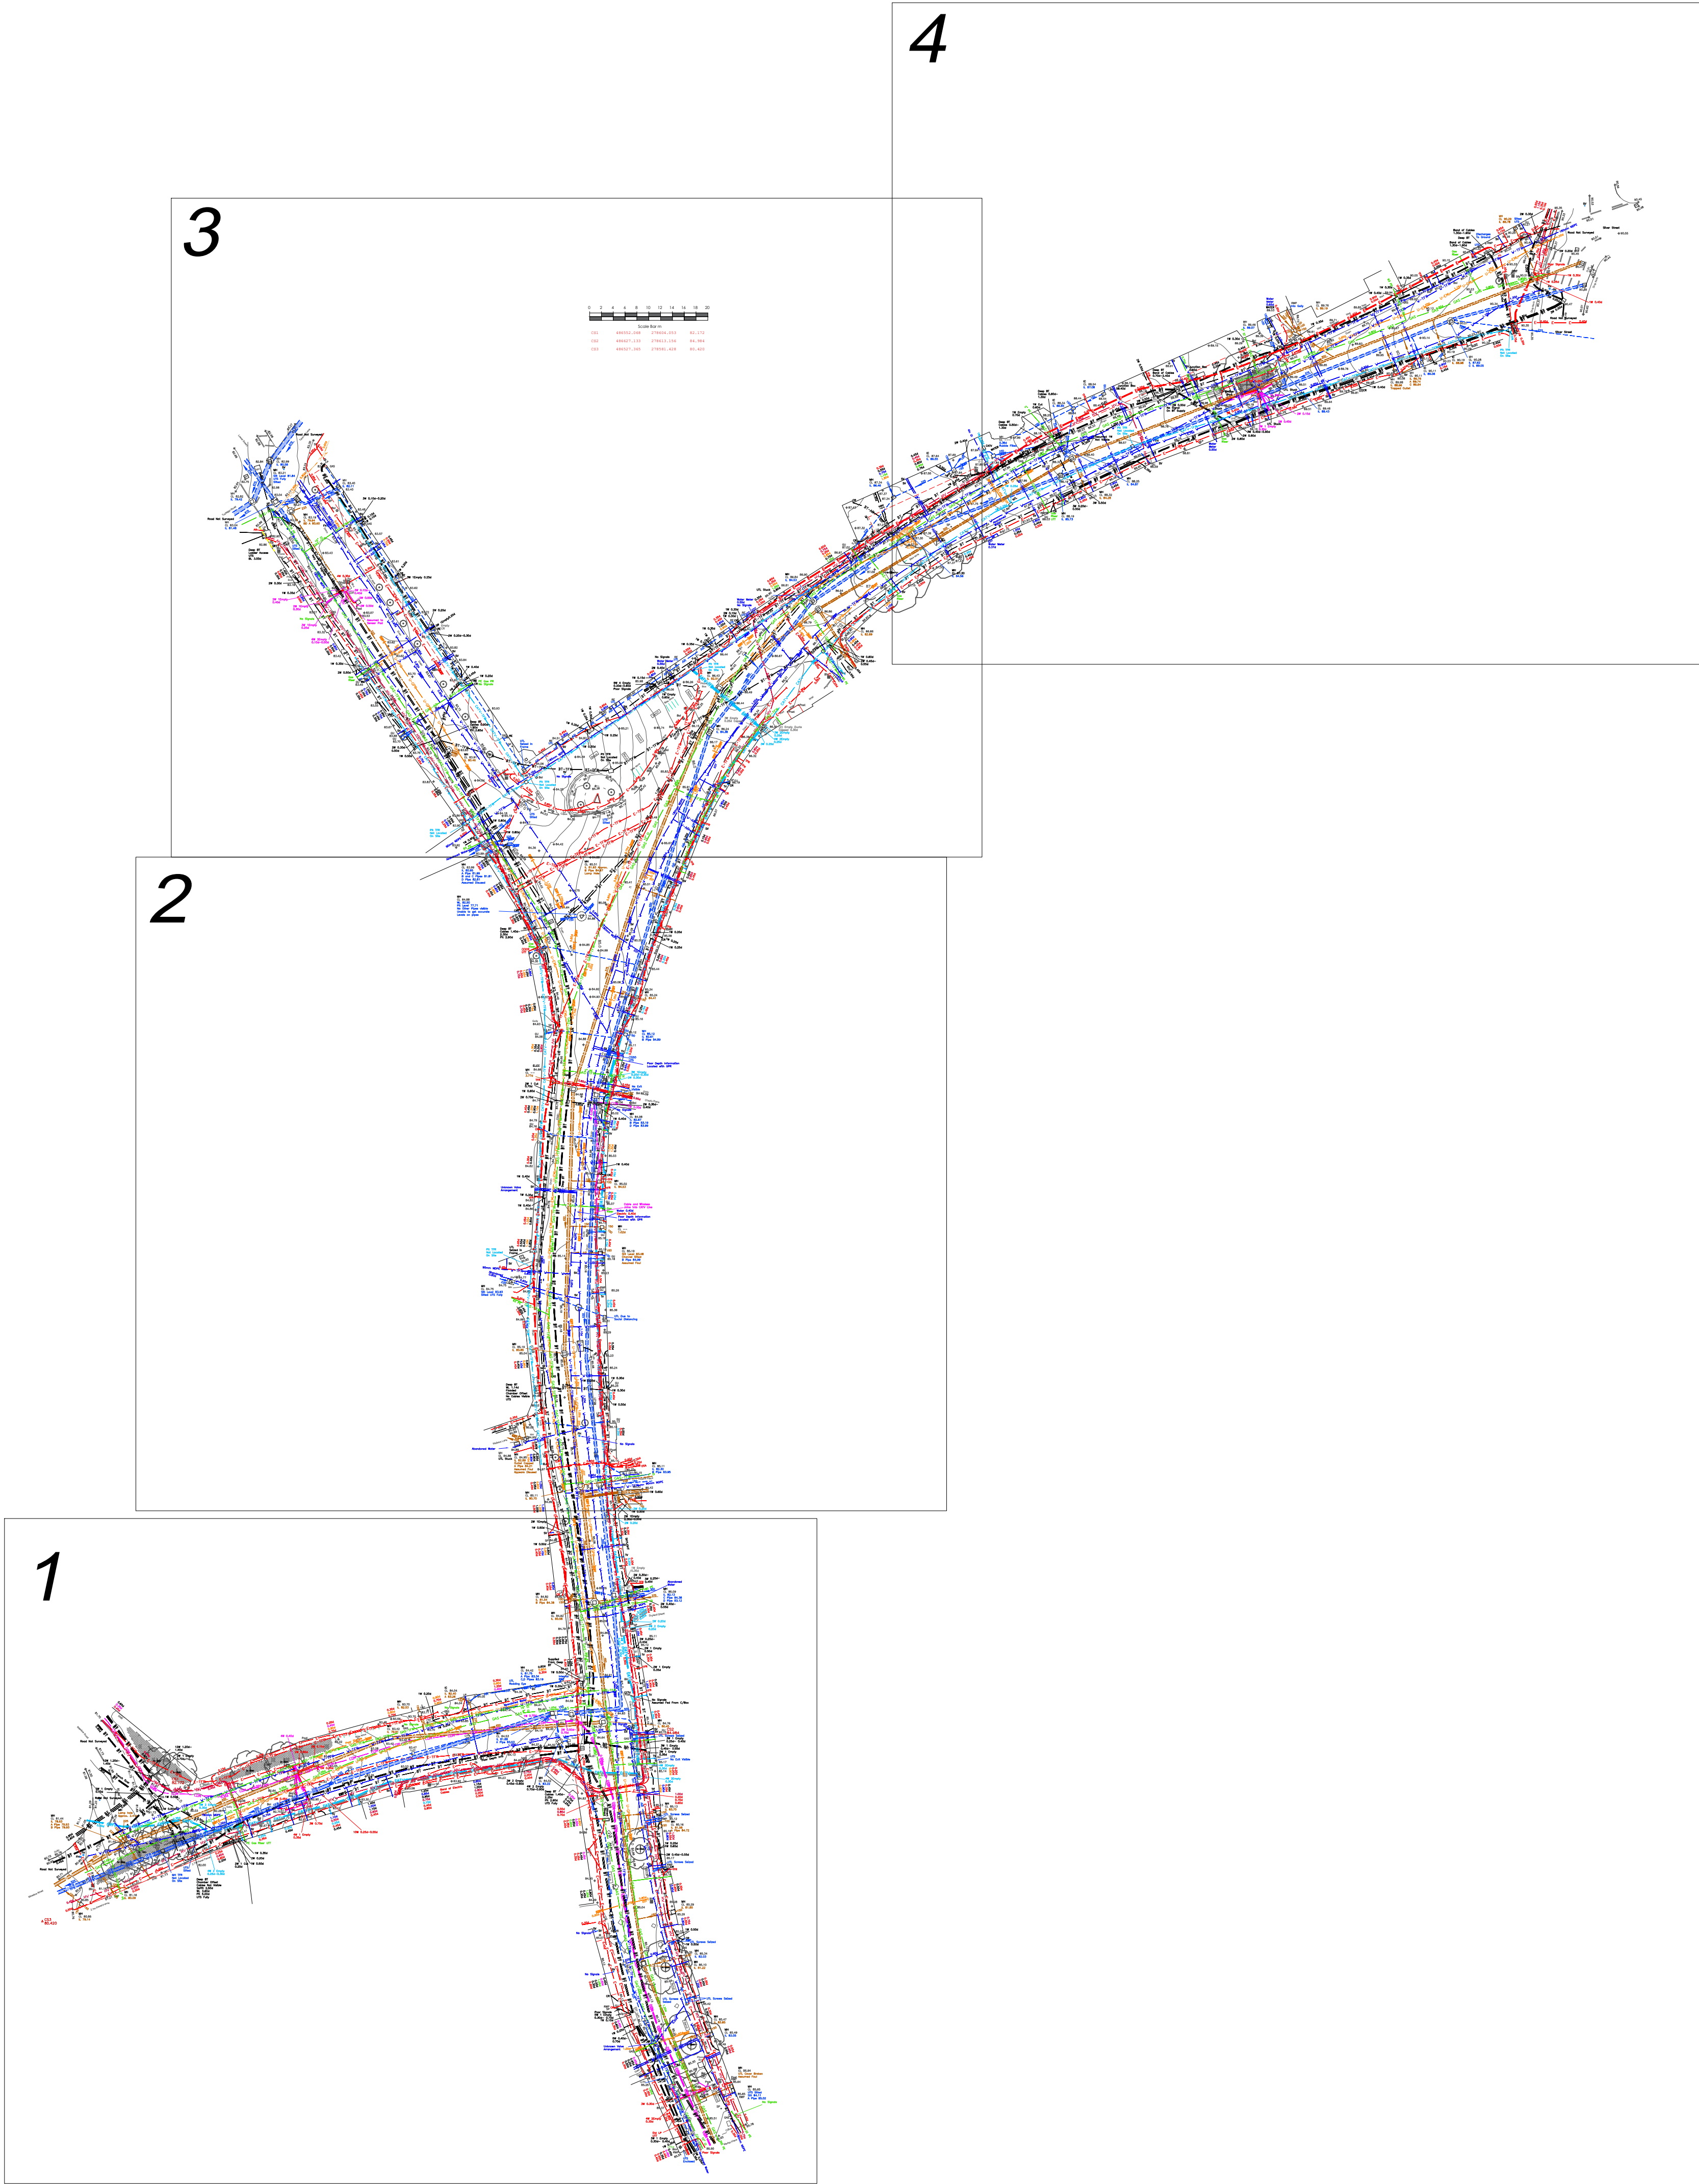

UTILITY SURVEY NOTES

ELECTROMAGNETIC AND/OR GROUND PENETRATING RADAR TECHNIQUES HAVE BEEN USED TO LOCATE AND MAP UNDERGROUND UTILITIES AND FEATURES ON THIS DRAWING. ALL HAVE MADE EVERY ENDEAVOUR TO MAKE SURE THAT THE INFORMATION CONTAINED WITHIN THIS DRAWING IS ACCURATE AND OF THE HIGHEST QUALITY. HOWEVER, THE RESULTS FROM THESE TYPES OF SURVEYS ARE NOT INFALLIBLE AND SHOULD THE LOCATION OR DEPTH OF SERVICES/FEATURES BE OF PARTICULAR IMPORTANCE TO A PROJECT, THEN IT IS STRONGLY ADVISED THAT TRIAL EXCAVATIONS SHOULD BE UNDERTAKEN TO CONFIRM SURVEY RESULTS.



AUL HAVE USED ALL RECORD DRAWINGS THAT WERE AVAILABLE TO US BY THE CLIENT OR BY THE STATUTORY UTILITY PROVIDERS AT THE TIME OF THE SURVEY. ANY INFORMATION TAKEN FROM THESE DRAWINGS (E PIPE SIZES, MATERIALS) IS NOT GUARANTEED. SERVICES LOCATED FROM RECORD DRAWINGS WILL BE SHOWN AND ANNOTATED AS TAKEN FROM RECORDS (TFR). HISTORIC RECORD INFORMATION IS OFTEN INCOMPLETE/INACCURATE AND CANNOT BE RELIED UPON.


A SINGLE LINE INDICATING A UTILITY MAY INDICATE THE PRESENCE OF MULTIPLE SERVICES WITHIN CLOSE PROXIMITY TO EACH OTHER. WHERE A SINGLE LINE TYPE IS SHOWN WE RECOMMEND HAND DIGGING WITHIN 0.5m, TO EXPOSE HIDDEN SERVICES.

WHERE QUOTED, DEPTH INFORMATION OF UNDERGROUND SERVICES/FEATURES IS STATED. DEPTHS ARE GENERALLY WITHIN +/- 10% ACCURATE, BUT CANNOT BE GUARANTEED. ANY DEPTHS SHOWN ARE USUALLY TO THE TOP OF THE SERVICE/FEATURE. GRAVITY SEWERS AND DRAINS ARE USUALLY TO INVERT (BASE OF DRAINAGE CHANNEL), UNLESS OTHERWISE STATED.

AT AUL WE USE SKILLED STAFF AND MODERN CALIBRATED EQUIPMENT TO PERFORM OUR SURVEYS. HOWEVER, THE COMPLETENESS OF ANY UNDERGROUND SURVEY CANNOT BE 100% GUARANTEED AND WE CANNOT BE HELD RESPONSIBLE FOR ANY INACCURACIES BEYOND THOSE THAT COULD BE REASONABLY EXPECTED BY A COMPETENT COMPANY.

CONTRACTORS UTILISING OUR DRAWINGS FOR INTRUSIVE WORK SHOULD TAKE ALL REASONABLE MEASURES TO WORK SAFELY IN ACCORDANCE WITH HSG47 GUIDELINES "AVOIDING DANGER FROM UNDERGROUND SERVICES".

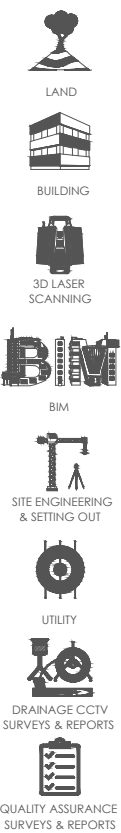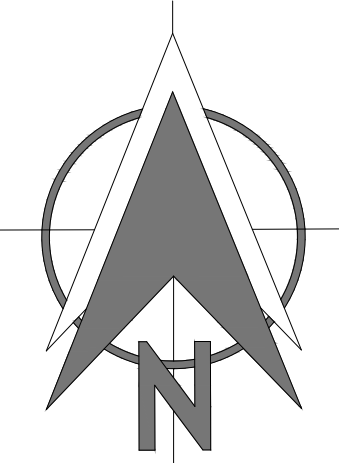

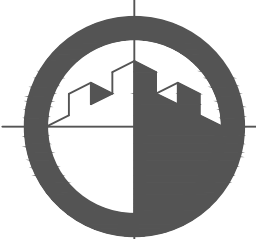

CASTLE SURVEYS LTD
CASTLE HOUSE
SOUTH STREET
ASHBY-DE-LA-ZOUCH
LEICESTERSHIRE
LE65 1BR
WWW.CASTLESURVEYS.CO.UK
MIDLANDS: 01530 589338
LONDON: 020 3728 2884
MANCHESTER: 0161 549 0206

CASTLE SURVEYS LTD

CLIENT:

Corby & Kettering Council

SITE DETAILS:

High Street, Kettering

TITLE:

Underground Utility

DRAWING NO.:

20146-20-04

REV:

-

SCALE:

1: NTS

DATE:

09-06-2020

DRAWN:

PJ

CHECKED:

PJ

Level datum

Comments:

This plan should only be used for its original purpose. Castle Surveys Ltd do not accept any responsibility for this plan if supplied to any other party, other than the original client.

All dimensions and levels should be check on site prior to design and construction.

Drainage information (where applicable) has been visually inspected from the surface and therefore should be treated as approximate only. Some services may have been omitted due to parked vehicles or due to the site being overgrown with vegetation.

Tree information (where applicable) has been surveyed from ground level and therefore should be treated as approximate only. Advise that a tree survey should be carried out.

Roof line work (where applicable) is indicative only.

DO NOT SCALE

Copyright Castle Surveys Ltd 2020

1



KEY FOR UNDERGROUND SERVICES	
AR	assumed route
BD	base band
CP	cover level
CR	cable riser
DP	down pipe
EDT	end of trace
EP	electricity pole
FH	fire hydrant
G	gully
GV	gas valve
HOR	head of run
HL	high level
IHL	inspection level
IR	invert level
MH	manhole
PR	pipe riser
RE	rodding eye
RWP	rainwater pipe
SV	stop valve
SVP	soil vent pipe
TE	trapped exit
TFR	taken from records
TP	telegraph pole
UTL	unable to find
UTL	unable to lift
UTS	unable to survey
UTT	unable to trace
VP	vent pipe
WL	water level
WM	water meter
WO	wash out valve

Where chamber extents are significantly greater than the cover size, their approximate extents are shown thus:

UTILITY SURVEY NOTES

ELECTROMAGNETIC AND/OR GROUND PENETRATING RADAR TECHNIQUES HAVE BEEN USED TO LOCATE AND MAP UNDERGROUND UTILITIES AND FEATURES ON THIS DRAWING. ALL HAVE MADE EVERY ENDEAVOUR TO MAKE SURE THAT THE INFORMATION CONTAINED WITHIN THIS DRAWING IS ACCURATE AND OF THE HIGHEST QUALITY. HOWEVER, THE RESULTS FROM THESE TYPES OF SURVEYS ARE NOT INFALLIBLE AND SHOULD THE LOCATION OR DEPTH OF SERVICES/FEATURES BE OF PARTICULAR IMPORTANCE TO A PROJECT, THEN IT IS STRONGLY ADVISED THAT TRIAL EXCAVATIONS SHOULD BE UNDERTAKEN TO CONFIRM SURVEY RESULTS.

ALL HAVE USED ALL RECORD DRAWINGS THAT WERE AVAILABLE TO US BY THE CLIENT OR BY THE STATUTORY UTILITY PROVIDERS AT THE TIME OF THE SURVEY. ANY INFORMATION TAKEN FROM THESE DRAWINGS (E PIPE SIZES, MATERIALS) IS NOT GUARANTEED. SERVICES LOCATED FROM RECORD DRAWINGS WILL BE SHOWN AND ANNOTATED AS TAKEN FROM RECORDS (TFR). HISTORIC RECORD INFORMATION IS OFTEN INCOMPLETE/INACCURATE AND CANNOT BE RELIED UPON.

A SINGLE LINE INDICATING A UTILITY MAY INDICATE THE PRESENCE OF MULTIPLE SERVICES WITHIN CLOSE PROXIMITY TO EACH OTHER. WHERE A SINGLE LINE TYPE IS SHOWN WE RECOMMEND HAND DIGGING WITHIN 0.5m, TO EXPOSE HIDDEN SERVICES.

WHERE QUOTED, DEPTH INFORMATION OF UNDERGROUND SERVICES/FEATURES IS STATED. DEPTHS ARE GENERALLY WITHIN +/- 10% ACCURATE, BUT CANNOT BE GUARANTEED. ANY DEPTHS SHOWN ARE USUALLY TO THE TOP OF THE SERVICE/FEATURE. GRADIENT SENSORS AND DRAINS ARE USUALLY TO INVERT (BASE OF DRAINAGE CHANNEL) UNLESS OTHERWISE STATED.

AT ALL WE USE SKILLED STAFF AND MODERN CALIBRATED EQUIPMENT TO PERFORM OUR SURVEYS. HOWEVER, THE COMPLETION OF ANY UNDERGROUND SURVEY CANNOT BE 100% GUARANTEED AND WE CANNOT BE HELD RESPONSIBLE FOR ANY INACCURACIES BEYOND THOSE THAT COULD BE REASONABLY EXPECTED BY A COMPETENT COMPANY.

CONTRACTORS UTILISING OUR DRAWINGS FOR INTRUSIVE WORK SHOULD TAKE ALL REASONABLE MEASURES TO WORK SAFELY IN ACCORDANCE WITH HSE47 GUIDELINES "AVOIDING DANGER FROM UNDERGROUND SERVICES".

CASTLE SURVEYS LTD
CASTLE HOUSE
SOUTH STREET
ASHBY-DE-LA-ZOUCH
LEICESTERSHIRE
LE65 1BR

WWW.CASTLESURVEYS.CO.UK

MIDLANDS: 01530 589338
LONDON: 020 3728 2884
MANCHESTER: 0161 549 0206

LAND

BUILDING

SEWER

SCANNING

BM

UTILITY

ENGINEERING & SETTING OUT

UTILITY


DRAINAGE CCTV

QUALITY ASSURANCE

SURVEY & RECORDS

CLIENT:	
Corby & Kettering Council	
SITE DETAILS:	
High Street, Kettering	
TITLE:	
Underground Utility	
DRAWING NO.:	REV:
20146-20-04	-
SCALE:	DATE:
1: 200	09-06-2020
DRAWN:	CHECKED:
PJ	PJ
Level datum	
Comments:	
This plan should only be used for its original purpose. Castle Surveys Ltd do not accept any responsibility for this plan if supplied to any other party, other than the original client.	
All dimensions and levels should be checked on site prior to design and construction.	
Drainage information (where applicable) has been visually inspected from the surface and therefore should be treated as approximate only. Some services may have been omitted due to parked vehicles or due to the site being overgrown with vegetation.	
Tree information (where applicable) has been surveyed from ground level and therefore should be treated as approximate only. Advise that a tree survey should be carried out.	
Roof line work (where applicable) is indicative only.	
DO NOT SCALE	
Copyright Castle Surveys Ltd 2020	

2

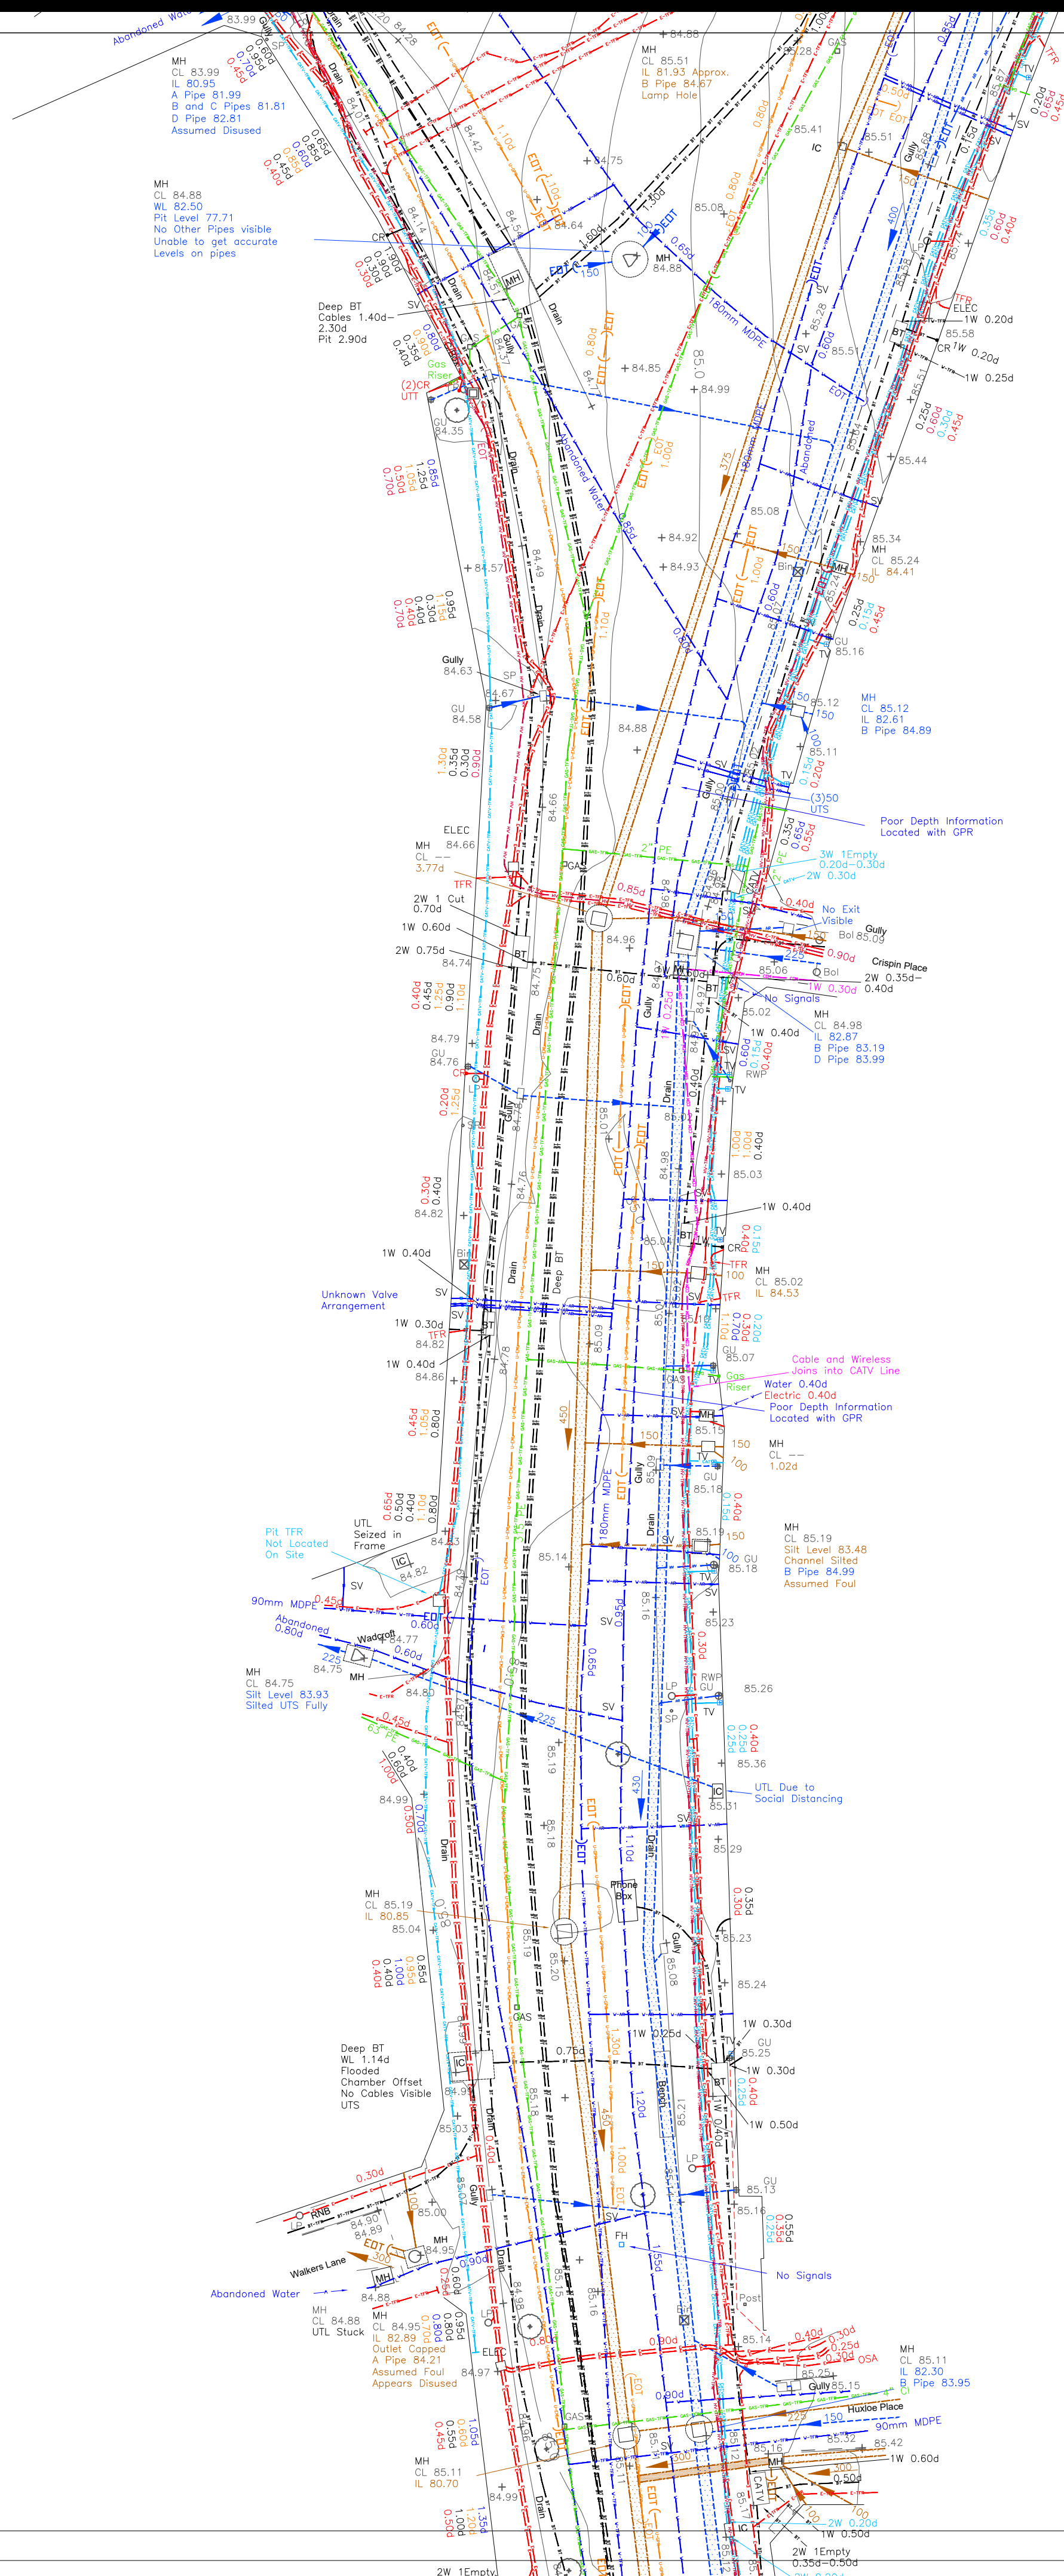

KEY FOR UNDERGROUND SERVICES	
AR	assumed route
BD	base band
CD	cover drop
CL	cable PT
CR	cover level
CP	cable PT
DP	down pipe
EDT	end of trace
EP	electricity pole
EV	fire hydrant
GV	gas valve
HOR	head of run
HL	high level
IC	inspection chamber
IR	invert level
MA	manhole
MR	manhole
RE	rodding eye
RWP	rainwater pipe
SV	stop valve
SVP	soil vent pipe
TE	trapped exit
TFR	taken from records
TP	telegraph pole
UTL	unable to find
UTL	unable to lift
UTS	unable to survey
UTT	unable to trace
VP	vent pipe
WM	water meter
WO	wash out valve

Where chamber extents are significantly greater than the cover size, their approximate extents are shown thus:



UTILITY SURVEY NOTES

ELECTROMAGNETIC AND/OR GROUND PENETRATING RADAR TECHNIQUES HAVE BEEN USED TO LOCATE AND MAP UNDERGROUND UTILITIES AND FEATURES ON THIS DRAWING. ALL HAVE MADE EVERY ENDEAVOUR TO MAKE SURE THAT THE INFORMATION CONTAINED WITHIN THIS DRAWING IS ACCURATE AND OF THE HIGHEST QUALITY. HOWEVER, THE RESULTS FROM THESE TYPES OF SURVEYS ARE NOT INFALLIBLE AND SHOULD THE LOCATION OR DEPTH OF SERVICES/FEATURES BE OF PARTICULAR IMPORTANCE TO A PROJECT, THEN IT IS STRONGLY ADVISED THAT TRIAL EXCAVATIONS SHOULD BE UNDERTAKEN TO CONFIRM SURVEY RESULTS.



ALL HAVE USED ALL RECORD DRAWINGS THAT WERE AVAILABLE TO US BY THE CLIENT OR BY THE STATUTORY UTILITY PROVIDERS AT THE TIME OF THE SURVEY. ANY INFORMATION TAKEN FROM THESE DRAWINGS (E PIPE SIZES, MATERIALS) IS NOT GUARANTEED. SERVICES LOCATED FROM RECORD DRAWINGS WILL BE SHOWN AND ANNOTATED AS TAKEN FROM RECORDS (TFR). HISTORIC RECORD INFORMATION IS OFTEN INCOMPLETE/INACCURATE AND CANNOT BE RELIED UPON.

A SINGLE LINE INDICATING A UTILITY MAY INDICATE THE PRESENCE OF MULTIPLE SERVICES WITHIN CLOSE PROXIMITY TO EACH OTHER. WHERE A SINGLE LINE TYPE IS SHOWN WE RECOMMEND HAND DIGGING WITHIN 0.5m, TO EXPOSE HIDDEN SERVICES.

WHERE QUOTED, DEPTH INFORMATION OF UNDERGROUND SERVICES/FEATURES IS STATED. DEPTHS ARE GENERALLY WITHIN +/- 10% ACCURATE, BUT CANNOT BE GUARANTEED. ANY DEPTHS SHOWN ARE USUALLY TO THE TOP OF THE SERVICE/FEATURE. GRAVITY SEWERS AND DRAINS ARE USUALLY TO INVERT (BASE OF DRAINAGE CHANNEL) UNLESS OTHERWISE STATED.

AT ALL WE USE SKILLED STAFF AND MODERN CALIBRATED EQUIPMENT TO PERFORM OUR SURVEYS. HOWEVER, THE COMPLETION OF ANY UNDERGROUND SURVEY CANNOT BE 100% GUARANTEED AND WE CANNOT BE HELD RESPONSIBLE FOR ANY INACCURACIES BEYOND THOSE THAT COULD BE REASONABLY EXPECTED BY A COMPETENT COMPANY.

CONTRACTORS UTILISING OUR DRAWINGS FOR INTRUSIVE WORK SHOULD TAKE ALL REASONABLE MEASURES TO WORK SAFELY IN ACCORDANCE WITH HSE47 GUIDELINES "AVOIDING DANGER FROM UNDERGROUND SERVICES".

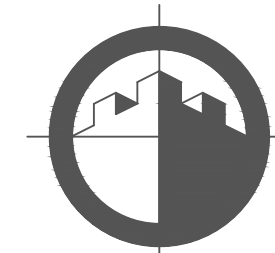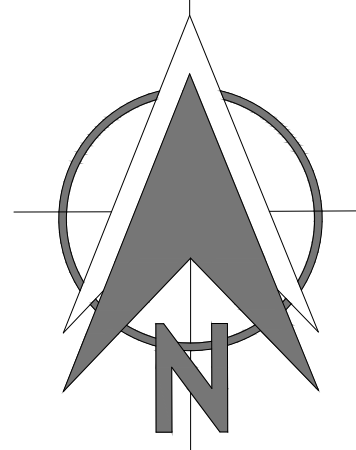

CASTLE SURVEYS LTD
CASTLE HOUSE
SOUTH STREET
ASHBY-DE-LA-ZOUCH
LEICESTERSHIRE
LE65 1BR

WWW.CASTLESURVEYS.CO.UK

MIDLANDS: 01530 589338
LONDON: 020 3728 2884
MANCHESTER: 0161 549 0206

CLIENT:

Corby & Kettering Council

SITE DETAILS:

High Street, Kettering

TITLE:

Underground Utility

DRAWING NO.:

20146-20-04

REV:

-

SCALE:

1: 200

DATE:

09-06-2020

DRAWN:

PJ

CHECKED:

PJ

Level datum

Comments:

This plan should only be used for its original purpose. Castle Surveys Ltd do not accept any responsibility for this plan if supplied to any other party, other than the original client.

All dimensions and levels should be checked on site prior to design and construction.


Drainage information (where applicable) has been visually inspected from the surface and therefore should be treated as approximate only. Some services may have been omitted due to parked vehicles or due to the site being overgrown with vegetation.

Tree information (where applicable) has been surveyed from ground level and therefore should be treated as approximate only. Advise that a tree survey should be carried out.

Roof line work (where applicable) is indicative only.

DO NOT SCALE

Copyright Castle Surveys Ltd 2020

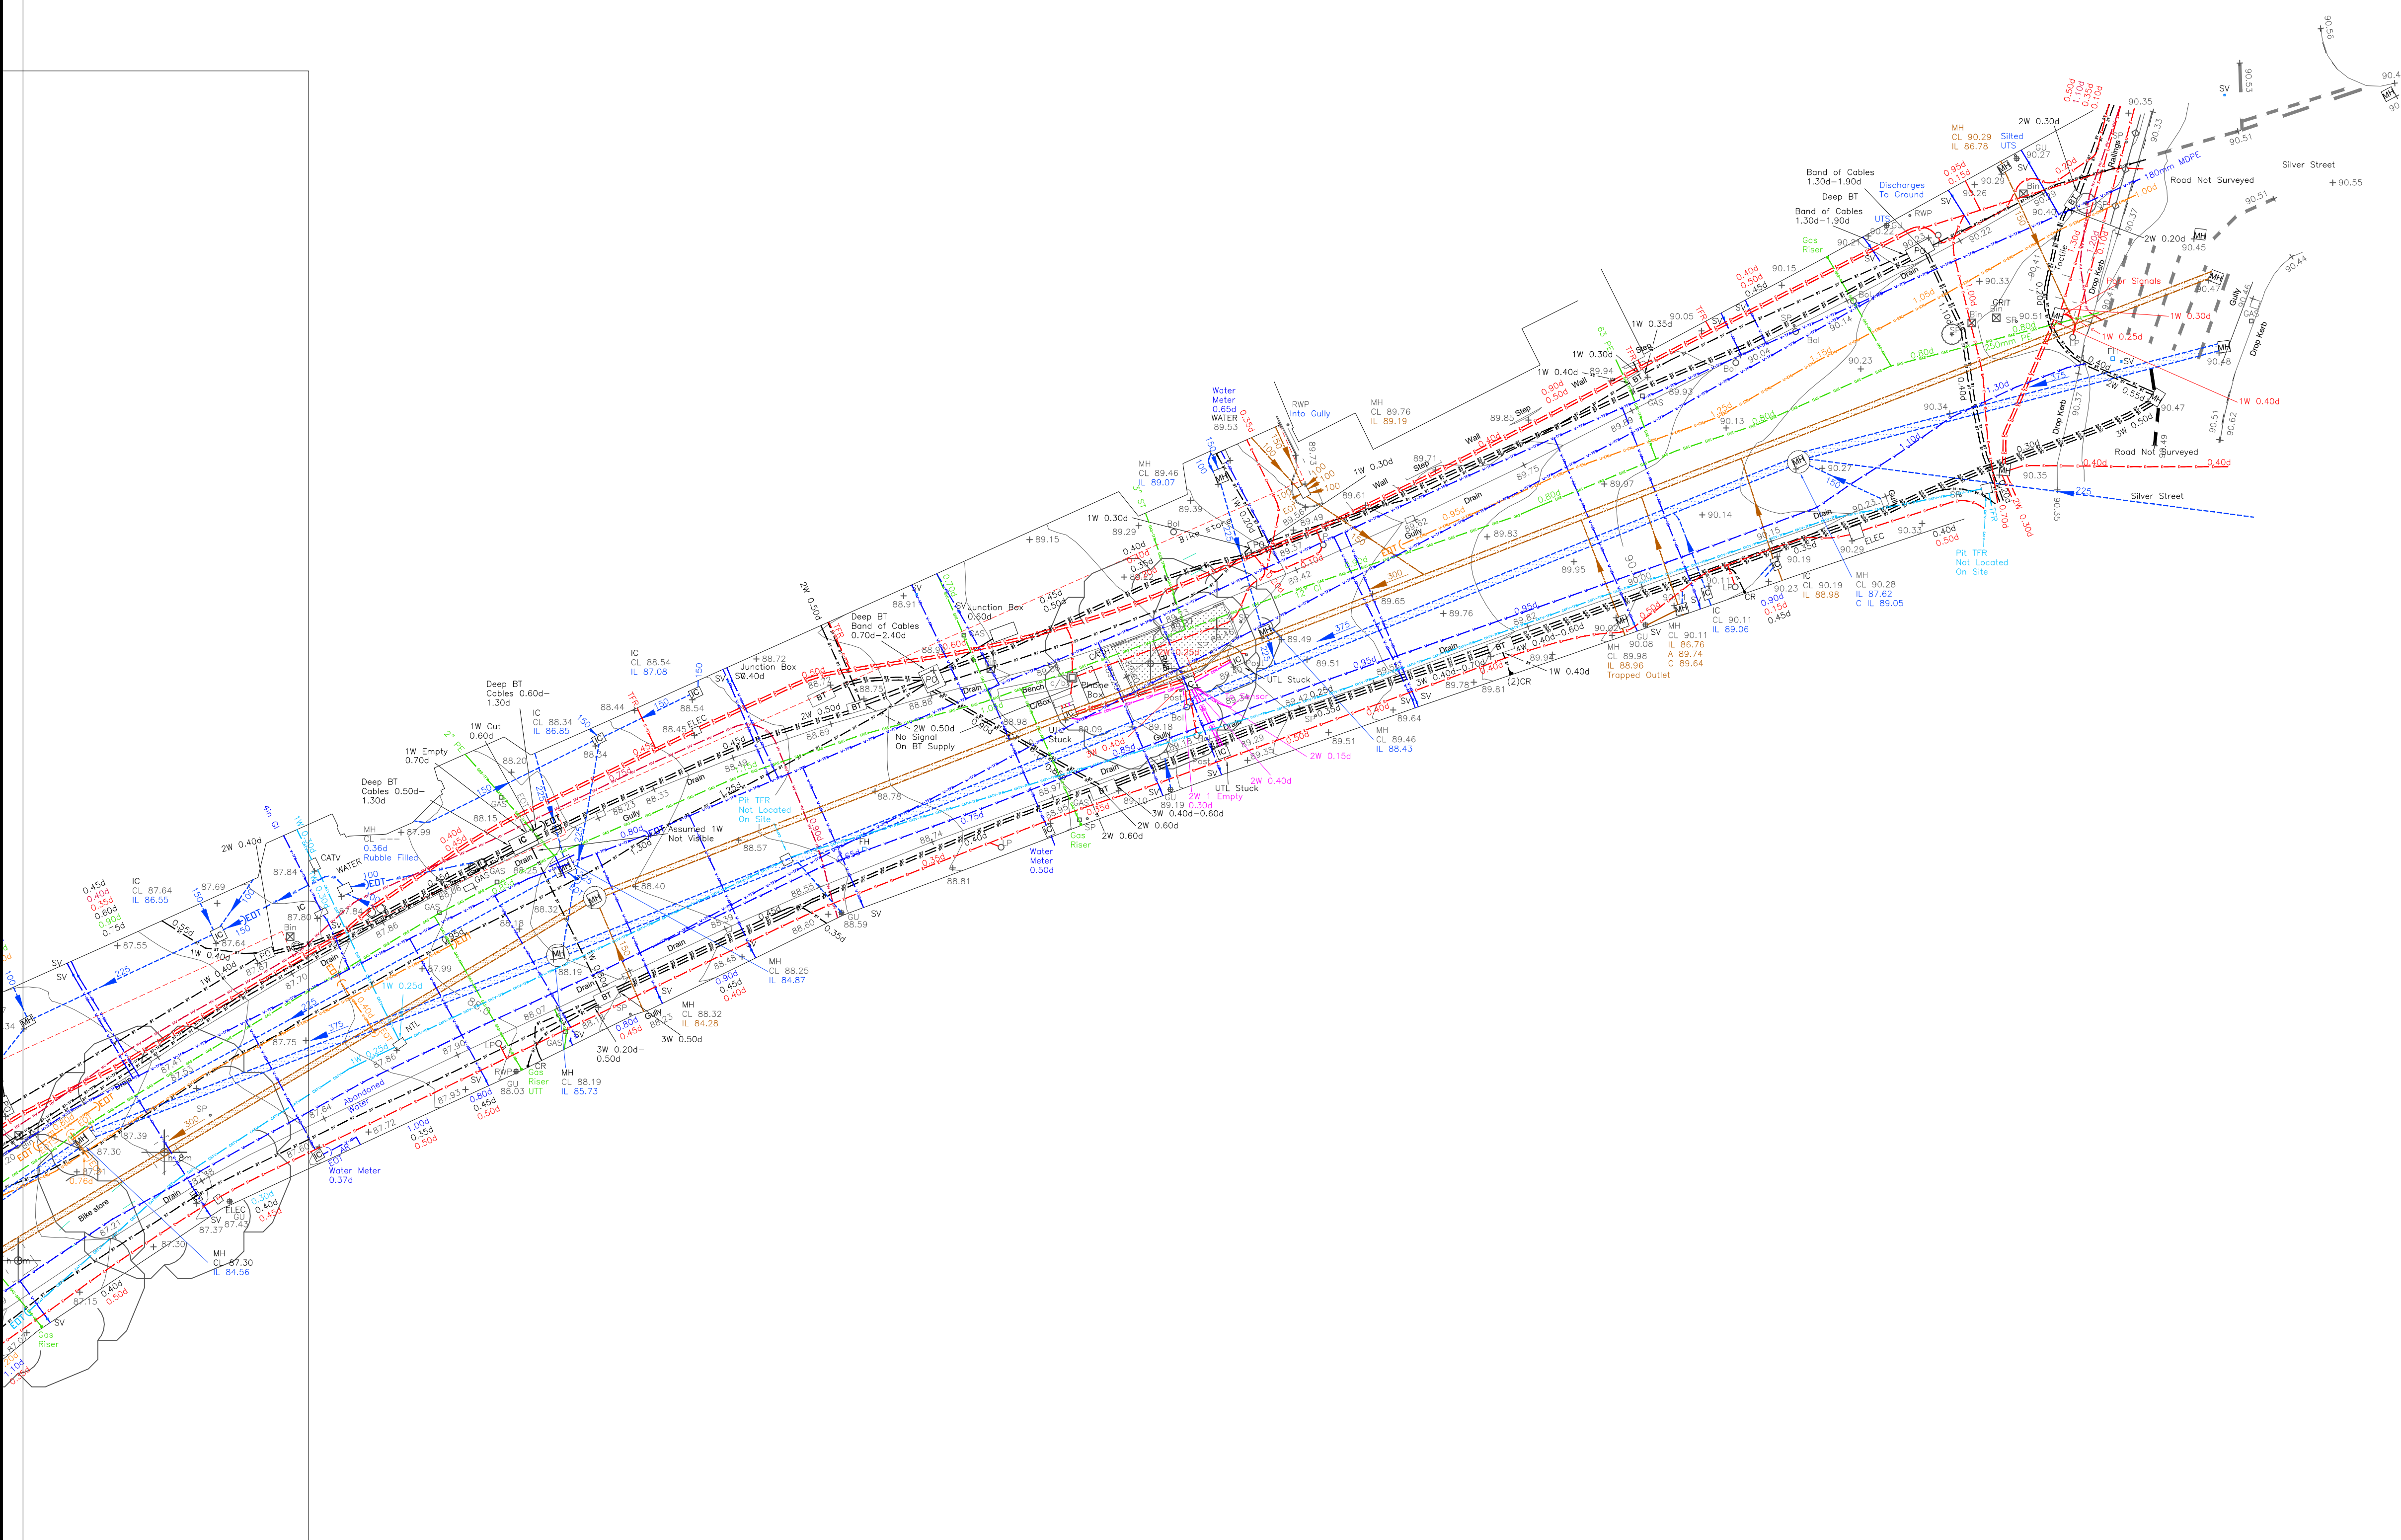

KEY FOR UNDERGROUND SERVICES	
AR	assumed route
BD	base band
BP	backdrop
CP	cable pit
CL	cover level
CR	cable riser
DP	down pipe
EDT	end of trace
EP	electricity pole
FH	fire hydrant
G	gully
GV	gas valve
HOR	head of run
HL	high level
IC	inspection chamber
IR	invert level
MH	manhole
PR	pipe riser
RE	rodding eye
RWP	rainwater pipe
SV	stop valve
SVP	soil vent pipe
TE	trapped exit
TFR	taken from records
TP	telegraph pole
UTL	unable to lift
UTF	unable to find
UTS	unable to survey
UTT	unable to trace
VP	vent pipe
WM	water meter
WO	wash out valve

Where chamber extents are significantly greater than the cover size, their approximate extents are shown thus:

UTILITY SURVEY NOTES

ELECTROMAGNETIC AND/OR GROUND PENETRATING RADAR TECHNIQUES HAVE BEEN USED TO LOCATE AND MAP UNDERGROUND UTILITIES AND FEATURES ON THIS DRAWING. ALL HAVE MADE EVERY ENDEAVOUR TO MAKE SURE THAT THE INFORMATION CONTAINED WITHIN THIS DRAWING IS ACCURATE AND OF THE HIGHEST QUALITY. HOWEVER, THE RESULTS FROM THESE TYPES OF SURVEYS ARE NOT INfallible AND SHOULD THE LOCATION OR DEPTH OF SERVICES/FEATURES BE OF PARTICULAR IMPORTANCE TO A PROJECT, THEN IT IS STRONGLY ADVISED THAT TRIAL EXCAVATIONS SHOULD BE UNDERTAKEN TO CONFIRM SURVEY RESULTS.

AHL HAVE USED ALL RECORD DRAWINGS THAT WERE AVAILABLE TO US BY THE CLIENT OR BY THE STATUTORY UTILITY PROVIDERS AT THE TIME OF THE SURVEY. ANY INFORMATION TAKEN FROM THESE DRAWINGS (E PIPE SIZES, MATERIALS) IS NOT GUARANTEED. SERVICES LOCATED FROM RECORD DRAWINGS WILL BE SHOWN AND ANNOTATED AS TAKEN FROM RECORDS (TFR). HISTORIC RECORD INFORMATION IS OFTEN INCOMPLETE/INACCURATE AND CANNOT BE RELIED UPON.

A SINGLE LINE INDICATING A UTILITY MAY INDICATE THE PRESENCE OF MULTIPLE SERVICES WITHIN CLOSE PROXIMITY TO EACH OTHER. WHERE A SINGLE LINE TYPE IS SHOWN WE RECOMMEND HAND DIGGING WITHIN 0.5m, TO EXPOSE HIDDEN SERVICES.

WHERE QUOTED, DEPTH INFORMATION OF UNDERGROUND SERVICES/FEATURES IS STATED. DEPTHS ARE GENERALLY WITHIN +/- 10% ACCURATE, BUT CANNOT BE GUARANTEED. ANY DEPTHS SHOWN ARE USUALLY TO THE TOP OF THE SERVICE/FEATURE. GRAVITY SEWERS AND DRAINS ARE USUALLY TO INVERT (BASE OF DRAINAGE CHANNEL) UNLESS OTHERWISE STATED.

AT ALL WE USE SKILLED STAFF AND MODERN CALIBRATED EQUIPMENT TO PERFORM OUR SURVEYS. HOWEVER, THE COMPLETENESS OF ANY UNDERGROUND SURVEY CANNOT BE 100% GUARANTEED AND WE CANNOT BE HELD RESPONSIBLE FOR ANY INACCURACIES BEYOND THOSE THAT COULD BE REASONABLY EXPECTED BY A COMPETENT COMPANY.

CONTRACTORS UTILISING OUR DRAWINGS FOR INTRUSIVE WORK SHOULD TAKE ALL REASONABLE MEASURES TO WORK SAFELY IN ACCORDANCE WITH HSE47 GUIDELINES "AVOIDING DANGER FROM UNDERGROUND SERVICES".

LAND

BUILDING

SURVEY SCANNING

BIM

SET ENGINEERING & SETTING OUT

UTILITY

QUANTASAT CCTV SURVEYS & RECORDS

CASTLE SURVEYS LTD
CASTLE HOUSE
SOUTH STREET
ASHBY-DE-LA-ZOUCH
LEICESTERSHIRE
LE65 1BR
WWW.CASTLESURVEYS.CO.UK

MIDLANDS: 01530 588338
LONDON: 020 3728 2884
MANCHESTER: 0161 549 0206

CLIENT:

Corby & Kettering Council

SITE DETAILS:

High Street, Kettering

TITLE:

Underground Utility

DRAWING NO.:	REV:
20146-20-04	-

SCALE:	DATE:
1: 200	09-06-2020

DRAWN:	CHECKED:
PJ	PJ

Level datum

Comments:

This plan should only be used for its original purpose. Castle Surveys Ltd do not accept any responsibility for this plan if supplied to any other party, other than the original client.

All dimensions and levels should be checked on site prior to design and construction.

Drainage information (where applicable) has been visually inspected from the surface and therefore should be treated as approximate only. Some services may have been omitted due to parked vehicles or due to the site being overgrown with vegetation.

Tree information (where applicable) has been surveyed from ground level and therefore should be treated as approximate only. Advise that a tree survey should be carried out.

Roof line work (where applicable) is indicative only.

DO NOT SCALE

Copyright Castle Surveys Ltd 2020