


LOCATION PLAN
SCALE 1:50,000

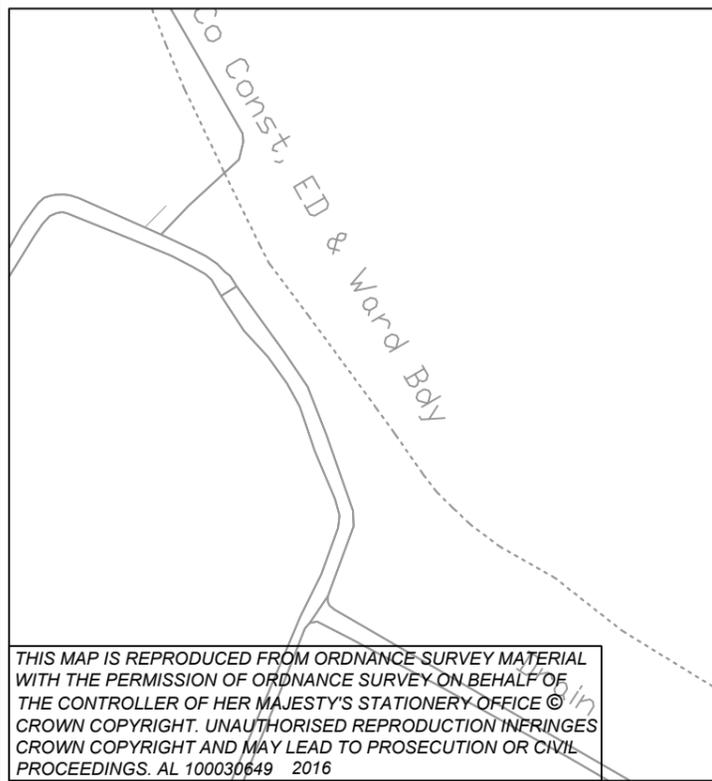

LOCATION PLAN
SCALE 1:1000

NOTES

1. ALL DIMENSIONS ARE IN METRES UNLESS OTHERWISE NOTED.

RIVER BRUE
STRUCTURE KEY: 1812
OS GRID REF: 332850E, 146480N

THIS MAP IS REPRODUCED FROM ORDNANCE SURVEY MATERIAL WITH THE PERMISSION OF ORDNANCE SURVEY ON BEHALF OF THE CONTROLLER OF HER MAJESTY'S STATIONERY OFFICE © CROWN COPYRIGHT. UNAUTHORISED REPRODUCTION INFRINGES CROWN COPYRIGHT AND MAY LEAD TO PROSECUTION OR CIVIL PROCEEDINGS. AL 100030649 2016




SCHEME NAME				M5 J22-23 RIVER BRUE BEARING REPLACEMENT			
DRAWING TITLE				RIVER BRUE - LOCATION PLAN			
DRAWN : JB		SCALE : AS STATED		DRAWING STATUS			
DESIGN : JB		DIMENSIONS : AS STATED		WORK IN PROGRESS			
CHKD : JM		ORIG DWG SIZE: A3		PRELIMINARY DRAWING		✓	
APPD : JM		COPYRIGHT © KIER		EXTERNAL ISSUE			
DATE : 20/09/2018				AS-BUILT			
SUITABILITY: S2		FOR INFORMATION					

P1	FIRST ISSUE.	JM	JM	20/09/2018
REV	DETAILS	CHKD	APPD	DATE
DRAWING NUMBER				SCHEME REFERENCE No.
PROJECT	ORIGINATOR	VOLUME	TO 0379	
HE565232	KIER	SBR		
M5_ML_BR_1812	DE	CB	0100_01	REVISION
LOCATION	TYPE	ROLE	NUMBER	P 1



LOCATION PLAN
SCALE 1:50,000

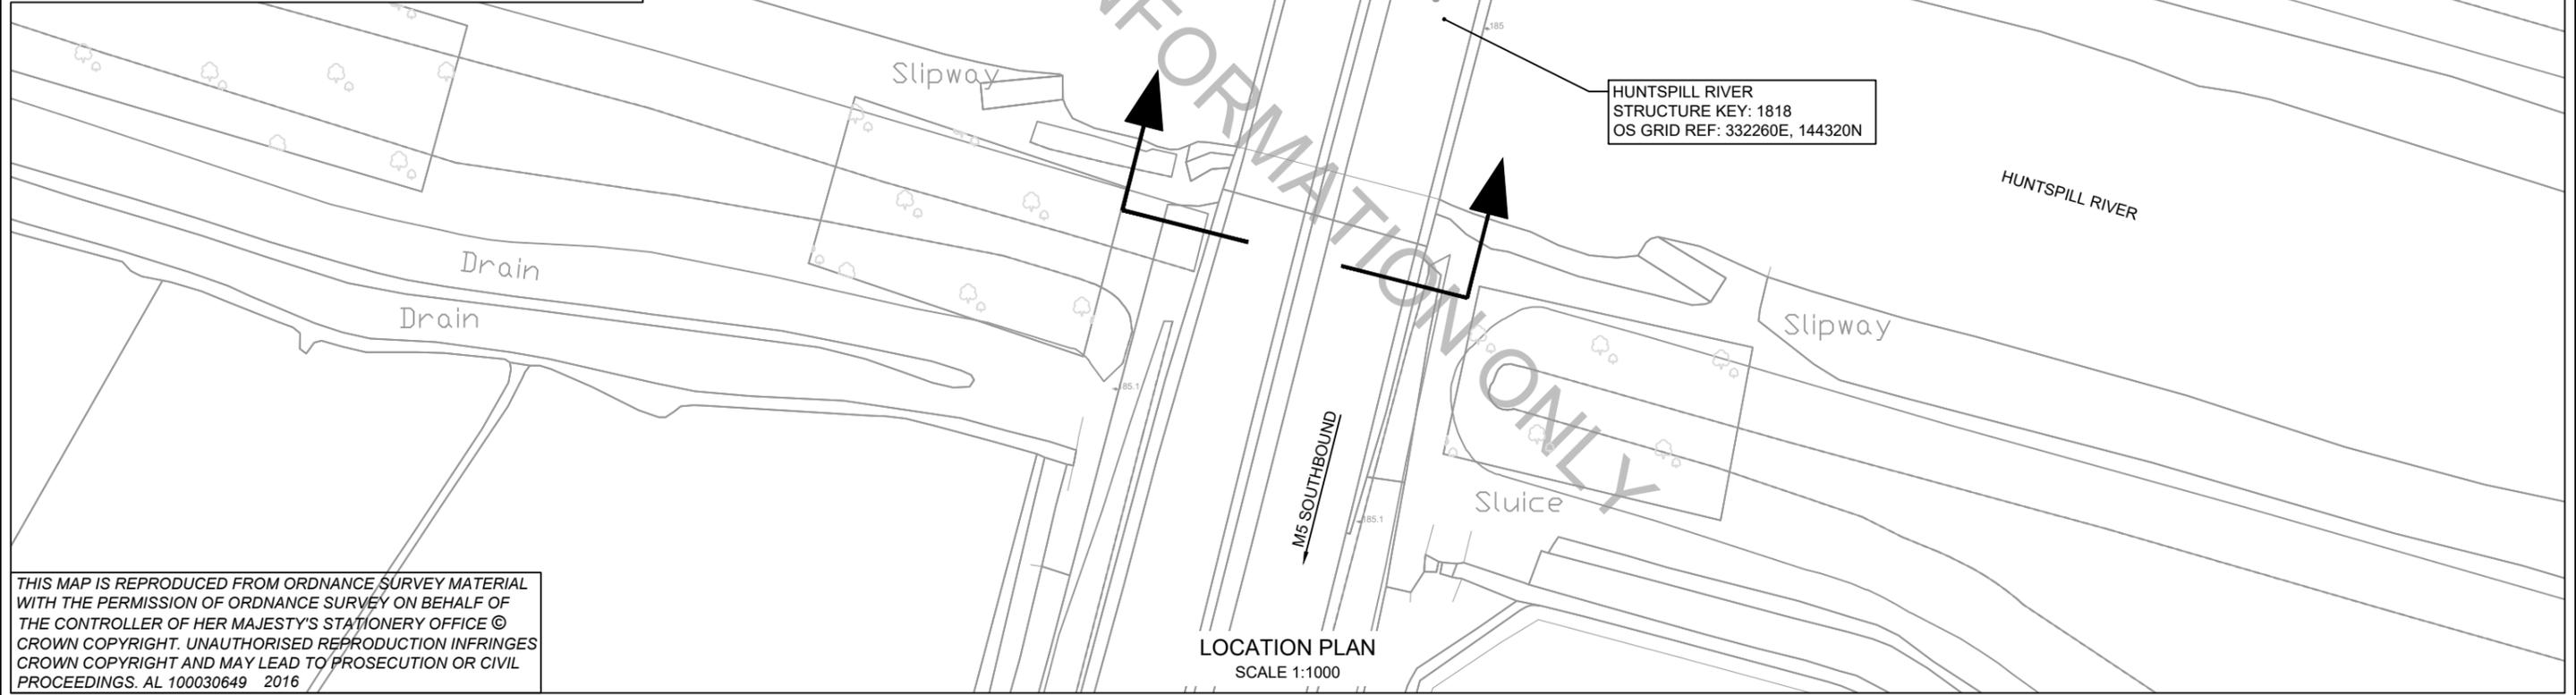

LOCATION PLAN
SCALE 1:1000

NOTES
1. ALL DIMENSIONS ARE IN METRES UNLESS OTHERWISE NOTED.

THIS MAP IS REPRODUCED FROM ORDNANCE SURVEY MATERIAL WITH THE PERMISSION OF ORDNANCE SURVEY ON BEHALF OF THE CONTROLLER OF HER MAJESTY'S STATIONERY OFFICE © CROWN COPYRIGHT. UNAUTHORISED REPRODUCTION INFRINGES CROWN COPYRIGHT AND MAY LEAD TO PROSECUTION OR CIVIL PROCEEDINGS. AL 100030649 2016

CLIENT

SCHEME NAME M5 J22-23 RIVER BRUE BEARING REPLACEMENT


DRAWING TITLE HUNTSPILL RIVER - LOCATION PLAN


DRAWN : JB	SCALE : AS STATED	DRAWING STATUS
DESIGN : JB	DIMENSIONS : AS STATED	WORK IN PROGRESS
CHKD : JM	ORIG DWG SIZE: A3	PRELIMINARY DRAWING <input checked="" type="checkbox"/>
APPD : JM	COPYRIGHT © KIER	EXTERNAL ISSUE
DATE : 20/09/2018		AS-BUILT
SUITABILITY: S2	FOR INFORMATION	

P1	FIRST ISSUE.	JM	JM	20/09/2018
REV	DETAILS	CHKD	APPD	DATE

AGENT

DRAWING NUMBER			SCHEME REFERENCE No. TO 0379	
PROJECT	ORIGINATOR	VOLUME		
HE565232	KIER	SBR		
M5_ML_BR_1818	DE	CB	0100_03	REVISION P 1
LOCATION	TYPE	ROLE	NUMBER	

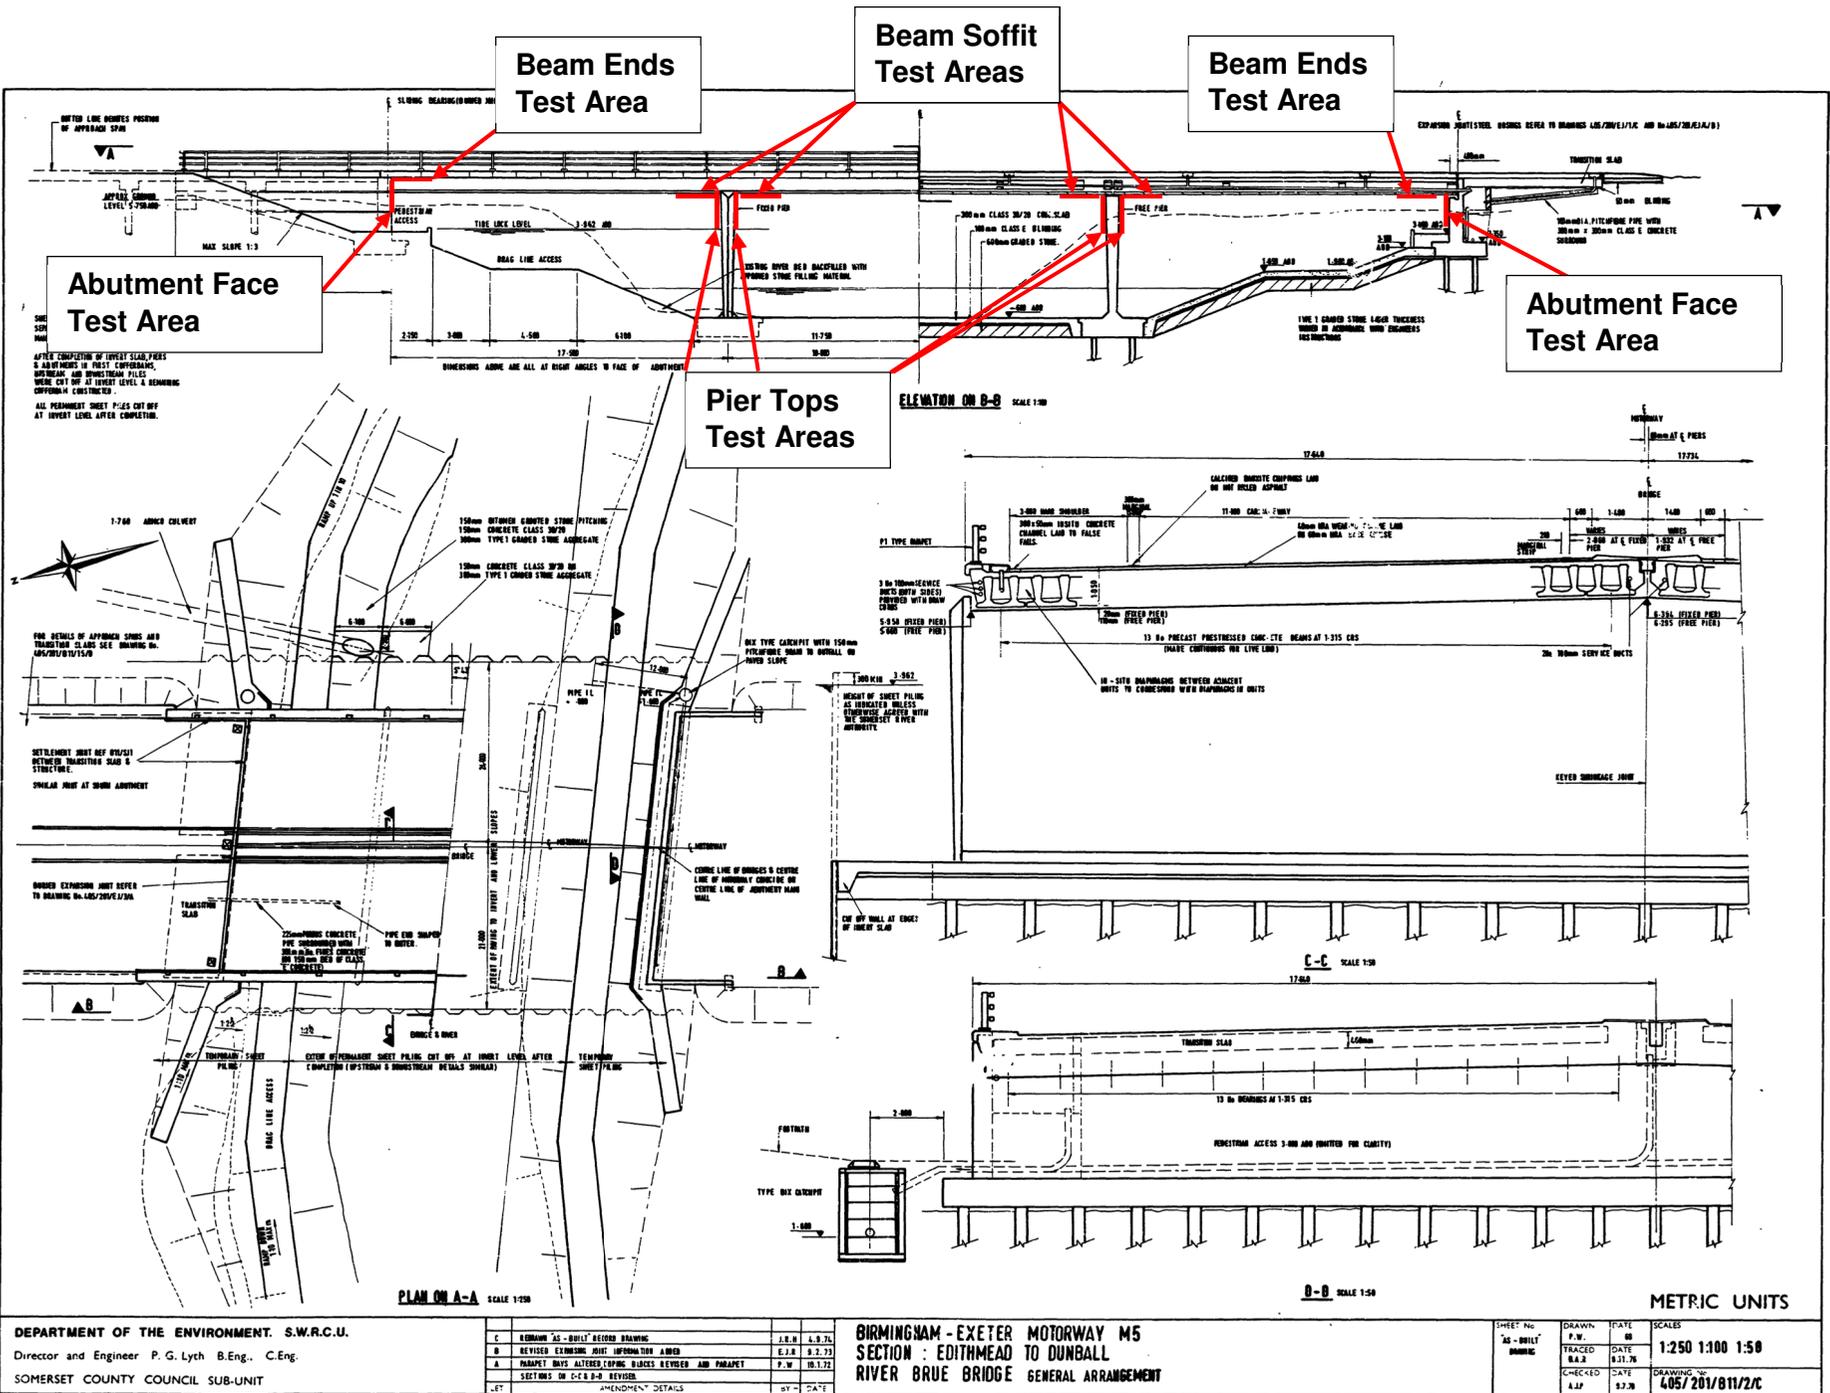

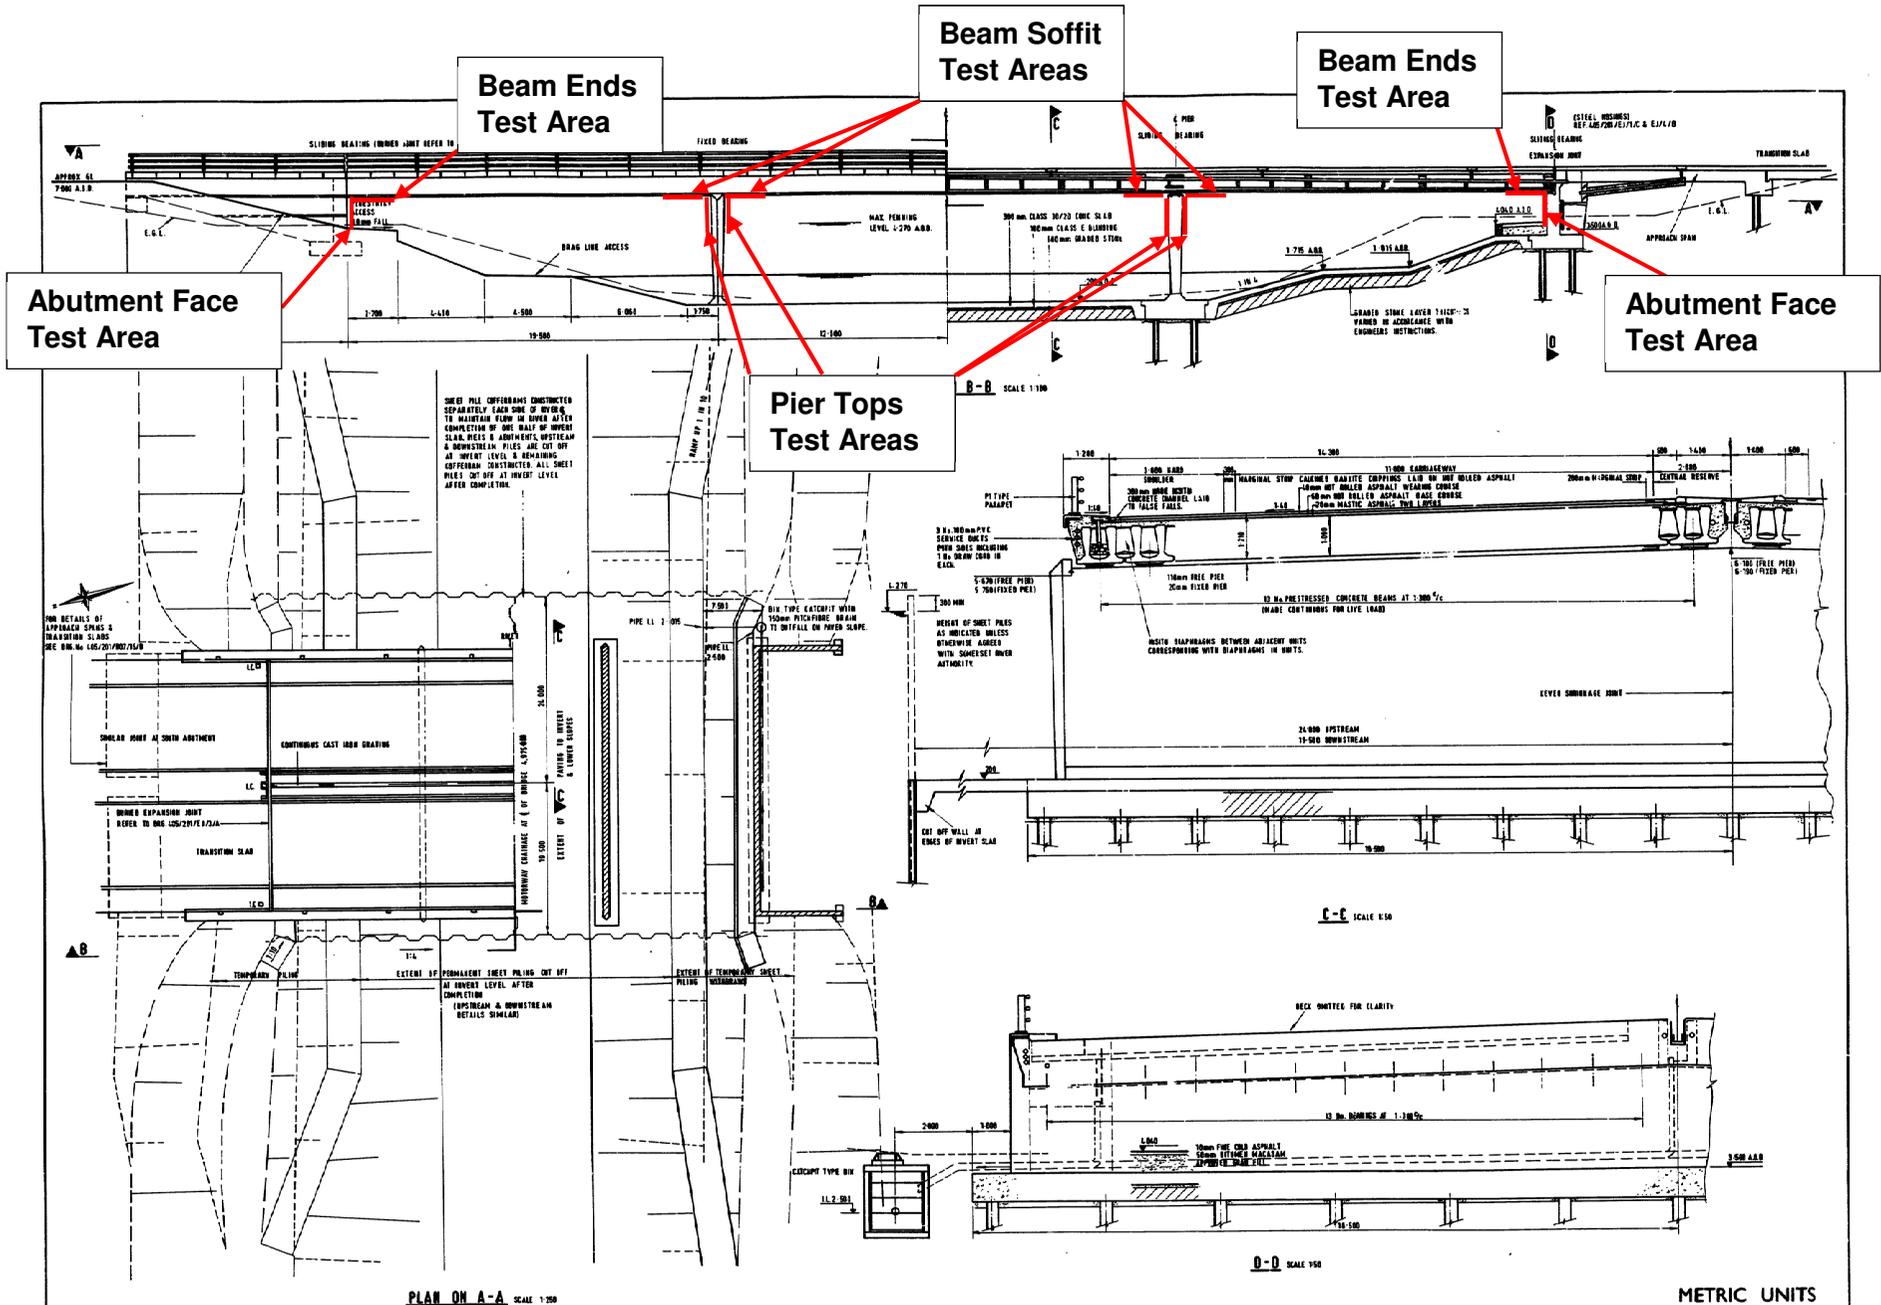

DEPARTMENT OF THE ENVIRONMENT, S.W.R.C.U.
 Director and Engineer P.G. Lyth B.Eng., C.Eng.
 SOMERSET COUNTY COUNCIL SUB-UNIT

REV	BY	DATE	DESCRIPTION
D	DE - DRAWN	1.0.18	AS-BUILT DRAWING
C	CONVENED	1.18	CONVENED JOINT PROPOSAL & APPROACH STABILISATION
B	DE	15.5.17	DELLS LINE ACCESS LEVELS & REINFORCING
A	DE	13.11.17	END PARAPET BAY AMENDED
LET			AMENDMENT DETAILS

BIRMINGHAM - EXETER MOTORWAY M5
SECTION : EDITHMEAD TO DUNBALL
HUNTSPELL RIVER BRIDGE

SHEET No.	DRAWN	DATE	SCALE
45-DMLT	P.B.E.	7.7.16	1:250 1:100 1:50
BRIDGES	TRACED	DATE	
	YES	REV. No.	
	CHECKED	DATE	
	A.I.P.	7.7.16	
		DRAWING No.	405/201/807/2/0

GENERAL ARRANGEMENT

METRIC UNITS