



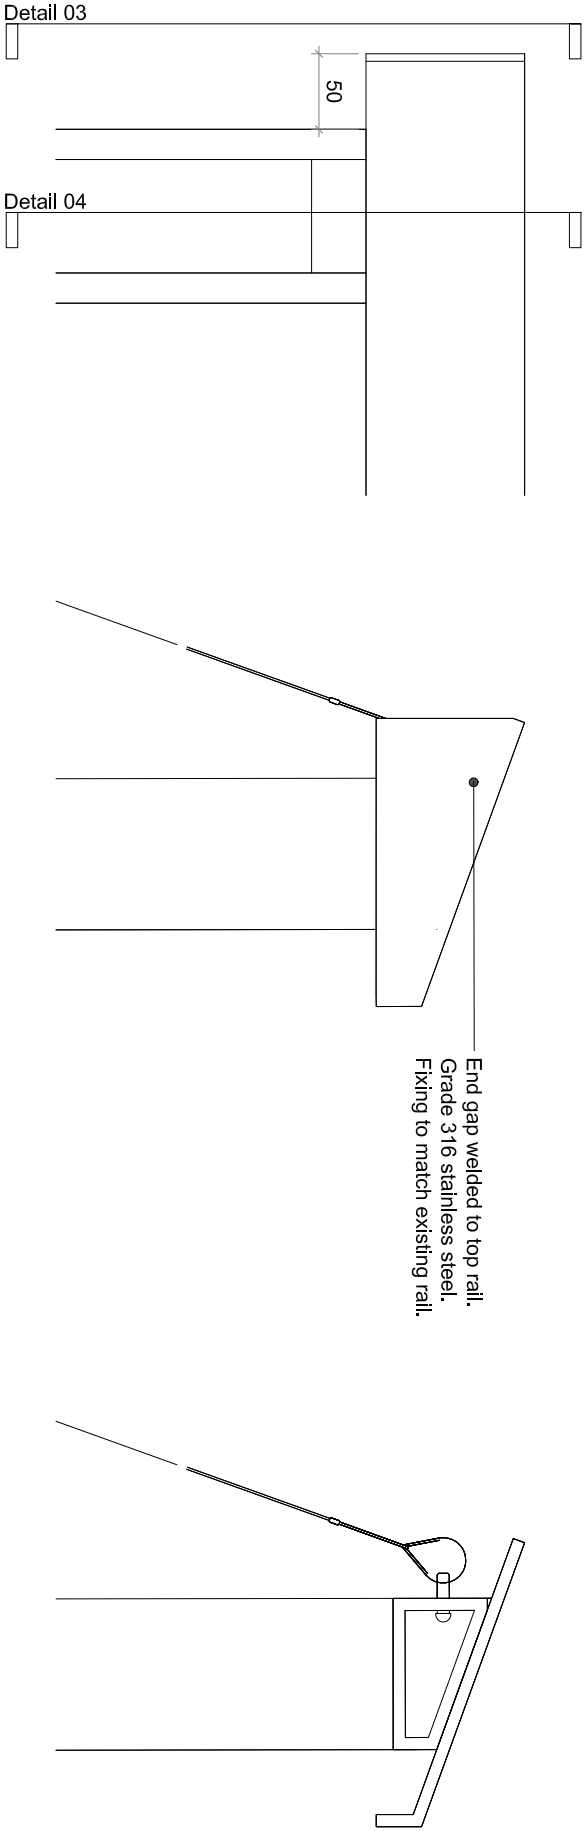

2 Parapet End Cap Elevation
Scale 1:5.

3 Parapet End Cap Elevation
Scale 1:5.

4 Parapet End Cap Section
Scale 1:5.

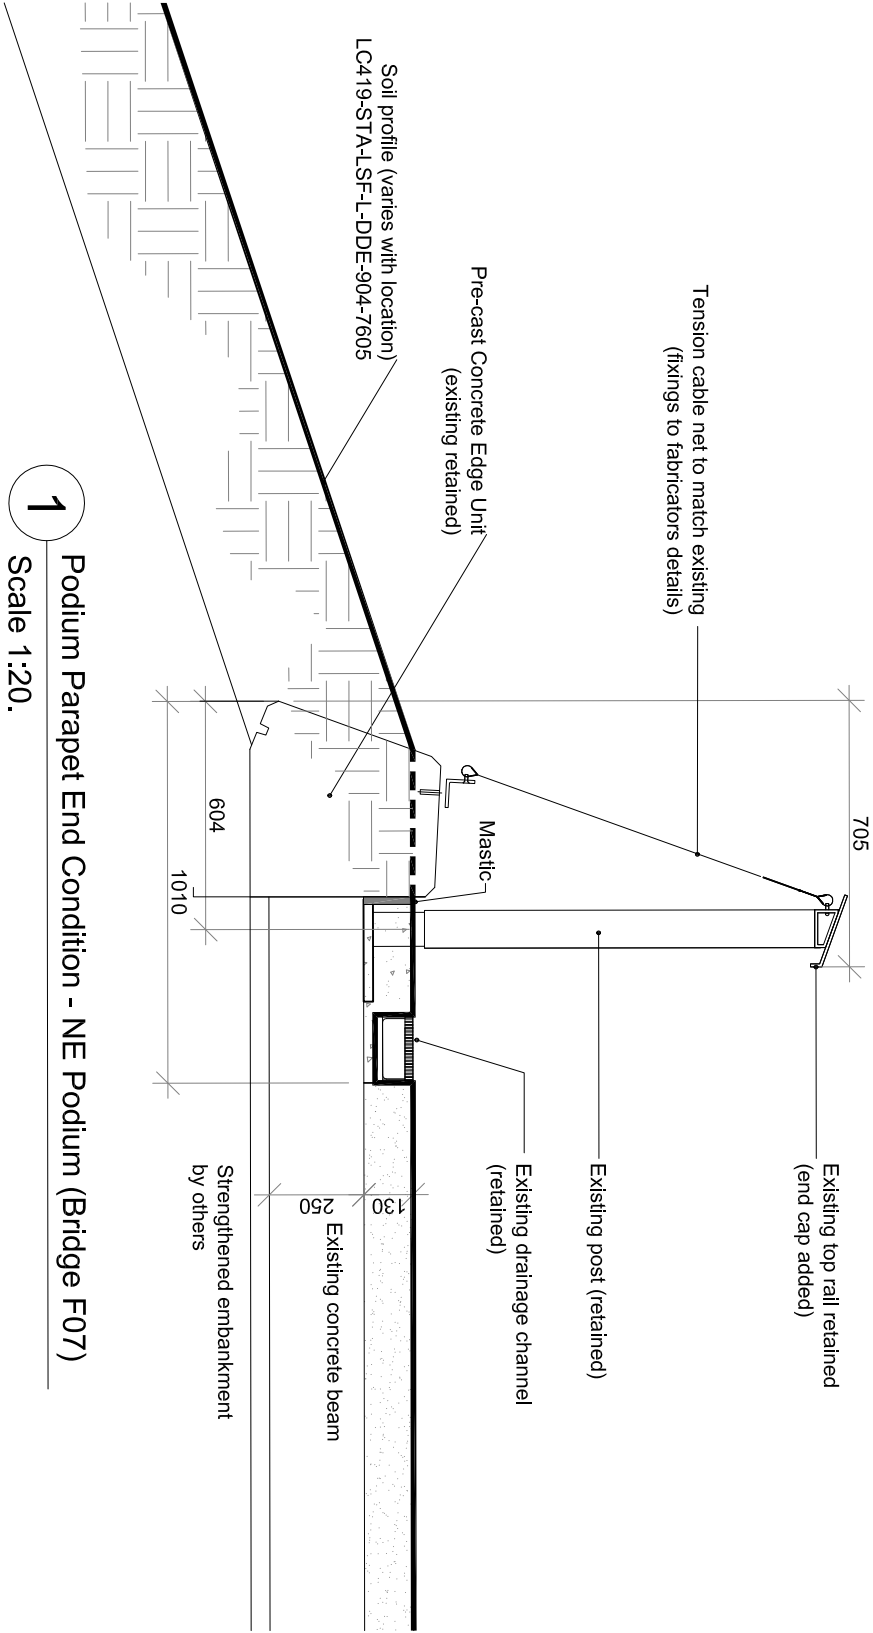

1 Podium Parapet End Condition - NE Podium (Bridge F07)
Scale 1:20.

NOTES: This drawing is the copyright of Hyland Edgar Driver. It must not be copied or reproduced without written consent. Only figured dimensions are to be taken from this drawing. The contractor must visit the site and be responsible for taking and checking all dimensions related to the works shown on this drawing.		SAFETY - HEALTH AND ENVIRONMENT INFORMATION Unusual residual hazards / risks Construction: Unusual Risks (list)/No unusual risks Operations: Unusual Risks (list)/No unusual risks Maintenance: Unusual Risks (list)/No unusual risks Dismantling/Demolition: Unusual Risks (list)/No unusual risks		REVISIONS P01 29/08/14 Issued for Tender C01 20/11/2014 Fit For Construction Z01 04/09/15 AS BUILT		DATE 20/11/2014 DRAWING STATUS AS BUILT PROJECT London Olympic Stadium Transformation DRAWING TITLE Podium Parapet End Condition - NE Podium DRAWING NUMBER LC419-STA-LHD-L-DDE-904-7516		DRAWN BY SS CHECKED BY AG SCALE at A3 1:20 REVISION Z01		H E D Hyland Edgar Driver Landscape Architects & Urban Designers London & Winchester Waterloo Court 10 Theed Street London SE1 8ST One Wessex Way Cadden Common Winchester SO21 1WG t. 020 7803 9636 t. 01962 711 600
--	--	---	--	---	--	--	--	--	--	---