


rev	date	amendment	dm
A	25.05.19	External Works shown	cad
B	10.06.19	Drainage ditch diverted. New linear drain to SE design.	cad
C	26.05.20	New kitchen-store made smaller	sk

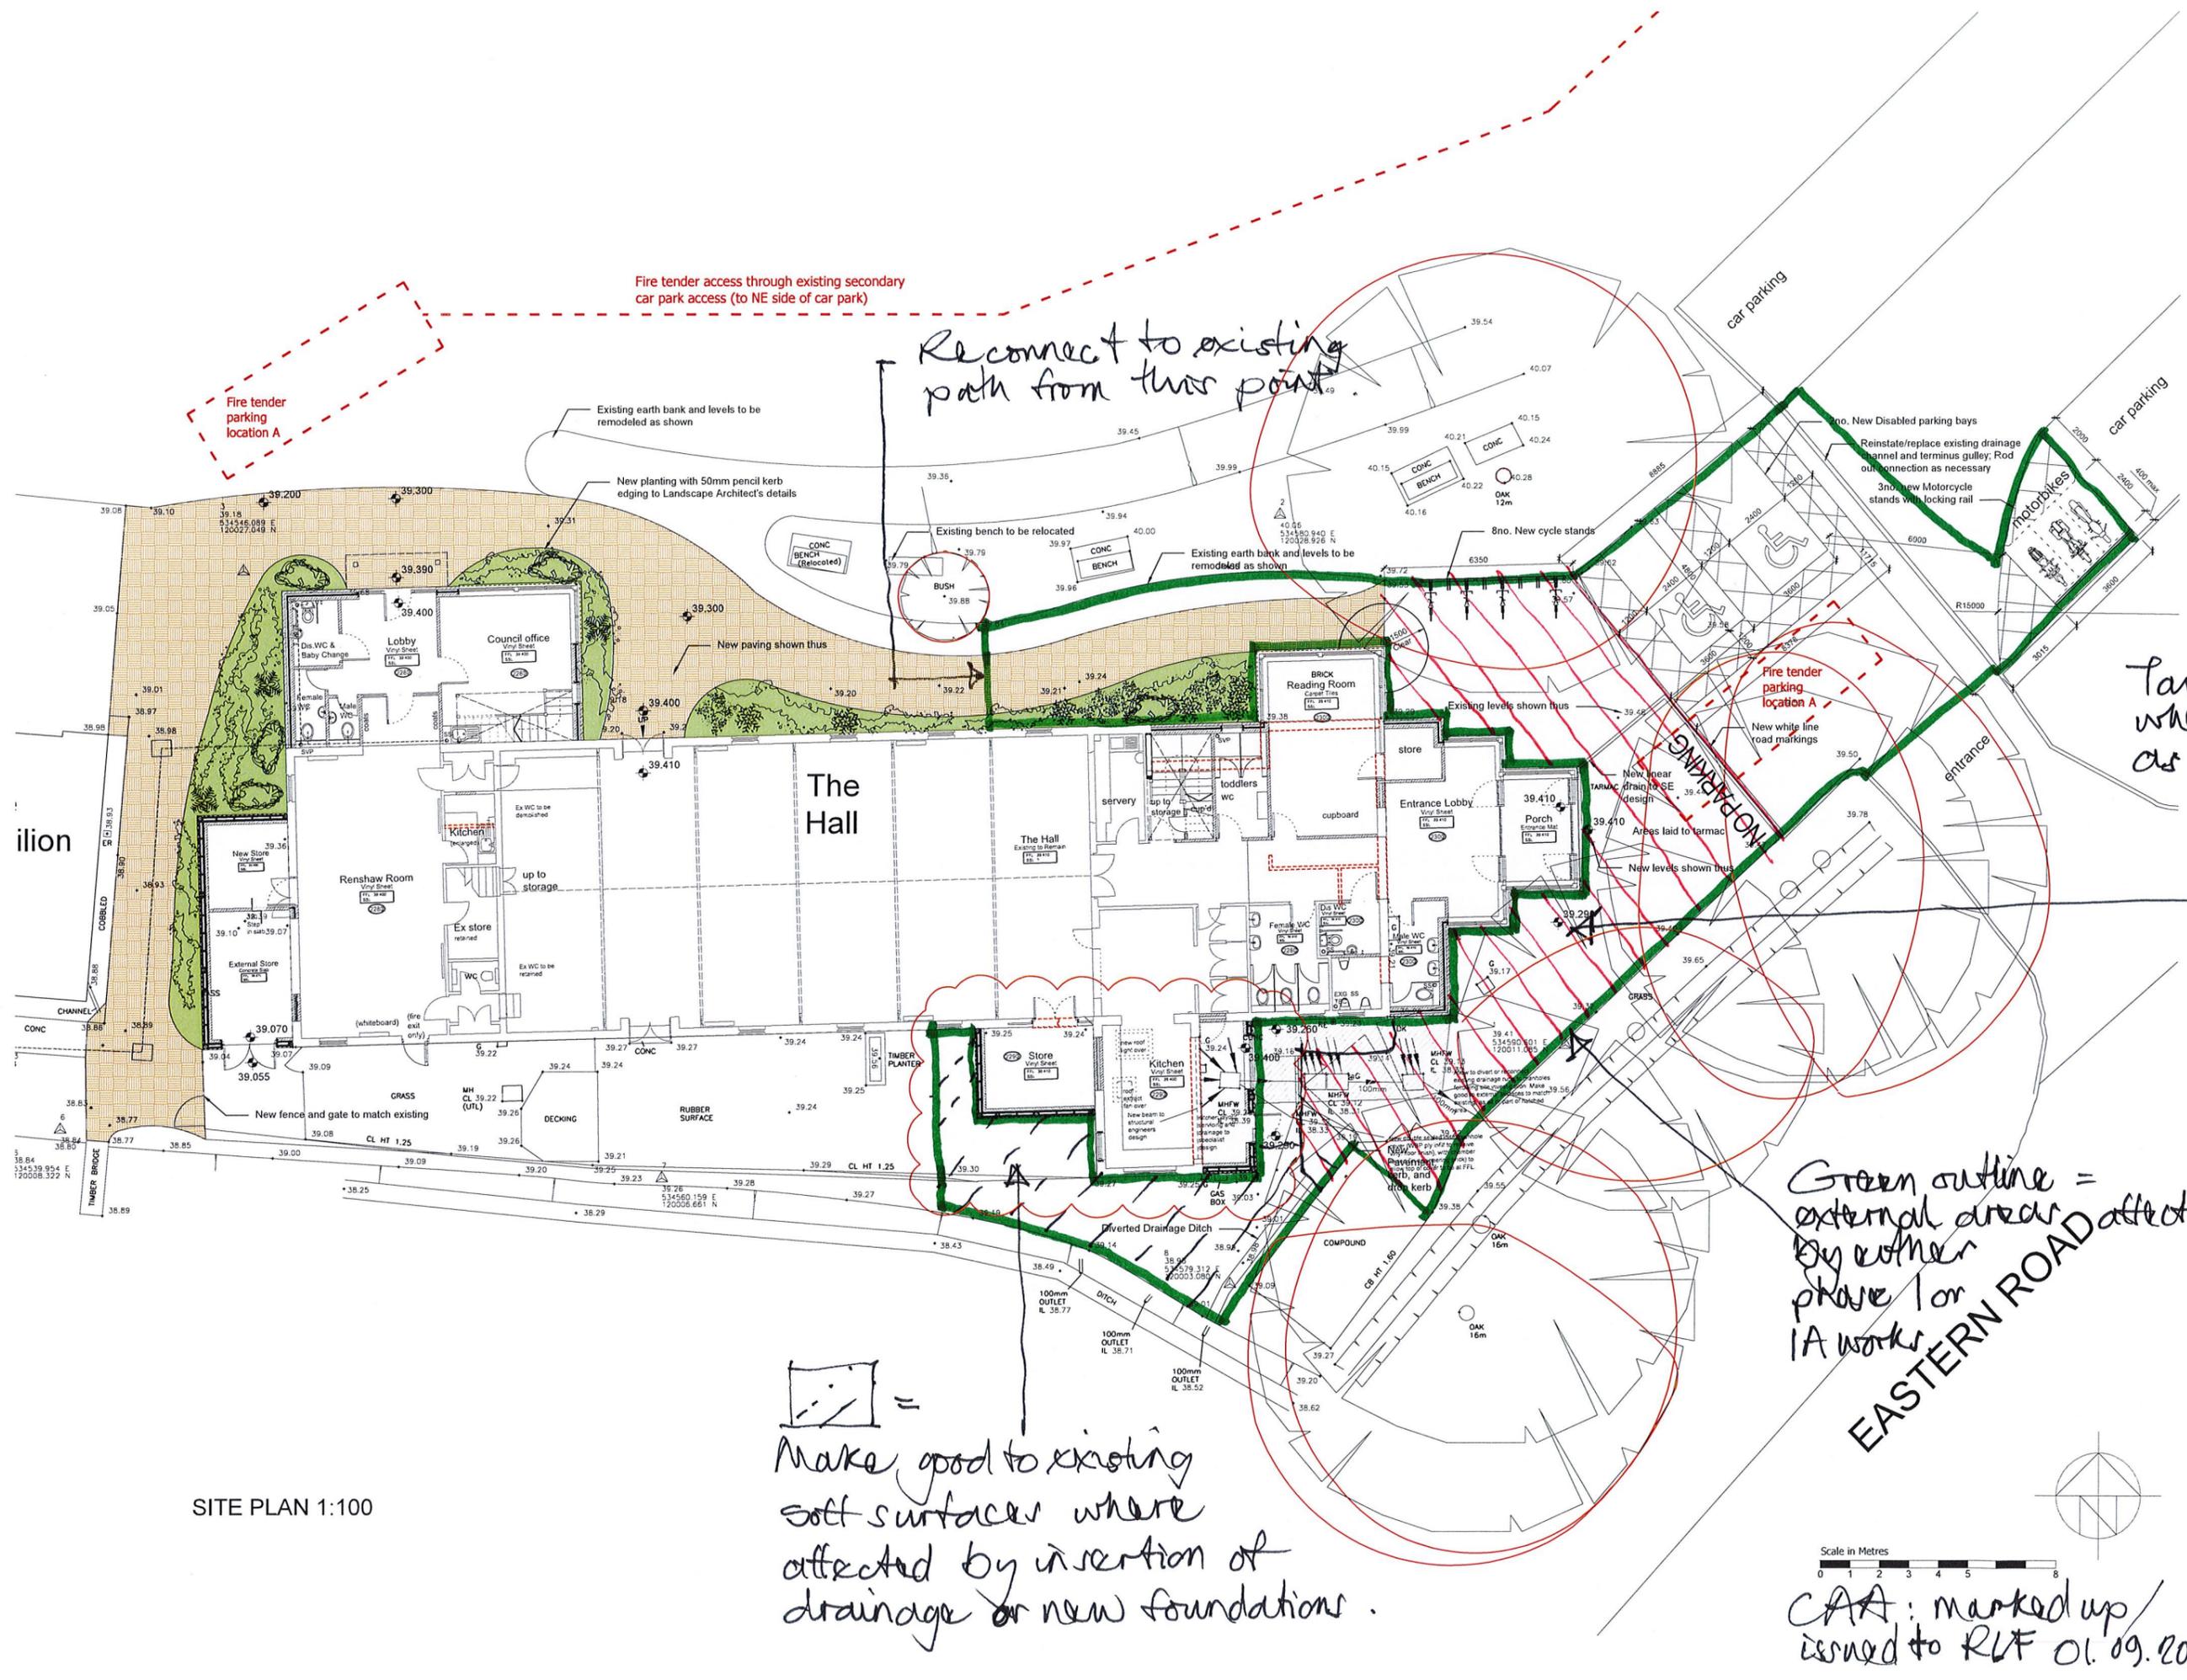

Fire tender access through existing secondary car park access (to NE side of car park)

Reconnect to existing path from this point.

Fire tender parking location A

Fire tender parking location A

Tarmac regraded where required as noted below.

Legend
 Tarmac regraded as necessary to suit new levels and drainage

 Marshalls Regent River Paving in 300X300 Stretcher Bond

Green outline = external areas affected by other phase 1 or IA works
EASTERN ROAD

 = Make good to existing soft surfaces where affected by insertion of drainage or new foundations.

GROWTHER ASSOCIATES
 ARCHITECTS
 CROWTHER ASSOCIATES ARCHITECTS LL
 25 PELHAM HOUSE
 BRIGHTON BN14ET
 T: 01273 695535
 www.crowtherassociates.co.uk

Client: Wivelsfield Village Hall
 Project: Wivelsfield Village Hall Extensions
 Drawing: GENERAL ARRANGEMENT SITE PLAN WITH EXTERNAL WORKS
 Date: May 2020
 Scale: 1:100 @ A1 CAD
 Drawn: gt
 Checked: gt

TENDER
 Job no: C-1732 (20)001
 Draw no: T1

Scale in Metres
 0 1 2 3 4 5 6 7 8
 CAA: marked up / issued to RLF 01.09.20

SITE PLAN 1:100