


Cofferdam drainage Points

Mark-up SK02
25.06.21

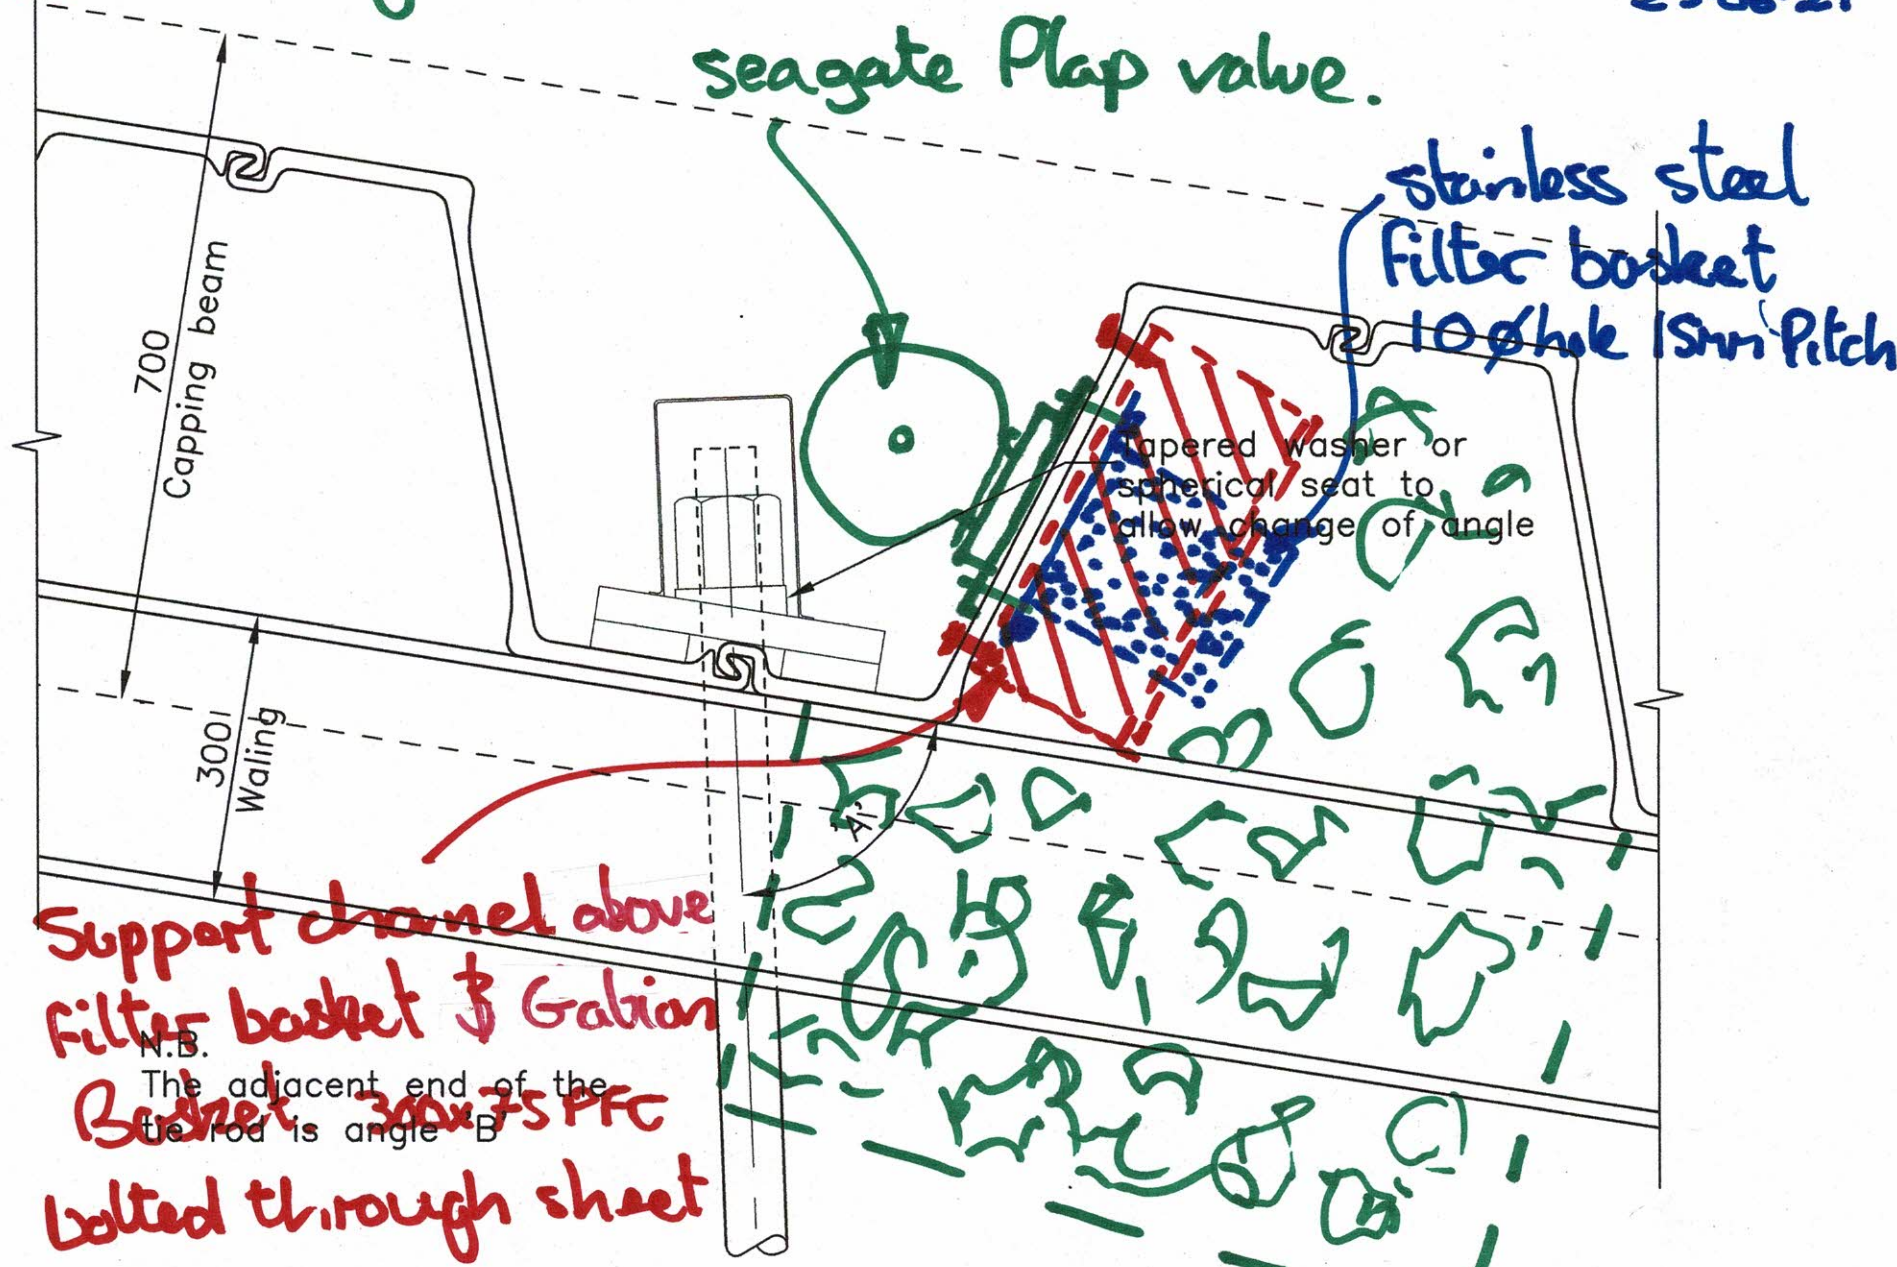

ped in
)

Support channel above
filter basket & Gabion
Basket. 300x75 PFC
bolted through sheet
Pile.

DETAIL 1
Scale 1:10

1M³ 6a Fill Gabion basket