



Mark-up skel 25.6.21
Cofferdam drainage
Repairs.

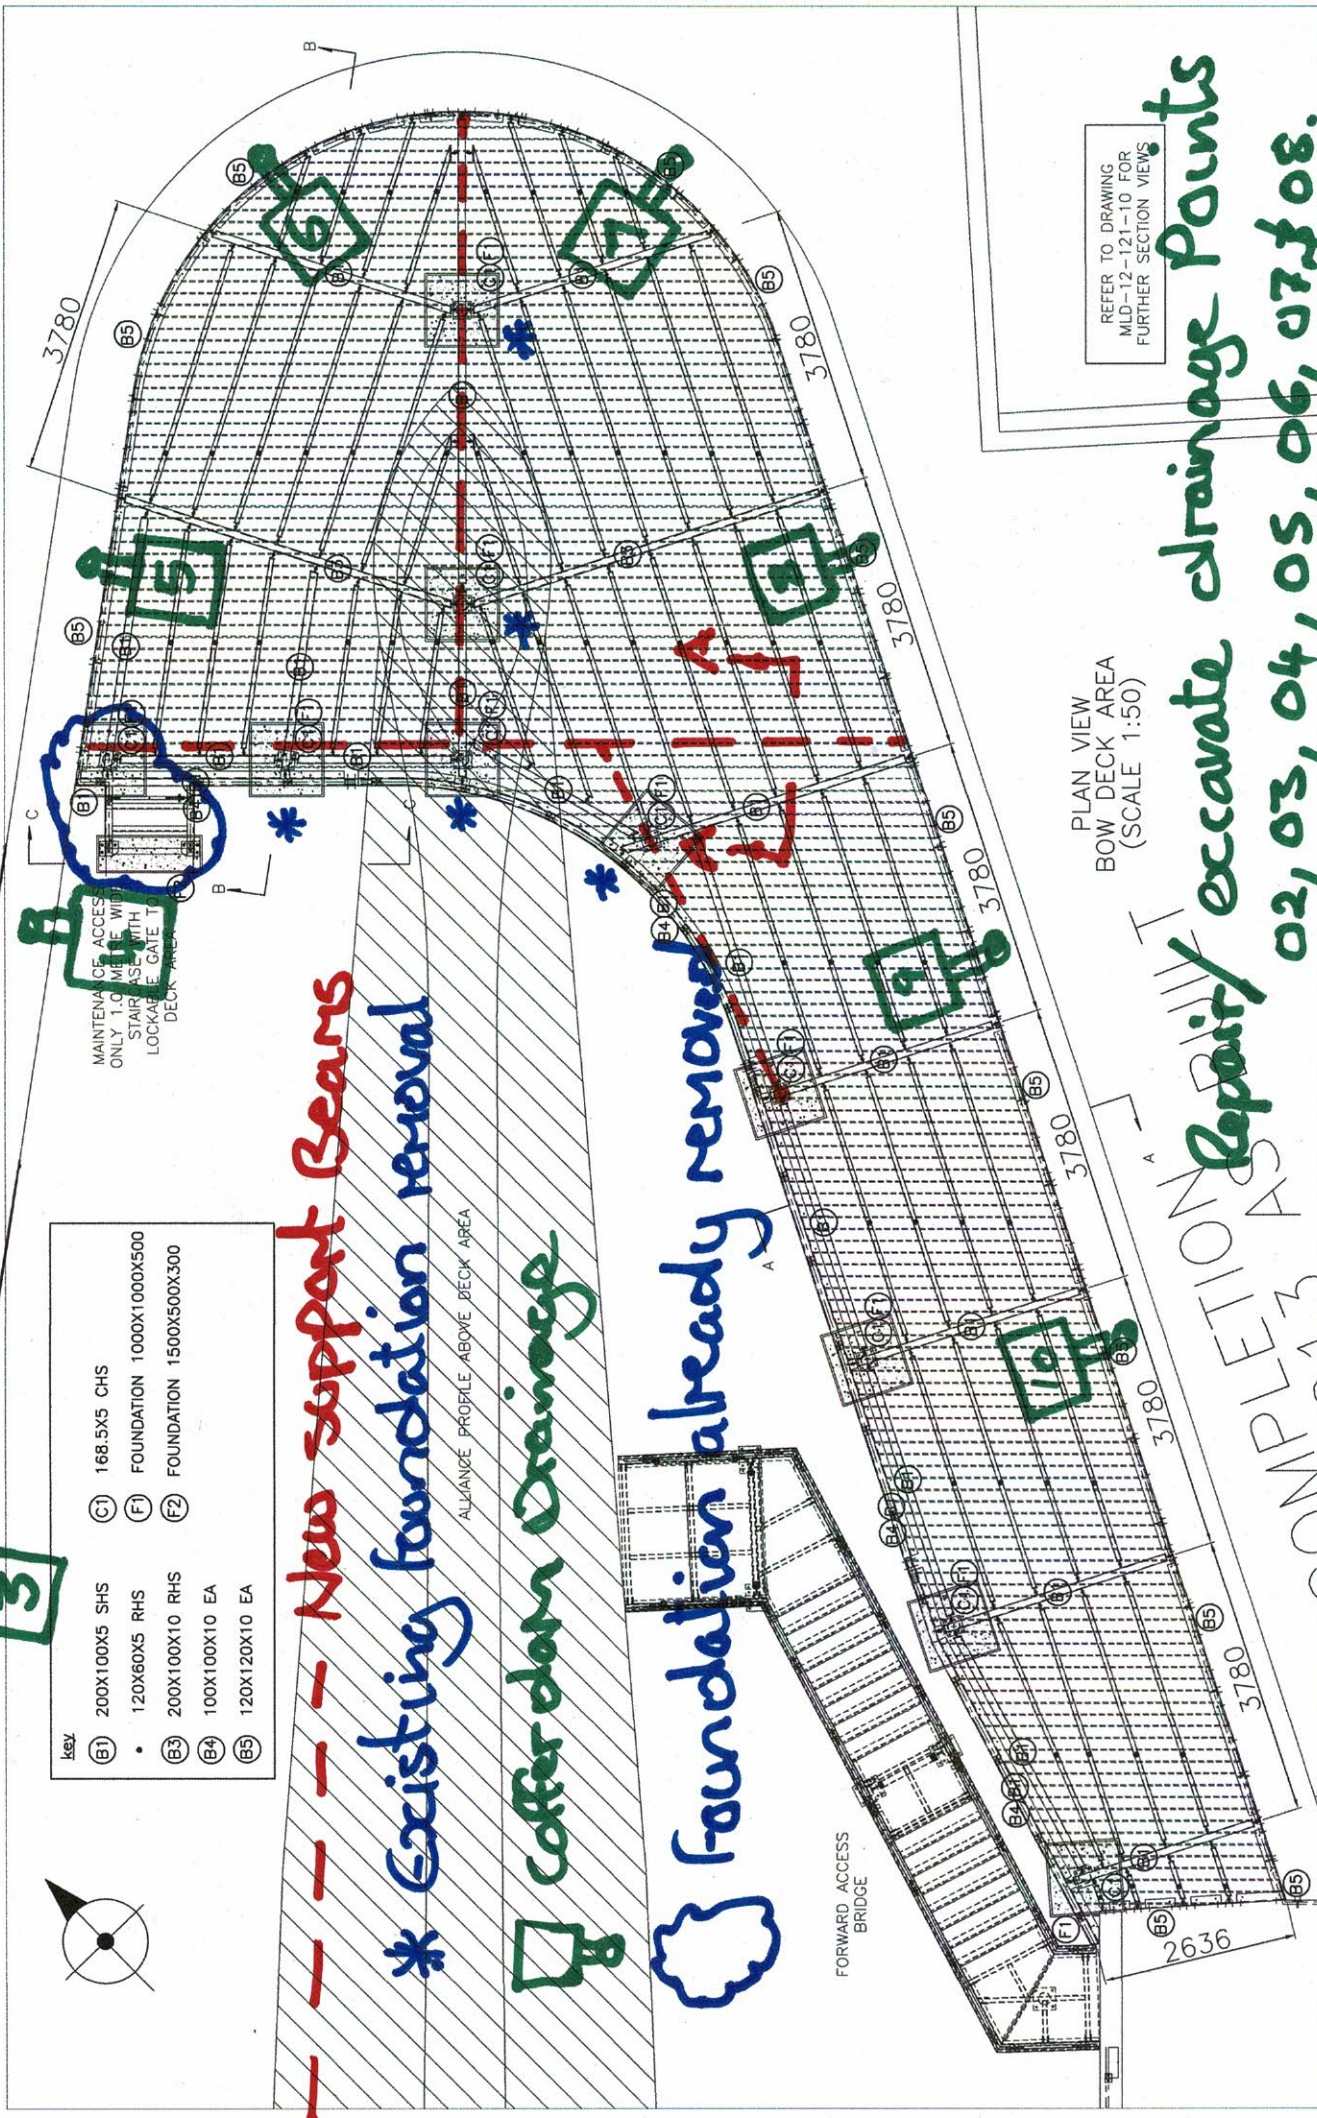

REFER TO DRAWING
MLD-12-121-10 FOR
FURTHER SECTION VIEWS

PLAN VIEW
BOW DECK AREA
(SCALE 1:50)

SECTION A-A
(SCALE 1:4)

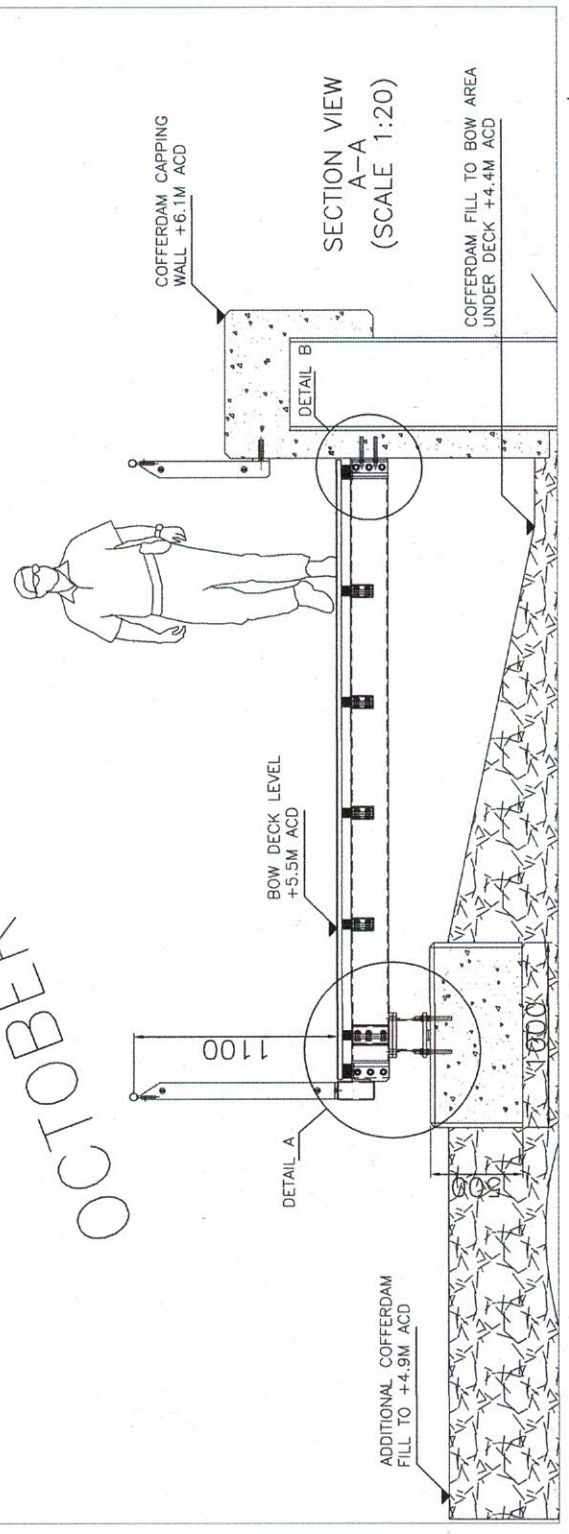

SECTION VIEW
A-A
(SCALE 1:20)

NOTES:

1. ALL DIMENSIONS ARE IN MM UNLESS OTHERWISE SHOWN
2. ALL MATERIAL STRUCTURAL SECTIONS GRADE S355, CLEATS AND BRACKETS S275
3. ALL WELDS TO BE 6MM CONTINUOUS UNLESS NOTED OTHERWISE
4. ALL WELDING TO BE IN ACCORDANCE WITH BS 5135
5. STEELWORK TO BE HOT DIP GALVANISED
6. ALL BOLT FIXINGS TO BE GALVANISED GRADE 8.8 MINIMUM

Deck area 5 kN/m^2 minimum