
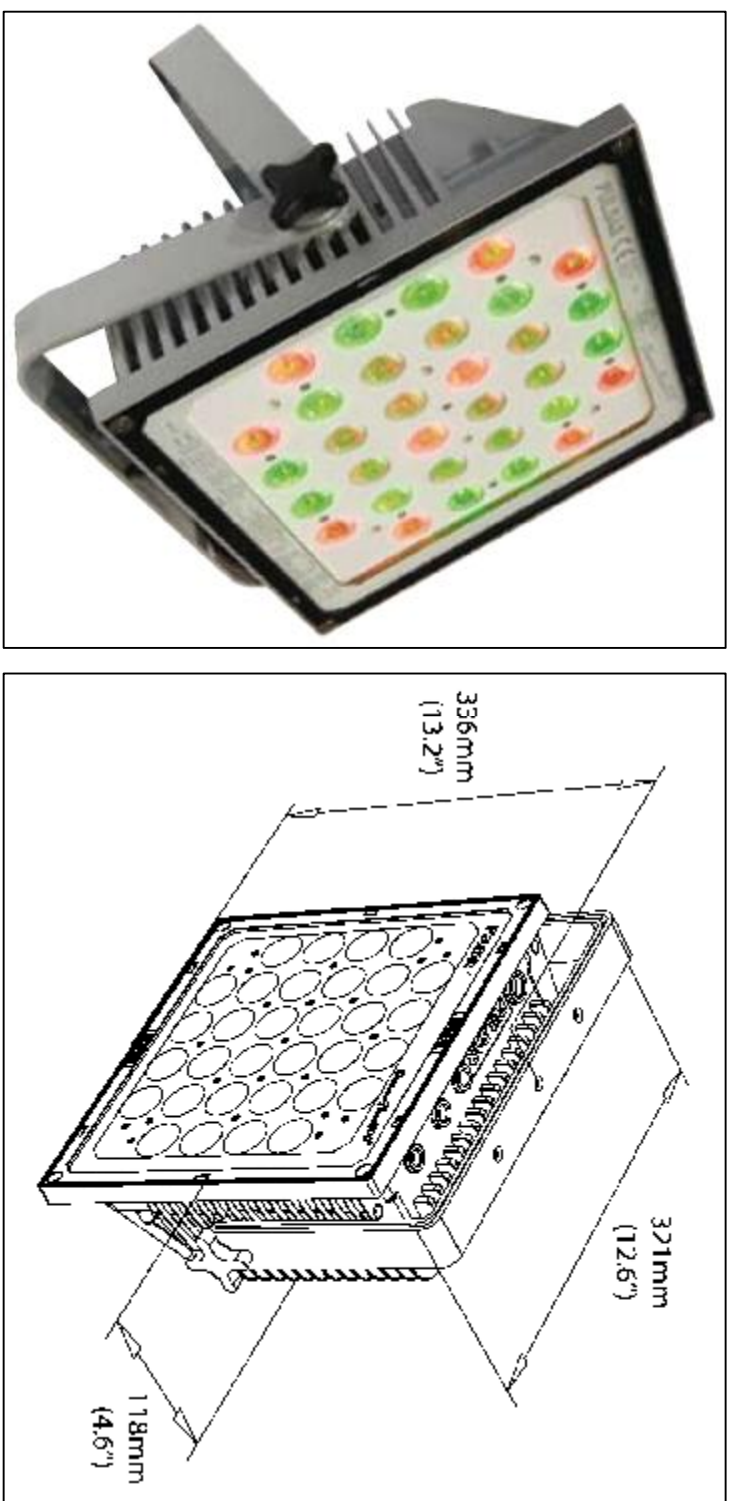
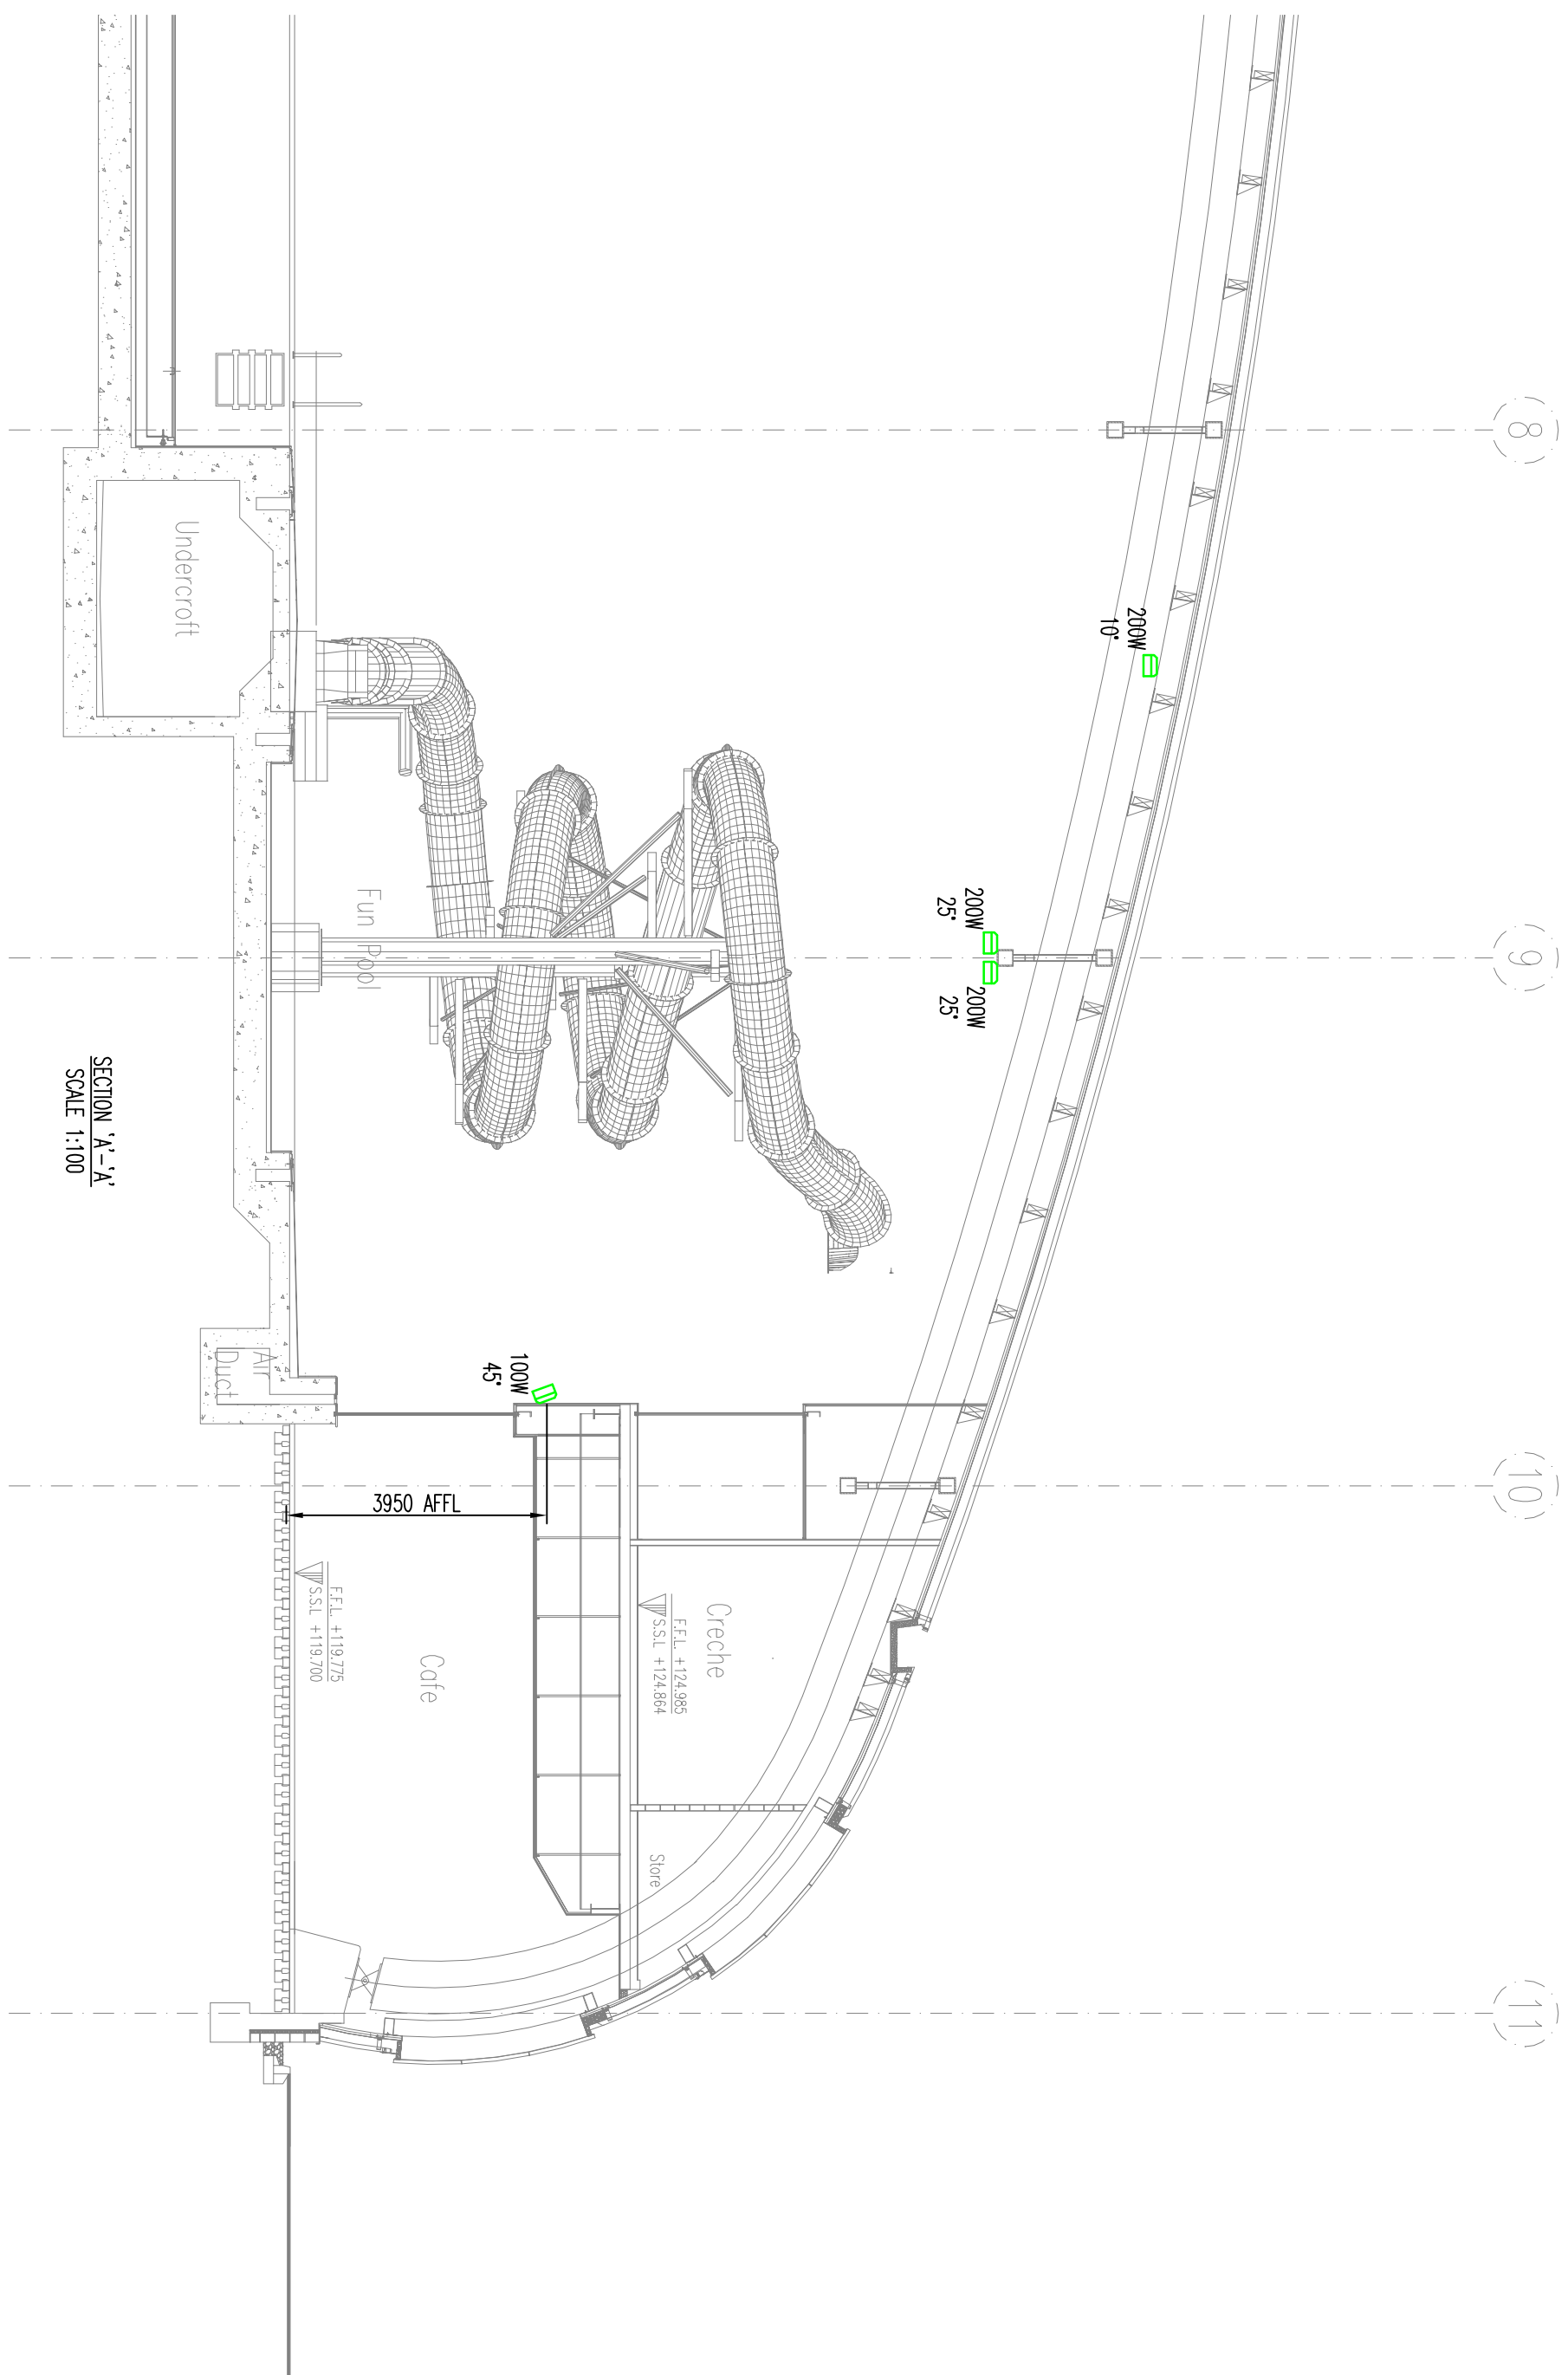


1. DO NOT SCALE THIS DRAWING.
2. DO NOT ALTER BY HAND.
3. THIS DRAWING IS TO BE READ IN CONJUNCTION WITH ALL OTHER RELEVANT DRAWINGS AND SPECIFICATIONS.
4. ALL DIMENSIONS ARE IN MILLIMETRES UNLESS STATED OTHERWISE.

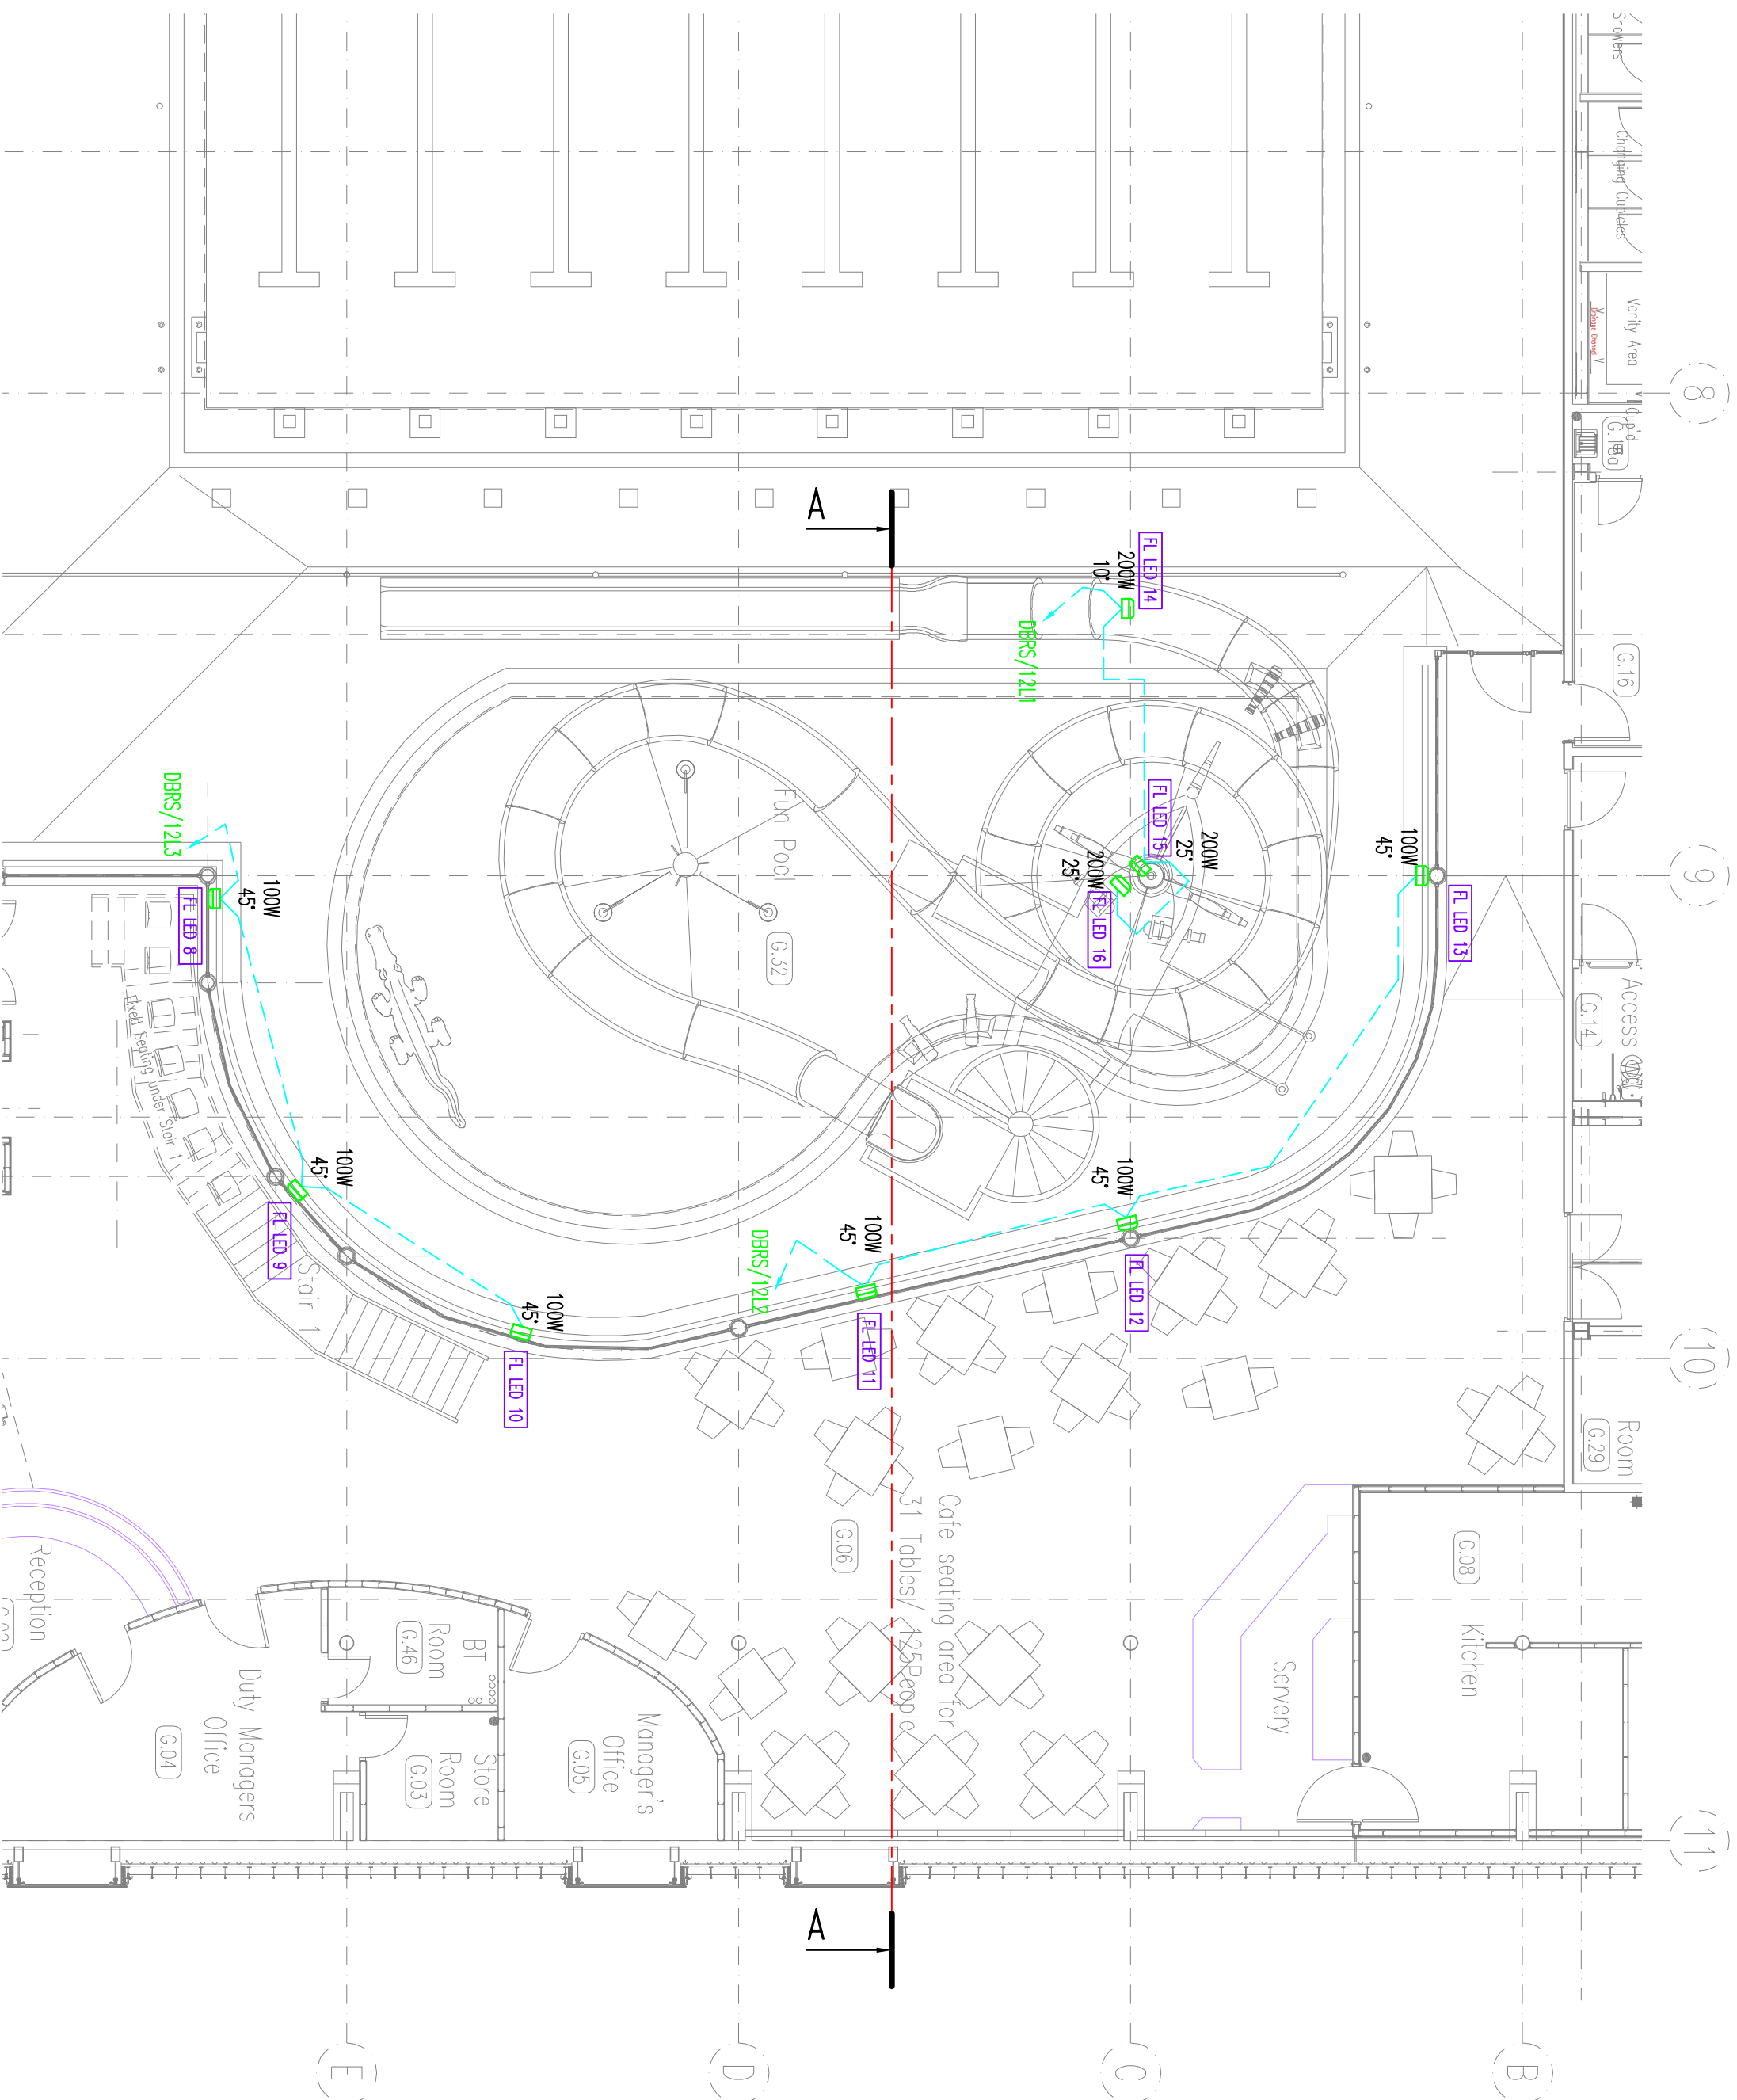

FUN POOL

THE LIGHTING OF THE CEILING FEATURE CARO NETTING AND THE EFFECT LIGHTING TO THE PRATE SHIP DECK IS PROVIDED BY SIX RGB COLOR CHANGE LED PROSCENIOR FLOODLIGHTS MOUNTED AS DETAILD ABOVE & NEAR THE AREA AROUND THE SHIP. THE PRATE SHIP AND THE CARO NETTING ARE SEPARATELY CONTROLLED BY TWO SWITCHES AT RECEPTION. THE LIGHTMARE ARE ADJUSTED AT COMMISSIONING TO PROVIDE THE DIFFERENT SCENES AS AGREED BY THE CLIENT.

THE LIGHTING OF THE BEACH AREA IS PROVIDED BY THREE RGB COLOUR CHANGE LED PROJECTION FLOODLIGHTS MOUNTED AS DETAILED OVER THE BEACH. THE BEACH IS SEPARATELY SWITCHED FROM RECEPTION. THE LUMINAIRES ARE ADJUSTED AT COMMISSIONING TO PROVIDE DIFFERENT SCENES AS AGREED WITH THE CLIENT.

As Inst.	As Installed Issue.	CAT	25/06/09
Rev.	Amendments	By	Date
Drawing Status: As Installed		Approval Status: N/A	



Corby East Midlands
International Swimming Pool

Fun Pool Feature Lighting

Drawn By:	C. Tomlinson	Engineer:	R. Dawson	Rec Copy Chk:
Primary Scale:	1:100	Size:	A1	Date Created:
Drawing Number:	106-E-164	Revison:	AI	