




**AS BUILT DRAWING
JULY 2009**

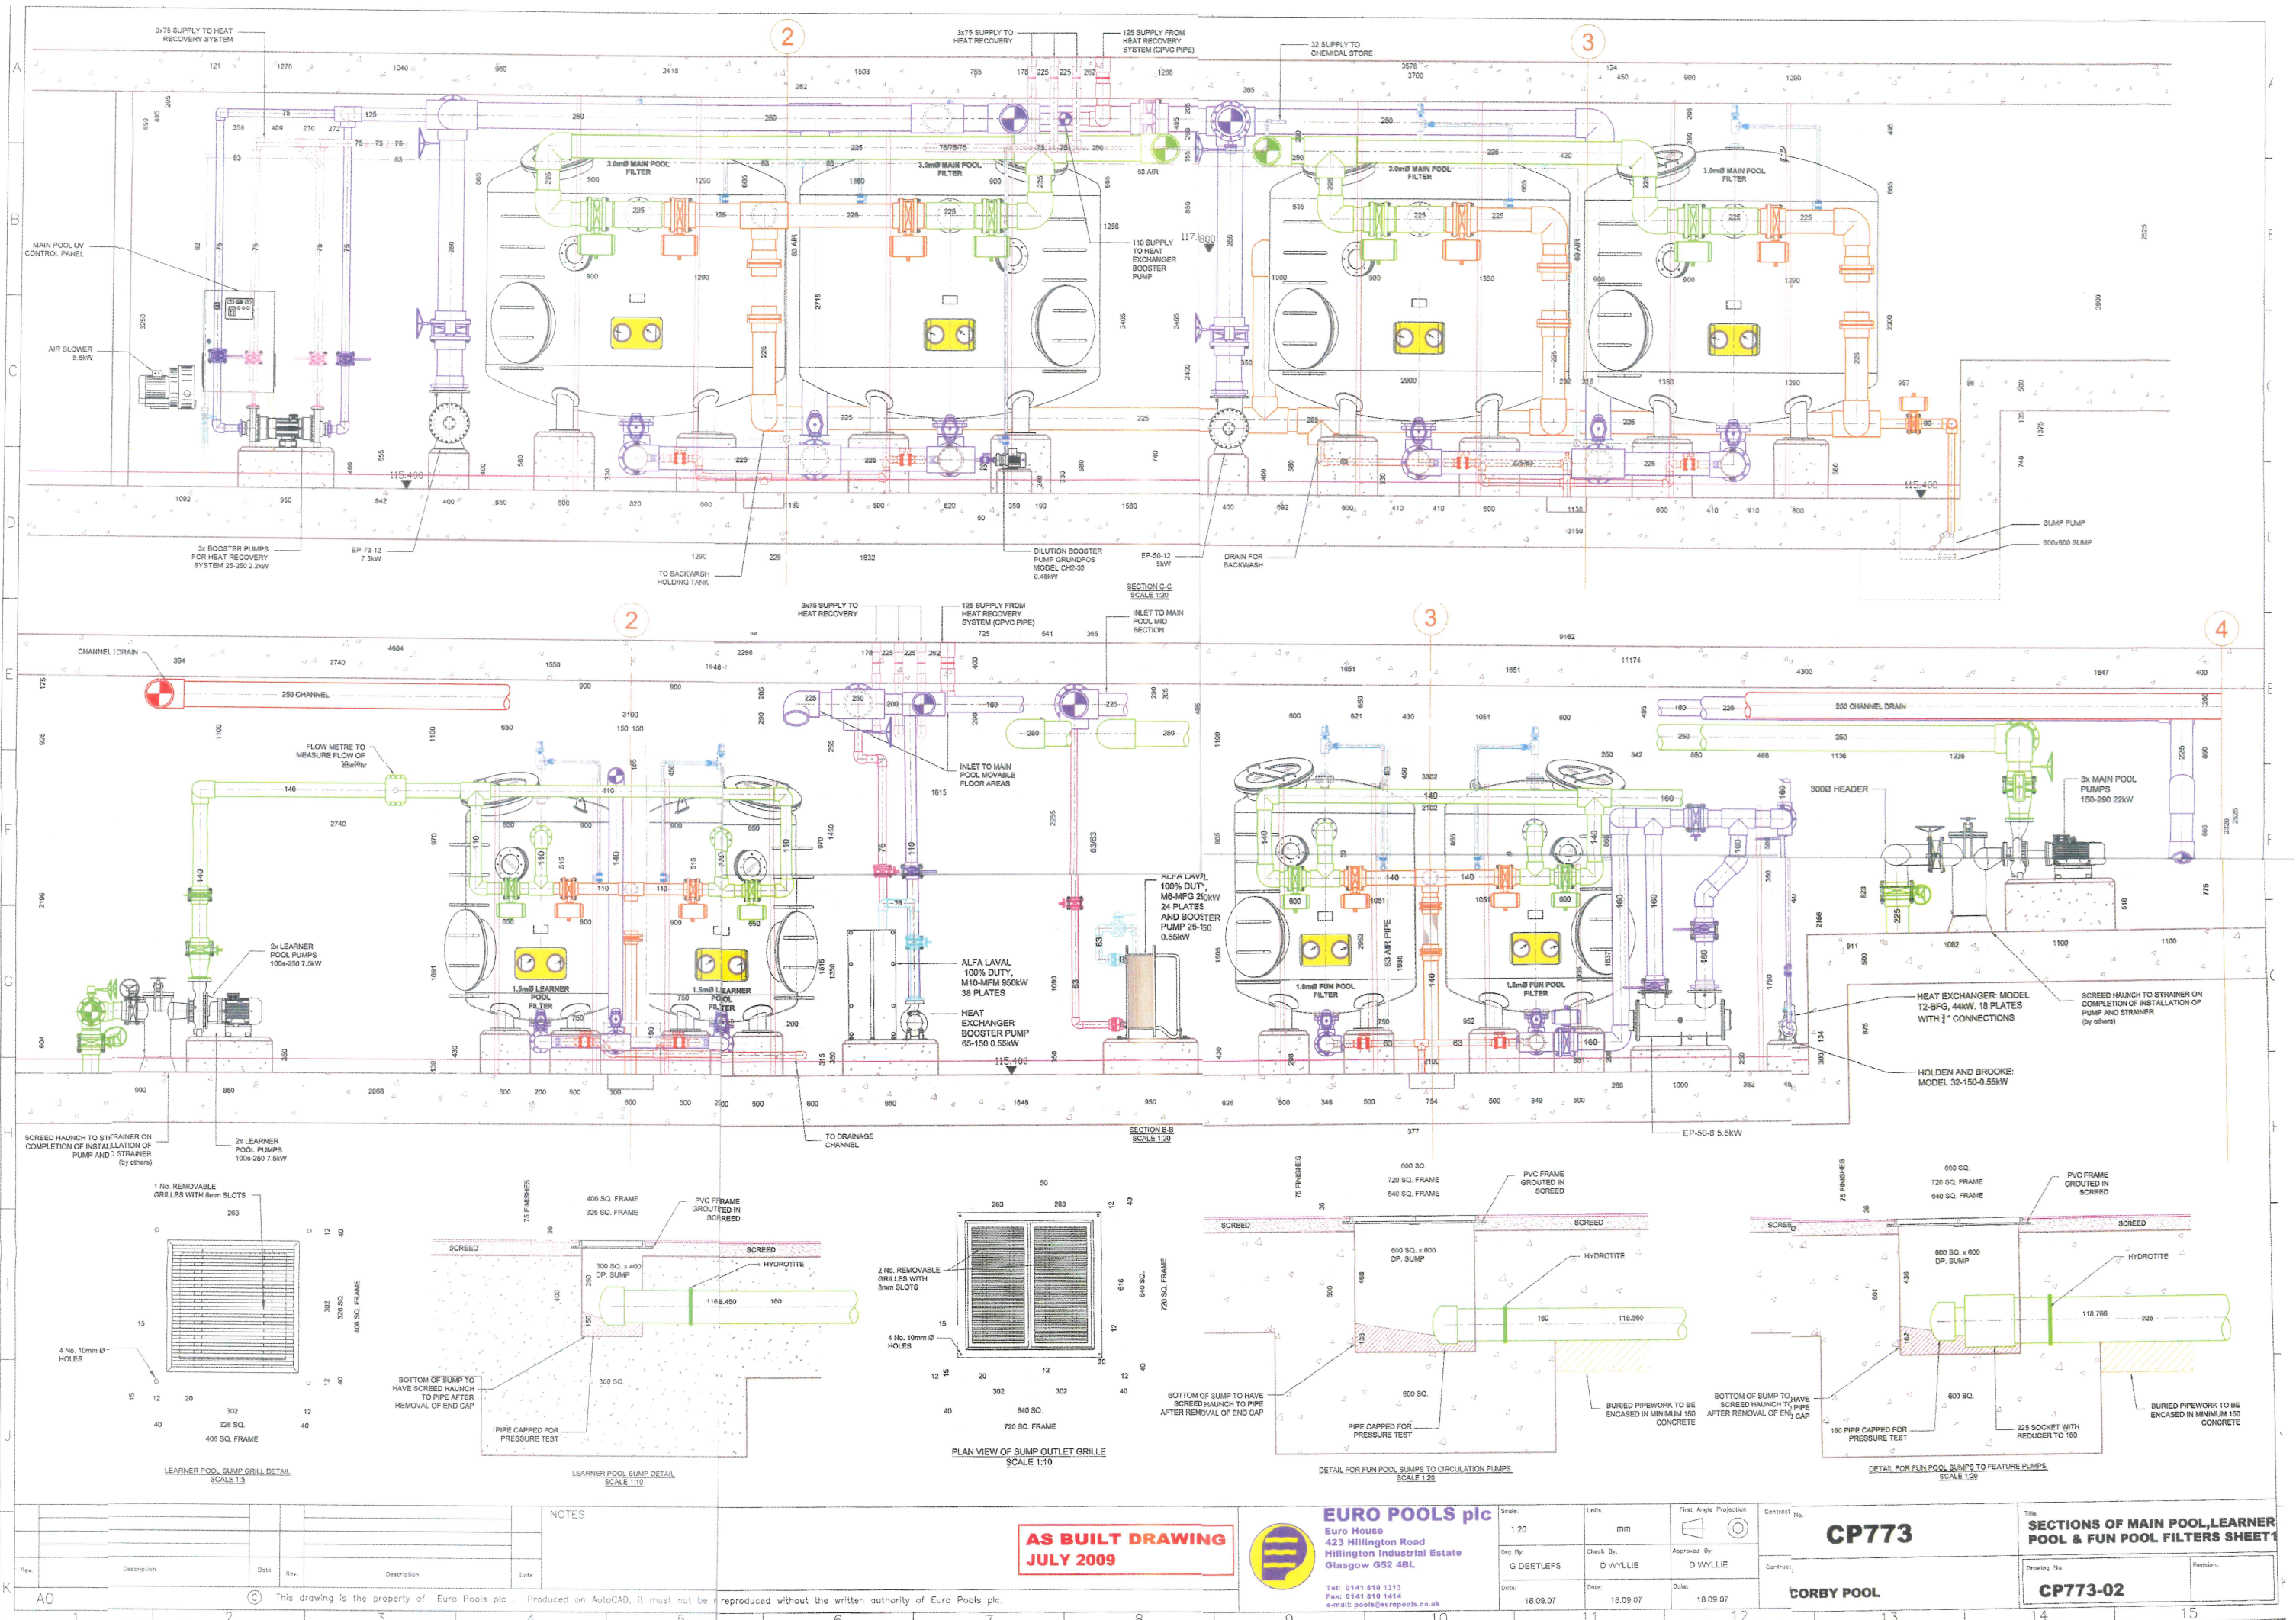

EURO POOLS plc
Euro House
423 Hillington Road
Hillington Industrial Estate
Glasgow G52 4BL
Tel: 0141 810 1313
Fax: 0141 810 1454
e-mail: pools@europools.co.uk

Scale:	1:20	Units:	mm	First Angle Projection	Contract No.
Drawn By:	G DEETLEFS	Check By:	D WYLLIE	Approved By:	D WYLLIE
Date:	18.09.07	Date:	18.09.07	Date:	18.09.07

CP773

CORBY POOL

SECTIONS OF MAIN POOL, LEARNER POOL & FUN POOL FILTERS SHEET 1	
Drawing No.	Revision:
CP773-02	

This drawing is the property of Euro Pools plc. Produced on AutoCAD, it must not be reproduced without the written authority of Euro Pools plc.