

**TOPOGRAPHICAL SURVEY LEGEND**

**GENERAL**

AV	AIR VALVE	LH	LAMP HOLE
BB	BOLISHA BEACON	LP	LAMP POST
Bdy	BOUNDARY	MK	MARKER POST
BH	BORHOLE	MS	MILE STONE
BL	BED LEVEL	NB	NOTICE BOARD
BO	BOLLARD	NP	NAME-PLATE
BS	BUS STOP	OSBM	ORDNANCE SURVEY BENCH MARK
BKW	BRICK WALL	OH	OVERHEAD
CATV	CABLE TELEVISION	PE	PENSTOCK
CG	CATTLE GRID	PM	PARKING METER
CH	CHANNEL LEVEL	PO	POST
Conc	CONCRETE	RB	RUBBISH BIN
CR	CORRUGATED	RS	ROAD SIGN
CO	COPING LEVEL	RTW	RETAINING WALL
CPS	CONC. PAVING SLABS	RWP	RAIN WATER PIPE
CR	CROWN LEVEL	SAP	SAPLING
CUL	CULVERT	SC	STOP COCK
DK	DROP KERB	SL	SOFT LEVEL
DP	DOWN PIPE	SVP	SOIL VENT PIPE
EB	ELECTRICITY BOX	SP	SIGN POST
EC	ELECTRICITY CABLE	STN	SURVEY STATION
EdmH	ELECTRICITY MANHOLE	SV	STOP VALVE
EP	ELECTRICITY POLE	SW	SURFACE WATER
EPY	ELECTRICITY Pylon	TB	TREE BOLE
ER	EARTHING ROD	TBM	TEMPORARY BENCH MARK
FI	FIRE HYDRANT	TCB	TELEPHONE CALL BOX
FLR	FLOOR LEVEL	TH	THRESHOLD
FM	FLOW METER	TL	TRAFFIC LIGHT
FB	FLOWER BED	TMH	TELEPHONE MANHOLE
FW	FOUL WATER	TOW	TOP OF WALL
GL	GROUND LEVEL	TP	TELEGRAPH POLE
GP	GATE POST	TS	TREE STUMP
GV	GAS VALVE	UG	UNDERGROUND
H	HIGH	VA	VALVE
HO	HOLE	VP	VENT PIPE
HW	HEADWALL	W	WIDE
IC	INSPECTION COVER	WL	WATER LEVEL
JB	JUNCTION BOX	WM	WATER METER
KL	KEEP LEFT ROAD SIGN	WO	WASH OUT
LB	LETTER BOX	WP	WOODEN POST
		WV	WATER VALVE

**FENCE TYPES**

BWF	BARBED WIRE FENCE	IWF	FENCE INTERWOVEN
CBF	CLOSE BOARDED FENCE	LUF	FENCE LARCH LAP
CLF	CHAINLINK FENCE	PAL	FENCE PALISADE FENCE
CPF	CHESTNUT PALING	PRF	POST & RAIL FENCE
CWF	FENCE CHICKEN WIRE	PWF	POST & WIRE FENCE
IRF	FENCE IRON RAILING	TR	TRELLIS

**TREE TYPES**

AA	ACACIA	ED	ELDER	OR	ORNAMENTAL
AH	ASH	EM	ELM	PE	PINE
AL	ALDER	FR	FIR	PD	POLLARDED
AN	ASPEN	HB	HORNBEEAM	PP	POPLAR
AP	APPLE	HC	HORSE CHESTNUT	SB	SILVER BIRCH
BH	BEECH	HN	HAWTHORN	SC	SWEET CHESTNUT
BL	BLACKTHORN	HY	HOLLY	SU	SPRUCE
BR	BIRCH	LA	LARCH	SY	SYCAMORE
CE	CHERRY	LE	LIME	WB	WHITEBEAM
CO	CONIFER	LN	LONDON PLANE	WT	WALNUT
CR	CEDAR	ME	MAPLE	WW	WILLOW
CY	CYPRESS	OK	OAK	YW	YEW
DD	DEAD			XX	UNKNOWN

**SERVICE ABBREVIATIONS**

AC	ASSUMED CONNECTION	IL	INVERT LEVEL
AR	ASSUMED ROUTE	KIG	KERB INLET GULLY
BD	BACK DROP	MH	MANHOLE
CC	CONFIRMED CONNECTION	OHL	OVER HEAD LINE
CD	CHAMBER DEPTH	PI	PETROL INTERCEPTOR
COW	CABLE ON WALL	RD	FROM RECORD DRAWINGS
C	COVER LEVEL	ROD	RODING EYE
CP	CATCH PIT	SK	SOAKAWAY
CB	CABLE RISER	TPT	TRACED POINT
DTB	DEPTH TO BASE	UNK	UNKNOWN SERVICE
D	DEPTH	UTL	UNABLE TO LOCATE
(db)	DISUSED	UTR	UNABLE TO RAISE
EOT	END OF TRACE	UTT	UNABLE TO TRACE
GU	GULLY	UTS	UNABLE TO SURVEY

**UTILITY LEGEND AND NOTES**

**UTILITY DEPTHS**

SERVICES ARE DRAWN IN 3D WITH THE LEVEL CORRESPONDING TO THE CENTRE OF THE UTILITY. EXCEPTIONS TO THIS ARE DETECTED BY GPR WHERE THE LEVEL IS THAT OF THE TOP OF THE UTILITY. THESE ARE DENOTED BY GPR LAYERS OR LINETYPES SHOWN ABOVE OR BY SPECIFIC LABELLING OF THE DRAWINGS.

**CAUTIONARY NOTES**

ELECTRO-DETECTION TECHNIQUES HAVE BEEN USED IN THE LOCATION OF UNDERGROUND SERVICES. THE RESULTS ARE NOT INFALLIBLE AND TRIAL EXCAVATIONS MUST BE CARRIED OUT TO CONFIRM SERVICE IDENTIFICATION. POSITIONS AND PARTICULARLY DEPTHS. ALTHOUGH ALL REASONABLE EFFORT HAS BEEN MADE IN SEARCHING AVAILABLE RECORD DRAWINGS. THE COMPLETENESS OF THE UNDERGROUND SERVICE INFORMATION CANNOT BE GUARANTEED. INFORMATION OBTAINED BY GPR IS INDICATIVE OF BURIED INFRASTRUCTURE THAT MAY NOT BE DETECTABLE BY OTHER MEANS.

**DRAINAGE NOTES**

PIPES ON THE REPORT ARE REFERENCED CLOCKWISE FROM THE OUTGOING PIPE WITH THE MH NUMBER AS THE PREFIX I.E. MH01A. END POINT LOCATIONS WITHIN BUILDINGS ARE INDICATIVE UNLESS STATED.

Note: Pipe sizes in mm

**TECHNICAL NOTES**

ALL LEVELS ARE BASED ON ORDNANCE SURVEY DATUM OBTAINED FROM ACTIVE GPS NETWORK 'OSGB36/15'

GRSD IS BASED ON OS DATUM. OBTAINED FROM ACTIVE GPS NETWORK 'OSGB36/15'

ALL KERB LEVELS ARE TAKEN IN CHANNEL.

A SCALE FACTOR OF 1.000000 HAS BEEN APPLIED TO THIS DRAWING

Rev.	Date	Description	By
A	SEPT 21	ADDITIONAL SECTIONS AND ELEVATIONS ADDED	CH

Drawn by: X.X.X. Surveyed by: X.X.X. Checked by: X.X.X.

**SURVEY DESIGN SERVICES**

Project title: WHITSTABLE MUSEUM

Drawing title: SECTIONS AND ELEVATIONS AND SECTION A-A



Client: AR DESIGN

Drawing No: SDS 206247-05 Revision: A

Scale 1:50 Date: SEPT 2021 Sheet size: A1





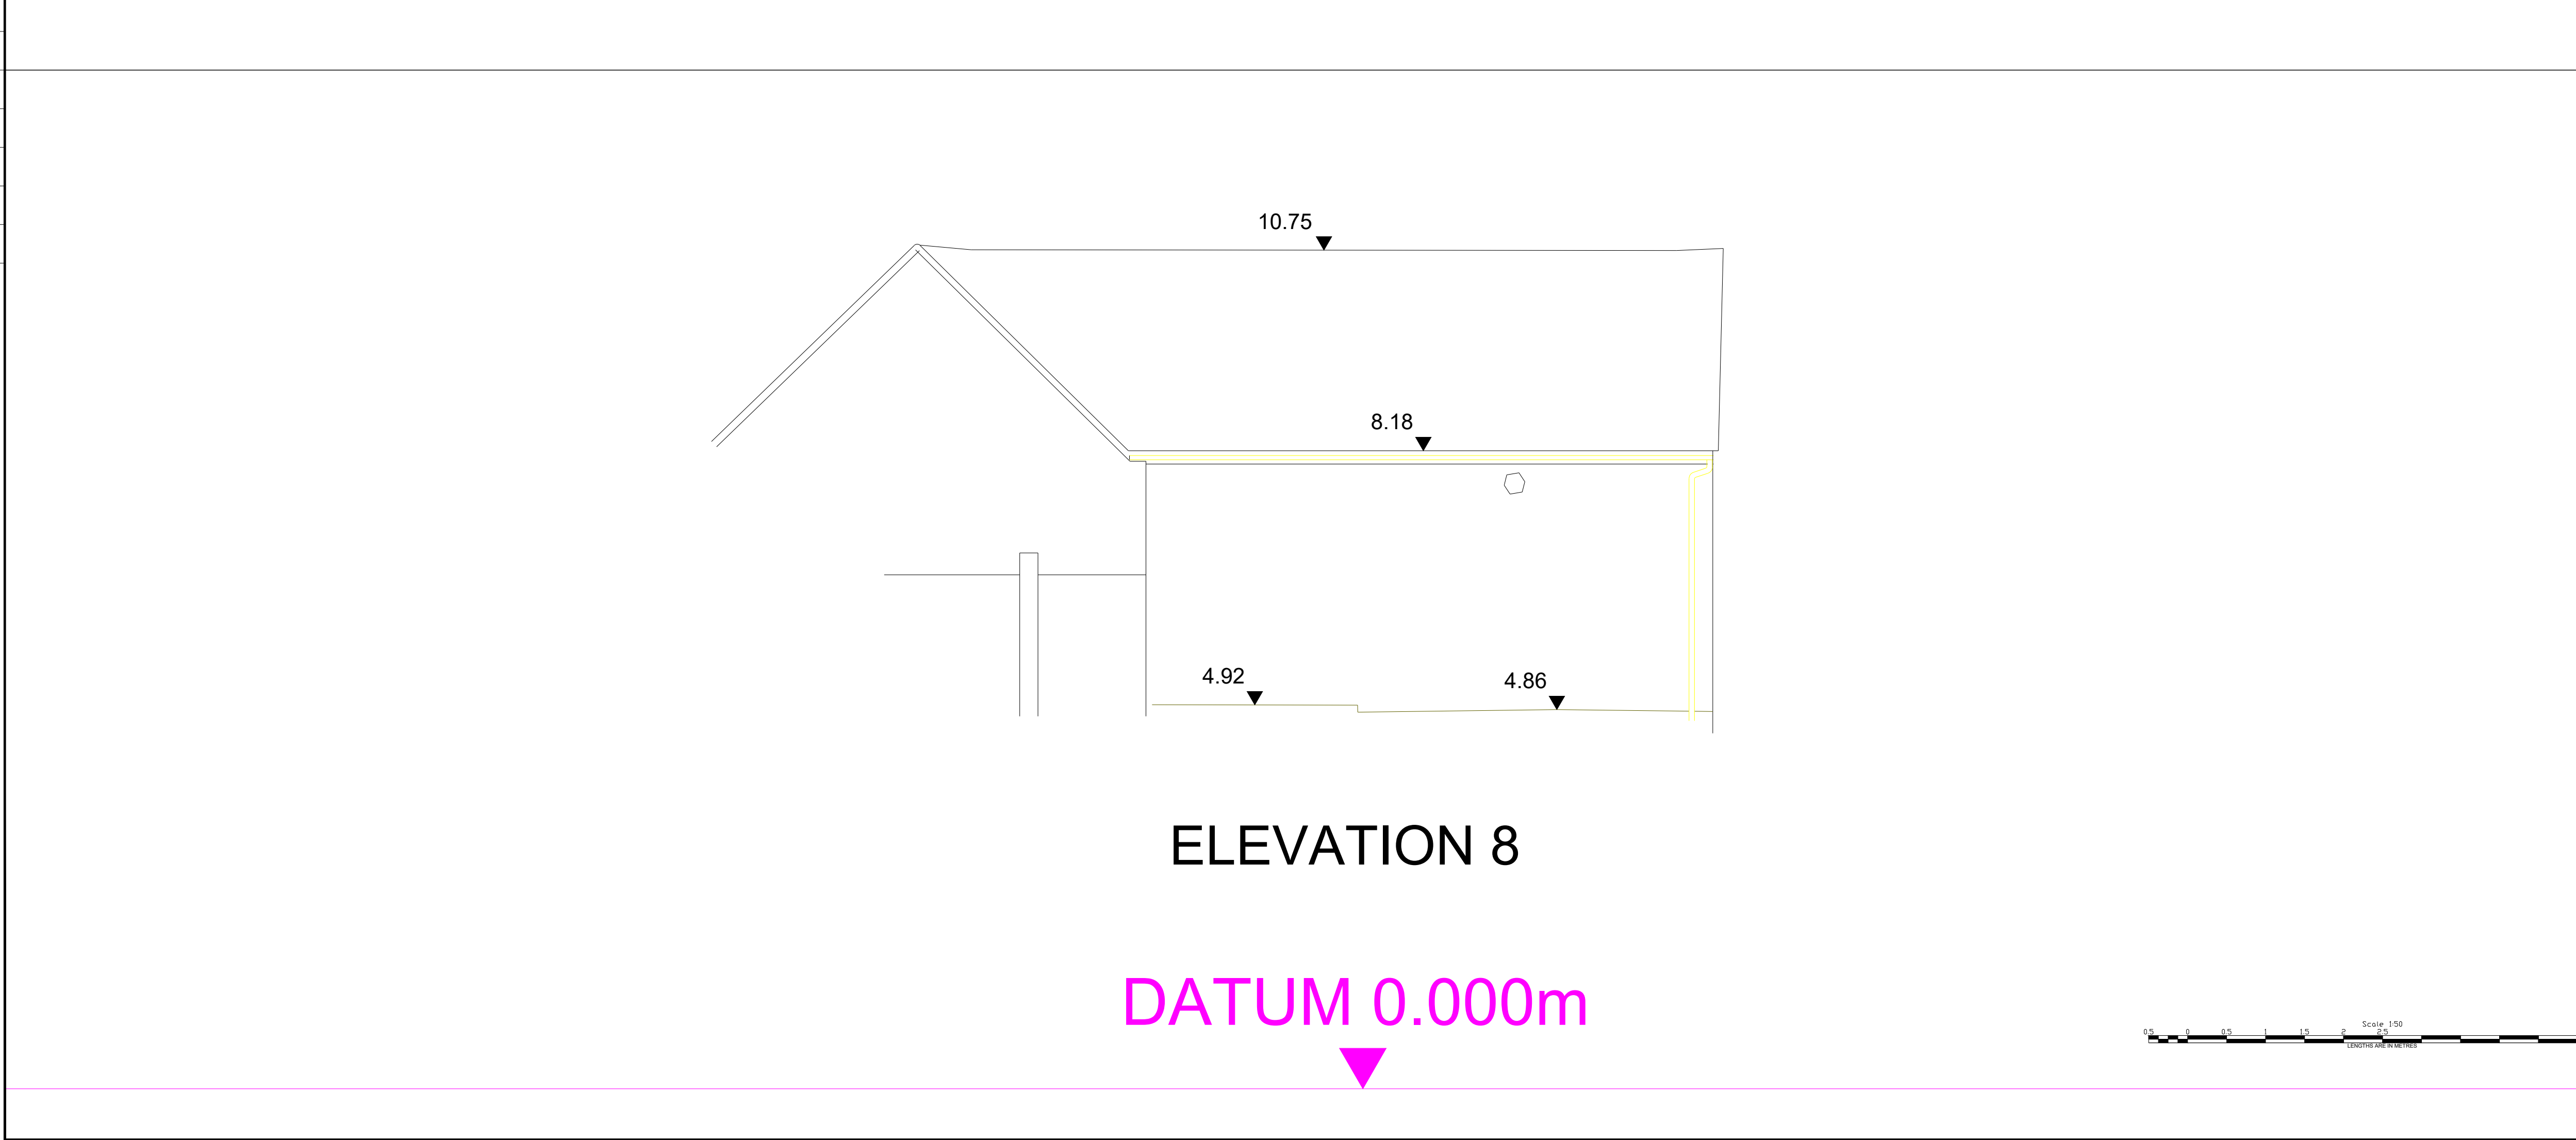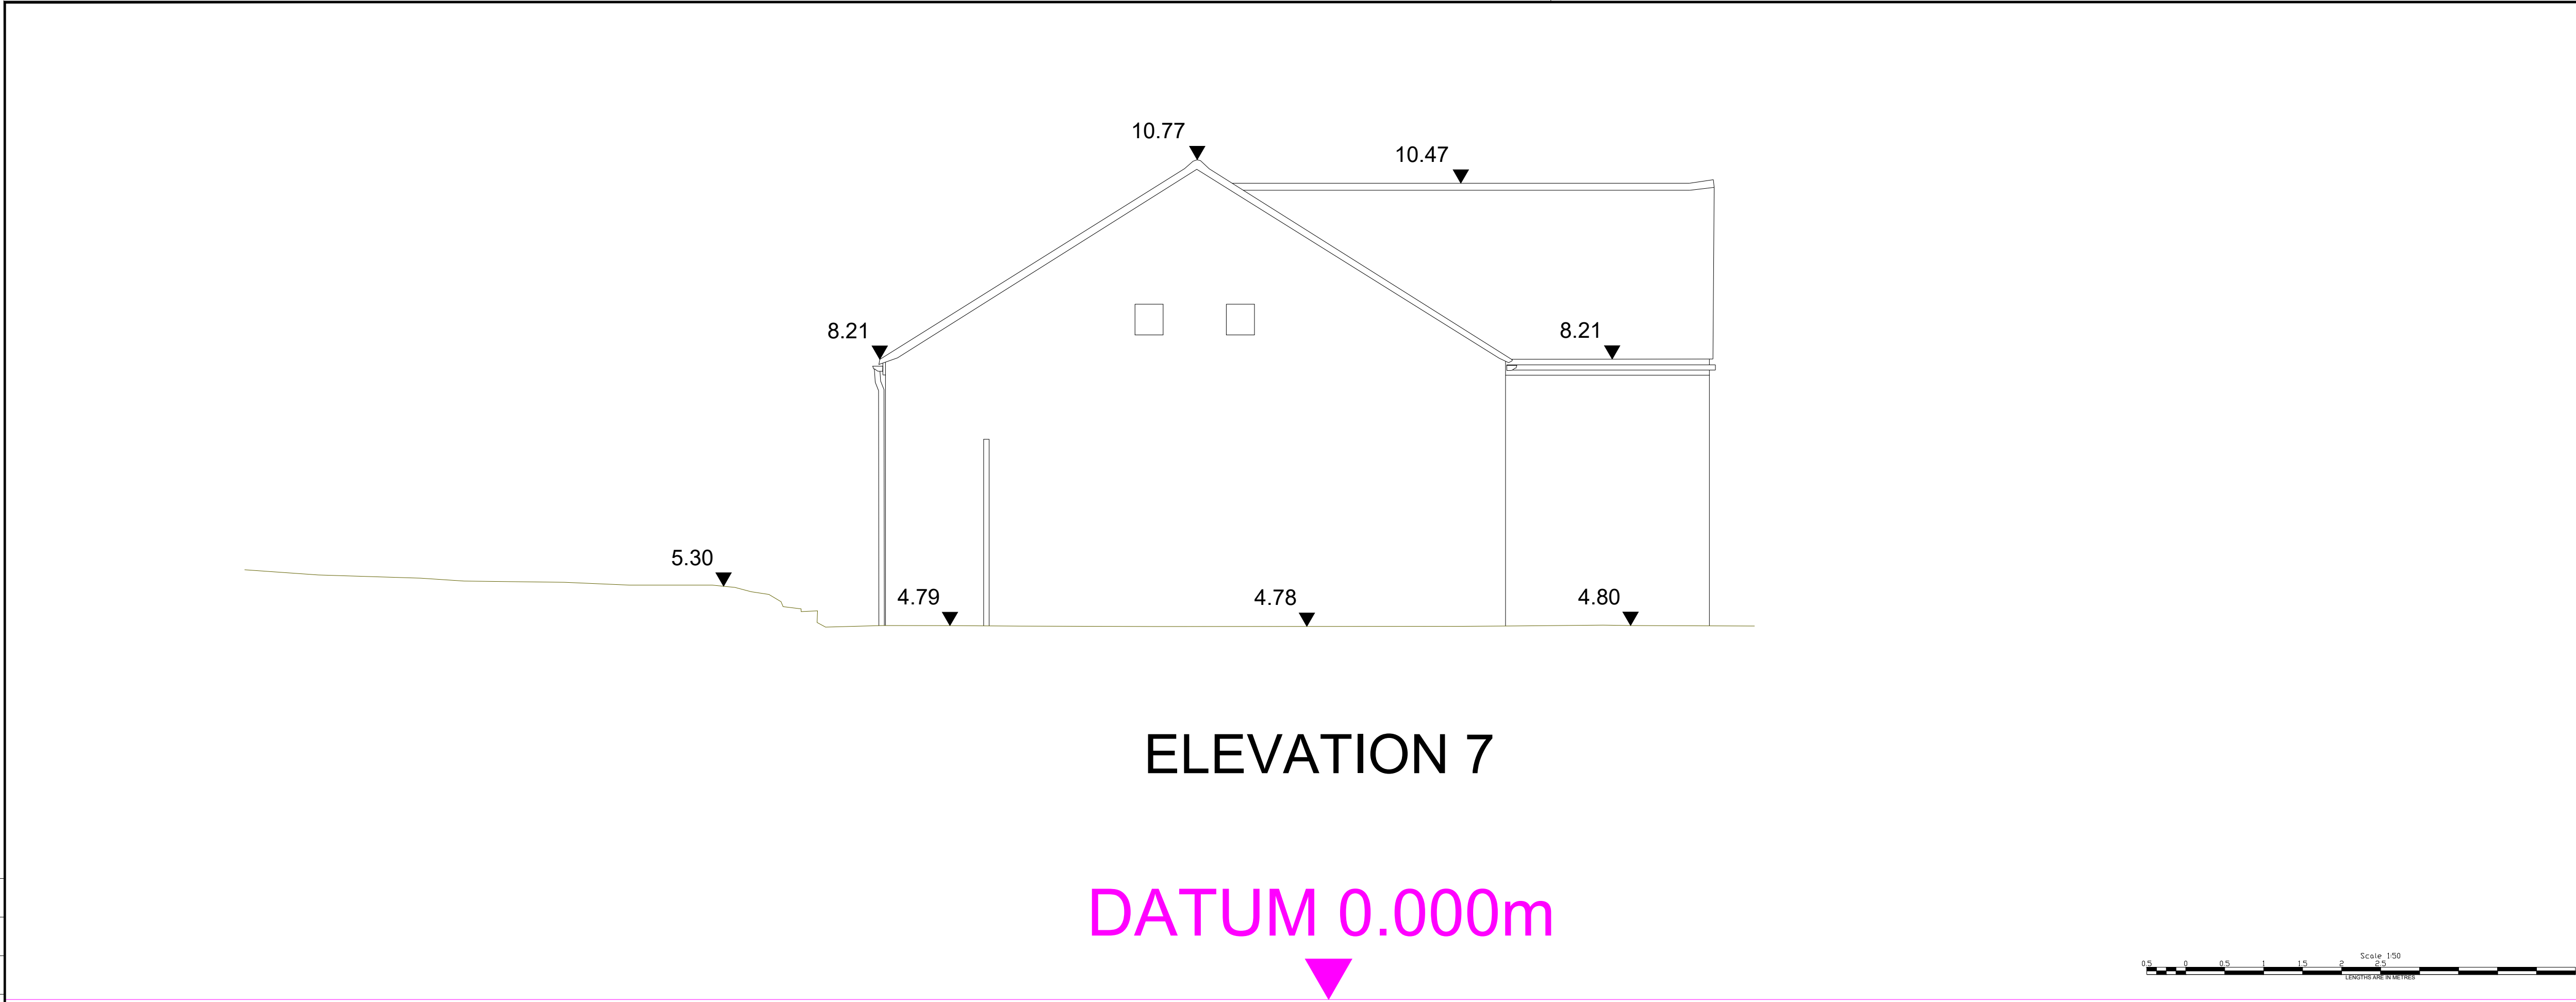

TOPOGRAPHICAL SURVEY LEGEND

GENERAL

AV

AIR VALVE

B8

BOLISHA BEACON

Bdy

BOUNDARY

BH

BORHOLE

BL

BED LEVEL

BO

BOLLARD

BS

BUS STOP

BKW

BRICK WALL

CATV

CABLE TELEVISION

CG

CATTLE GRID

CH

CHANNEL LEVEL

Conc

CONCRETE

Corr

CORRUGATED

CO

COPING LEVEL

CPS

CONC. PAVING SLABS

CR

CROWN LEVEL

CUL

CULVERT

DK

DROP KERB

DP

DOWN PIPE

EB

ELECTRICITY BOX

EC

ELECTRICITY CABLE

EdmMH

ELECTRICITY MANHOLE

EP

ELECTRICITY POLE

EPy

ELECTRICITY PYLON

ER

EARTHING ROD

FI

FIRE HYDRANT

FLR

FLOOR LEVEL

FM

FLOW METER

FB

FLOWER BED

FW

FOUL WATER

GL

GROUND LEVEL

GP

GATE POST

GV

GAS VALVE

H

HIGH

HO

HOLE

HW

HEADWALL

IC

INSPECTION COVER

JB

JUNCTION BOX

KL

KEEP LEFT ROAD SIGN

LB

LETTER BOX

LH

LAMP HOLE

LP

LAMP POST

MK

MARKER POST

MS

MILE STONE

NB

NOTICE BOARD

NP

NAME-PLATE

OSBM

ORDNANCE SURVEY BENCH MARK

OH

OVERHEAD

PE

PENSTOCK

PM

PARKING METER

PO

POST

RB

RUBBISH BIN

RS

ROAD SIGN

RTW

RETAINING WALL

RWP

RAIN WATER PIPE

SAP

SAPLING

SC

STOP COCK

SL

SOFT LEVEL

SVP

SOIL VENT PIPE

SP

SIGN POST

STN

SURVEY STATION

SV

STOP VALVE

SW

SURFACE WATER

TB

THRESHOLD

TBM

TEMPORARY BENCH MARK

TCH

TELEPHONE CALL BOX

TL

TRAFFIC LIGHT

TMH

TELEPHONE MANHOLE

TOW

TOP OF WALL

TP

TELEGRAPH POLE

TS

TREE STUMP

UG

UNDERGROUND

VA

VALVE

VP

VENT PIPE

W

WIDE

WL

WATER LEVEL

WM

WATER METER

WO

WASH OUT

WP

WOODEN POST

WV

WATER VALVE

IFW

FENCE INTERWOVEN

LUF

FENCE LARCH LAP

PAL

FENCE PALISADE FENCE

PRF

POST & RAIL FENCE

TR

TRELLIS

AA

ACACIA

AH

ASH

AL

ALDER

AN

ASPEN

AP

APPLE

BH

BEECH

BL

BLACKTHORN

BR

BIRCH

CE

CHERRY

CO

CONIFER

CR

CEDAR

CY

CYPRESS

DD

DEAD

ED

ELDER

EM

ELM

FR

FIR

HB

HORNBEAM

HC

HORSE CHESTNUT

HN

HAWTHORN

HY

HOLLY

LA

LARCH

LE

LIME

LN

LONDON PLANE

ME

MAPLE

OK

OAK

OR

ORNAMENTAL

PE

PINE

PD

POLLARDED

PO

POPLAR

SB

SILVER BIRCH

SC

SWEET CHESTNUT

SU

SPRUCE

SY

SYCAMORE

WB

WHITEBEAM

WT

WALNUT

WW

WILLOW

YW

YEW

XX

UNKNOWN

OR

ORNAMENTAL

PE

PINE

PD

POLLARDED

PO

POPLAR

SB

SILVER BIRCH

SC

SWEET CHESTNUT

SU

SPRUCE

SY

SYCAMORE

WB

WHITEBEAM

WT

WALNUT

WW

WILLOW

YW

YEW

XX

UNKNOWN

IL

INVERT LEVEL

KIG

KERB INLET GULLY

MH

MANHOLE

OH

OVER HEAD LINE

PI

PETROL INTERCEPTOR

RD

FROM RECORD DRAWINGS

ROD

RODING EYE

SK

SOAKAWAY

TP

TRACED POINT

UNK

UNKNOWN SERVICE

UTL

UNABLE TO LOCATE

UTR

UNABLE TO RAISE

UTT

UNABLE TO TRACE

UTS

UNABLE TO SURVEY

AC

ASSUMED CONNECTION

AR

ASSUMED ROUTE

BO

BACK DROP

CC

CONFIRMED CONNECTION

CD

CHAMBER DEPTH

CDW

CABLE ON WALL

C

COVER LEVEL

CP

CATCH PIT

CR

CABLE RISER

DTB

DEPTH TO BASE

D

DEPTH

(DB)

DISUSED

EOT

END OF TRACE

GU

GULLY

IL

INVERT LEVEL

KIG

KERB INLET GULLY

MH

MANHOLE

OH

OVER HEAD LINE

PI

PETROL INTERCEPTOR

RD

FROM RECORD DRAWINGS

ROD

RODING EYE

SK

SOAKAWAY

TP

TRACED POINT

UNK

UNKNOWN SERVICE

UTL

UNABLE TO LOCATE

UTR

UNABLE TO RAISE

UTT

UNABLE TO TRACE

UTS

UNABLE TO SURVEY

UTILITY LEGEND AND NOTES

UTILITY DEPTHS

SERVICES ARE DRAWN IN 3D WITH THE LEVEL CORRESPONDING TO THE CENTRE OF THE UTILITY. EXCEPTIONS TO THIS ARE SERVICES AND FEATURES DETECTED BY GPR WHERE THE LEVEL IS THAT OF THE TOP OF THE UTILITY. THESE ARE DENOTED BY GPR LAYERS OR LINETYPES SHOWN ABOVE OR BY SPECIFIC LABELLING OF THE DRAWING.

UTILITY DEPTHS

SERVICES ARE DRAWN IN 3D WITH THE LEVEL CORRESPONDING TO THE CENTRE OF THE UTILITY. EXCEPTIONS TO THIS ARE SERVICES AND FEATURES DETECTED BY GPR WHERE THE LEVEL IS THAT OF THE TOP OF THE UTILITY. THESE ARE DENOTED BY GPR LAYERS OR LINETYPES SHOWN ABOVE OR BY SPECIFIC LABELLING OF THE DRAWING.

CONFIDENCE RATING

CONFIDENCE RATINGS FOR UTILITIES TRACED ARE IDENTIFIED AS LAID OUT IN SECTION 5 OF THE PAS 128:2014 SPECIFICATION FOR UNDERGROUND UTILITY DETECTION, VERIFICATION AND LOCATION

CAUTIONARY NOTES

ELECTRO-DETECTION TECHNIQUES HAVE BEEN USED IN THE LOCATION OF UNDERGROUND SERVICES. THE RESULTS ARE NOT INFALLIBLE AND TRIAL EXCAVATIONS MUST BE CARRIED OUT TO CONFIRM SERVICE IDENTIFICATION. POSITIONS AND PARTICULARLY DEPTHS. ALTHOUGH ALL REASONABLE EFFORT HAS BEEN MADE IN SEARCHING AVAILABLE RECORD DRAWINGS, THE COMPLETENESS OF THE UNDERGROUND SERVICE INFORMATION CANNOT BE GUARANTEED. INFORMATION OBTAINED BY GPR IS INDICATIVE OF BURIED INFRASTRUCTURE THAT MAY NOT BE DETECTABLE BY OTHER MEANS.

CAUTIONARY NOTES

ELECTRO-DETECTION TECHNIQUES HAVE BEEN USED IN THE LOCATION OF UNDERGROUND SERVICES. THE RESULTS ARE NOT INFALLIBLE AND TRIAL EXCAVATIONS MUST BE CARRIED OUT TO CONFIRM SERVICE IDENTIFICATION. POSITIONS AND PARTICULARLY DEPTHS. ALTHOUGH ALL REASONABLE EFFORT HAS BEEN MADE IN SEARCHING AVAILABLE RECORD DRAWINGS, THE COMPLETENESS OF THE UNDERGROUND SERVICE INFORMATION CANNOT BE GUARANTEED. INFORMATION OBTAINED BY GPR IS INDICATIVE OF BURIED INFRASTRUCTURE THAT MAY NOT BE DETECTABLE BY OTHER MEANS.

DRAINAGE NOTES

PIPES ON THE REPORT ARE REFERENCED CLOCKWISE FROM THE OUTGOING PIPE WITH THE MH NUMBER AS THE PREFIX I.E. MH01A. END POINT LOCATIONS WITHIN BUILDINGS ARE INDICATIVE UNLESS STATED.

DRAINAGE NOTES

PIPES ON THE REPORT ARE REFERENCED CLOCKWISE FROM THE OUTGOING PIPE WITH THE MH NUMBER AS THE PREFIX I.E. MH01A. END POINT LOCATIONS WITHIN BUILDINGS ARE INDICATIVE UNLESS STATED.

Note: Pipe sizes in mm

TECHNICAL NOTES

ALL LEVELS ARE BASED ON ORDNANCE SURVEY DATUM OBTAINED FROM ACTIVE GPS NETWORK "OSGB36(15)"

ALL KERB LEVELS ARE TAKEN IN CHANNEL.

A SCALE FACTOR OF 1.000000 HAS BEEN APPLIED TO THIS DRAWING

TECHNICAL NOTES

ALL LEVELS ARE BASED ON ORDNANCE SURVEY DATUM OBTAINED FROM ACTIVE GPS NETWORK "OSGB36(15)"

ALL KERB LEVELS ARE TAKEN IN CHANNEL.

A SCALE FACTOR OF 1.000000 HAS BEEN APPLIED TO THIS DRAWING

Rev.

Date

Description

By

A

SEPT 21

ADDITIONAL SECTIONS AND ELEVATIONS ADDED

CH

Drawn by

Surveyed by

Checked by

X.X.X.

X.X.X.

X.X.X.

SURVEY

DESIGN SERVICES

SDS

Project site

WHITSTABLE MUSEUM

Drawing title

SECTIONS AND ELEVATIONS

Client

AR DESIGN

Drawing No.

SDS 206247-07

Revision

A

Scale 1:50

Date

SEPT 2021

Sheet size

A1

SURVEY

DESIGN SERVICES

SDS

Project site

WHITSTABLE MUSEUM

Drawing title

SECTIONS AND ELEVATIONS

Client

AR DESIGN

Drawing No.

SDS 206247-07

Revision

A

Scale 1:50

Date


SEPT 2021

Sheet size

A1

SURVEY DESIGN SERVICES and ASSOC. LTD. UNITS 13 & 14,FOUNDRY BUSINESS PARK, SEAGER ROAD, FAVERSHAM, KENT. ME13 7FD TEL. 01795 594110 www.surveymdesignservices.co.uk



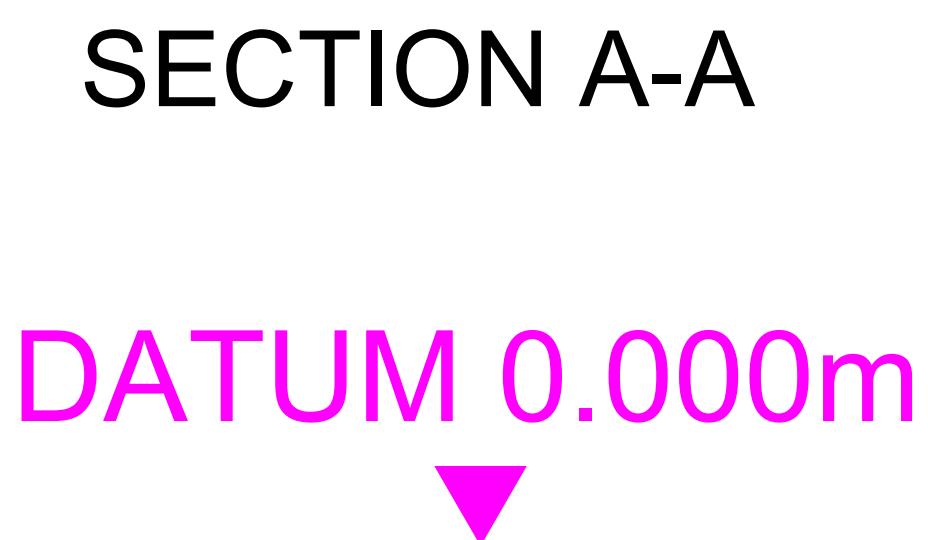

TOPOGRAPHICAL SURVEY LEGEND

GENERAL

AV

AIR WALK

BB

BOLISHA BEACON

Bdy

BOUNDARY

BH

BORHHOLE

BL

BLD LEVEL

BQ

BOLLARD

BS

BUS STOP

BWK

BRICK WALL

CAV

CABLE TELEVISION

CG

CATTLE GRID

CH

CHANNEL LEVEL

Conc

CONCRETE

CR

CORRUGATED

CO

COPING LEVEL

CRS

CONC. PAVING SLABS

CR

CROWN LEVEL

CUL

CULVERT

DC

DROP KERB

DP

DOWN PIPE

EB

ELECTRICITY BOX

EC

ELECTRICITY CABLE

EleclMH

ELECTRICITY MANHOLE

EP

ELECTRICITY POLE

ER

ELECTRICITY Pylon

ER

EARTHING ROD

FI

FIRE HYDRANT

FL

FLOOR LEVEL

FM

FLOW METER

FLW

FLOWER BED

FW

FLOW WATER

GL

GROUND LEVEL

GP

GATE POST

GV

GRADE VALVE

H

HIGH

HO

HOLE

HW

HEADWALL

IC

INSPECTION COVER

JB

JUNCTION BOX

KL

LEFT ROAD SIGN

LB

LETTER BOX

LH

LAMP HOLE

LP

LAMP POST

MK

MARKER POST

MS

MILE STONE

NB

NOTICE BOARD

NP

NAME-PLATE

OSBM

ORNDANCE SURVEY BENCH MARK

OH

OVERHEAD

OP

PENSTOCK

PM

PARKING METER

PO

POST

RB

RUBBISH BIN

RJ

ROAD SIGN

RTW

RETAINING WALL

RWP

RAIN WATER PIPE

SA

SAPLING

SC

STOP COCK

SO

SOFFIT LEVEL

SVP

SOIL VENT PIPE

SP

SIGN POST

STN

SURVEY STATION

SV

STOP VALVE

SW

SURFACE WATER

TS

TIE ROD

TBM

TEMPORARY BENCH MARK

TCB

TELEPHONE CALL BOX

TH

THRESHOLD

TL

TRAFFIC LIGHT

TMH

TELEPHONE MANHOLE

TO

TOP OF WALL

TP

TELEGRAPH POLE

TS

TREE STUMP

U/G

UNDERGROUND

VA

VALVE

VE

VENT PIPE

W

WIDE

WL

WATER LEVEL

WM

WATER METER

WO

WASH OUT

WP

WOODEN POST

WV

WATER VALVE

FENCE TYPES

BWF

BARBED WIRE FENCE

CBF

CLOSE BOARDED FENCE

CLF

CHAINLINK FENCE

CSF

CHESTNUT FENCING

CWF

FENCE CHICKEN WIRE

IRF

FENCE IRON RAILING

IWF

FENCE INTERVENOEN

LLF

FENCE LARCH LAMP

PAL

FENCE PALISADE FENCE

PRF

POST & RAIL FENCE

PWF

POST & WIRE FENCE

TR

TRELLIS

TREE TYPES

AA

ACACIA

ED

ELDER

OR

ORNAMENTAL

AH

ASH

EM

ELM

PE

PINE

AL

APPLE

FR

FIR

PO

POLLARDED

AN

ASPEN

HB

HORNBEAM

PR

POPULAR

AP

APPLE

HC

HORSE CHESTNUT

SB

SILVER BIRCH

BH

BEECH

HN

HAWTHORN

SC

SWEET CHESTNUT

BL

BLACKTHORN

HY

HOLLY

SY

SYCAMORE

BR

BIRCH

LA

LARCH

WB

WHITEBAM

CH

CHERRY

LE

LIME

WJ

WILLOW

CO

COMIFER

LN

LONDON PLANE

WT

WALNUT

CR

CEDAR

ME

MAPLE

YD

YEW

CT

CYPRESS

OK

OAK

YW


YEW

DO

DEAD



XX

UNKNOWN

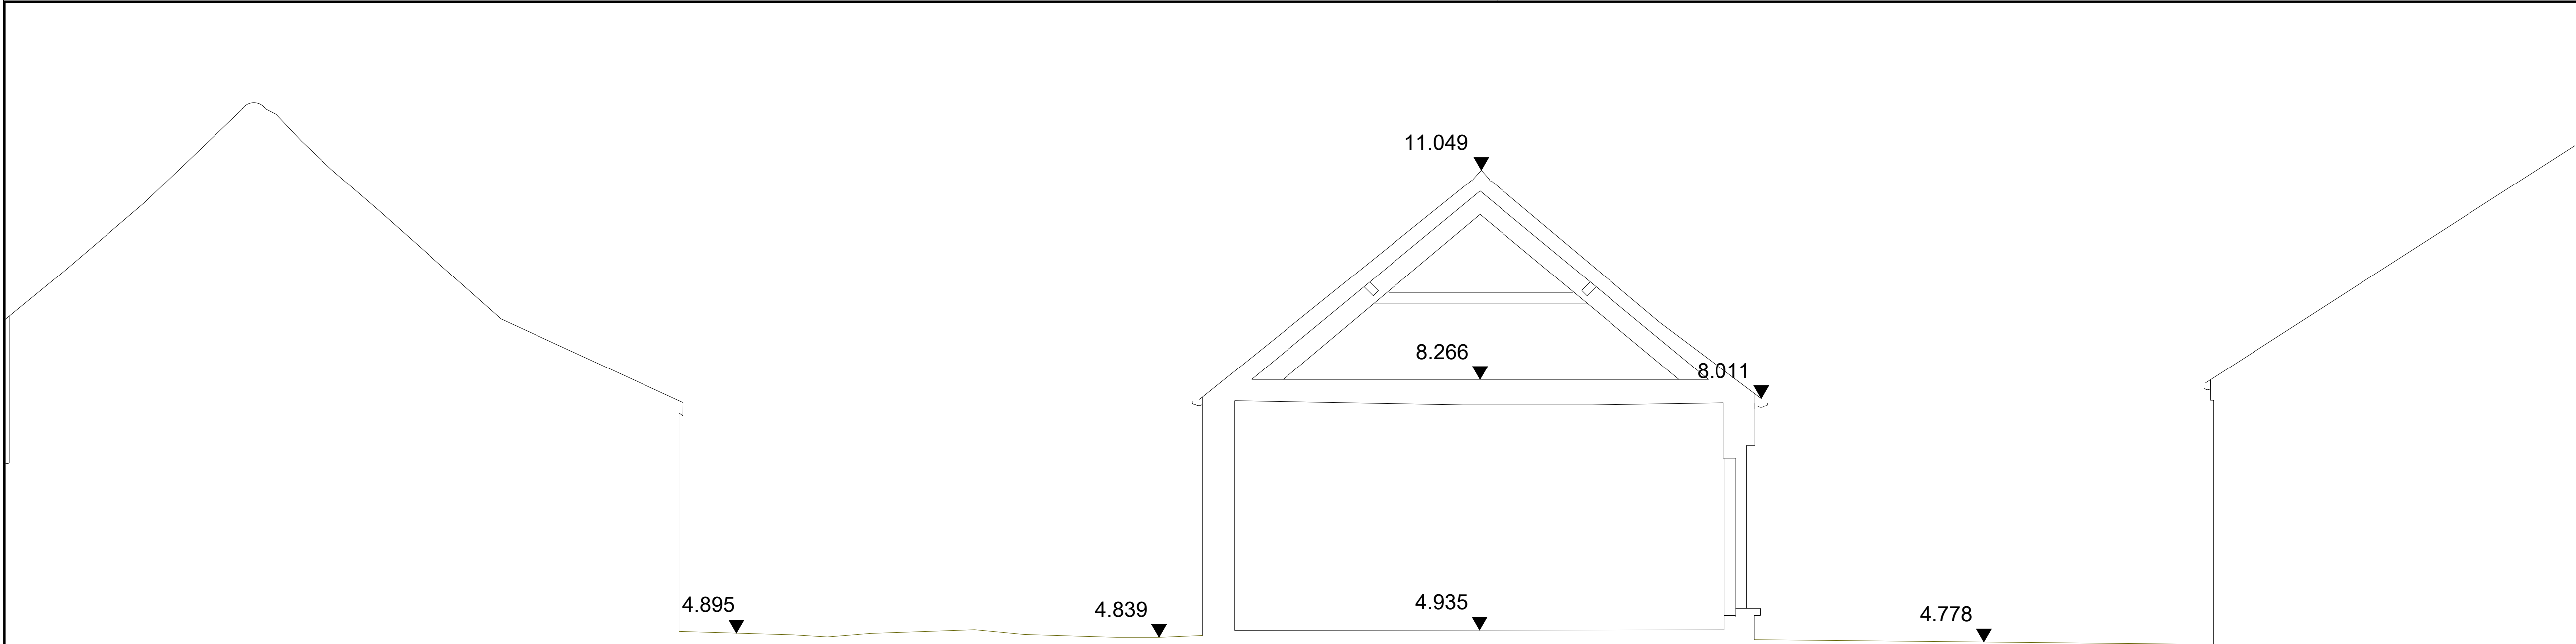


SECTION B-B

DATUM 0.000m

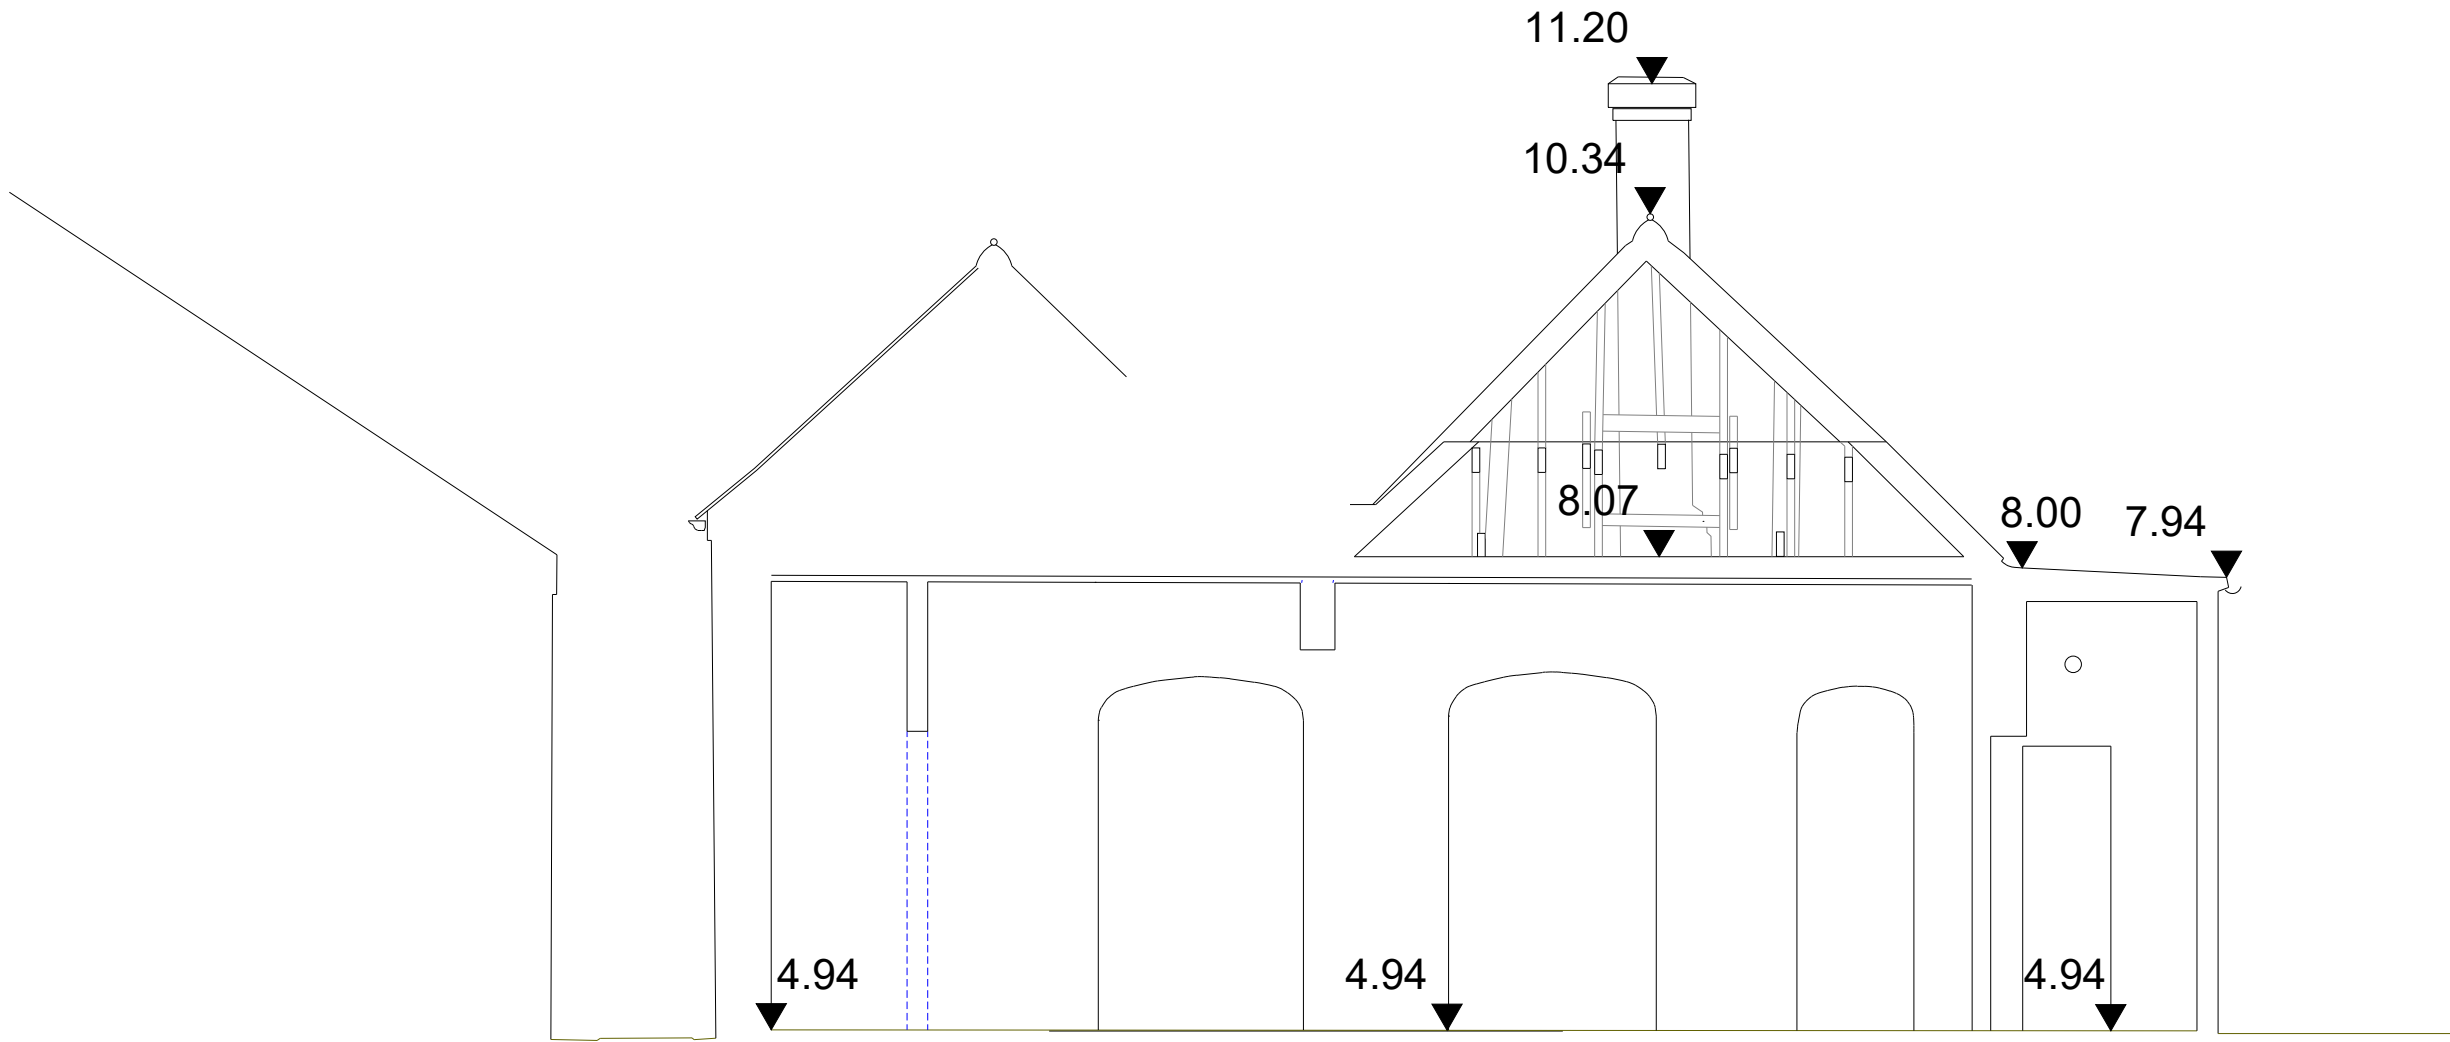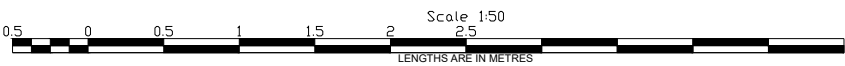

SECTION C-C

DATUM 0.000m

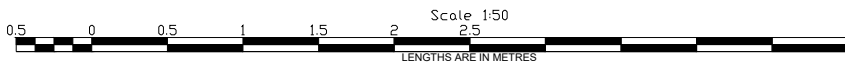

TOPOGRAPHICAL SURVEY LEGEND

GENERAL

AV	AIR VALVE	LH	LAMP HOLE
BB	BOLISHA BEACON	LP	LAMP POST
Bdy	BOUNDARY	MK	MARKER POST
BH	BORHOLE	MS	MILE STONE
BL	BED LEVEL	NB	NOTICE BOARD
BO	BOLLARD	NP	NAME-PLATE
BS	BUS STOP	OSBM	ORDNANCE SURVEY BENCH MARK
BKW	BRICK WALL	OH	OVERHEAD
CATV	CABLE TELEVISION	PE	PENSTOCK
CG	CATTLE GRID	PM	PARKING METER
CH	CHANNEL LEVEL	PO	POST
Conc	CONCRETE	RB	RUBBISH BIN
Corr	CORRUGATED	RS	ROAD SIGN
CO	COPING LEVEL	RTW	RETAINING WALL
CPS	CONC. PAVING SLABS	RWP	RAIN WATER PIPE
CR	CROWN LEVEL	SAP	SAPLING
CUL	CULVERT	SC	STOP COCK
DK	DROP KERB	SL	SOFT LEVEL
DP	DOWN PIPE	SVP	SOIL VENT PIPE
EB	ELECTRICITY BOX	SP	SIGN POST
EC	ELECTRICITY CABLE	STN	SURVEY STATION
EdmH	ELECTRICITY MANHOLE	SV	STOP VALVE
EP	ELECTRICITY POLE	SW	SURFACE WATER
EPY	ELECTRICITY PYLON	TB	TREE BOLE
ER	EARTHING ROD	TBM	TEMPORARY BENCH MARK
FI	FIRE HYDRANT	TCL	TELEPHONE CALL BOX
FLR	FLOOR LEVEL	TH	THRESHOLD
FM	FLOW METER	TL	TRAFFIC LIGHT
FB	FLOW BED	TMH	TELEPHONE MANHOLE
FW	FOUL WATER	TOW	TOP OF WALL
GL	GROUND LEVEL	TP	TELEGRAPH POLE
GP	GATE POST	TS	TREE STUMP
GV	GAS VALVE	UG	UNDERGROUND
H	HIGH	VA	VALVE
HO	HOLE	VP	VENT PIPE
HW	HEADWALL	W	WIDE
IC	INSPECTION COVER	WL	WATER LEVEL
JB	JUNCTION BOX	WM	WATER METER
KL	KEEP LEFT ROAD SIGN	WO	WASH OUT
LB	LETTER BOX	WP	WOODEN POST
		WV	WATER VALVE

FENCE TYPES

BWF	BARBED WIRE FENCE	IWF	FENCE INTERWOVEN
CBF	CLOSE BOARDED FENCE	LUF	FENCE LARCH LAP
CLF	CHAINLINK FENCE	PAL	FENCE PALISADE FENCE
CPF	CHESTNUT PALING	PRF	POST & RAIL FENCE
CWF	FENCE CHICKEN WIRE	PWF	POST & WIRE FENCE
IRF	FENCE IRON RAILING	TR	TRELLIS

TREE TYPES

AA	ACACIA	ED	ELDER	OR	ORNAMENTAL
AH	ASH	EM	ELM	PE	PINE
AL	ALDER	FR	FIR	PD	POLLARDED
AN	ASPEN	HB	HORNBEEAM	PR	POPLAR
AP	APPLE	HC	HORSE CHESTNUT	SB	SILVER BIRCH
BH	BEECH	HN	HAWTHORN	SC	SWEET CHESTNUT
BL	BLACKTHORN	HY	HOLLY	SU	SURPUCE
BR	BIRCH	LA	LARCH	SY	SYCAMORE
CE	CHERRY	LE	LIME	WB	WHITEBEAM
CO	CONIFER	LN	LONDON PLANE	WT	WALNUT
CR	CEDAR	ME	MAPLE	WW	WILLOW
CY	CYPRESS	OK	OAK	YW	YEW
DD	DEAD			XX	UNKNOWN

TREE ANNOTATION

CO TYPE

45.50 LEVEL

16.00 SPREAD

0.300 DIAM

15.00 HEIGHT

A

SERVICE ABBREVIATIONS			
AC	ASSUMED CONNECTION	IL	INVERT LEVEL
AR	ASSUMED ROUTE	KIG	KERB INLET GULLY
BO	BACK DROP	MH	MANHOLE
CC	CONFIRMED CONNECTION	OHL	OVER HEAD LINE
CD	CHAMBER DEPTH	PI	PETROL INTERCEPTOR
COW	CABLE ON WALL	RD	FROM RECORD DRAWINGS
CL	COVER LEVEL	ROD	RODDING EYE
CP	CATCH PIT	SK	SOAKAWAY
CR	CABLE RISER	TPT	TRACED POINT
DTB	DEPTH TO BASE	UNK	UNKNOWN SERVICE
D	DEPTH	UTL	UNABLE TO LOCATE
(db)	DISBURSED	UTR	UNABLE TO RAISE
EOT	END OF TRACE	UTT	UNABLE TO TRACE
GU	GULLY	UTS	UNABLE TO SURVEY

UTILITY LEGEND AND NOTES		
FOUL WATER DRAINAGE		UTILITIES ARE DRAWN IN 3D WITH THE LEVEL CORRESPONDING TO THE CENTRE OF THE UTILITY.
COMBINED WATER DRAINAGE		EXCEPTIONS TO THIS ARE SERVICES AND FEATURES DETECTED BY GPR WHERE THE LEVEL IS THAT OF THE TOP OF THE UTILITY. THESE ARE DENOTED BY GPR LAYERS OR LINETYPES SHOWN ABOVE OR BY SPECIFIC LABELLING OF THE DRAWING.
SURFACE WATER DRAINAGE		
WATER		
WATER		
ELECTRICITY		
TELEPHONE		
UNKNOWN SERVICE DETECTED BY EML		
UNKNOWN SERVICE DETECTED BY GPR		
OIL		
CATV		
UNKNOWN LINEAR FEATURE DETECTED BY GPR		
FIBRE OPTIC		
UNDERGROUND CHAMBER		
GPR (0.00) GROUND PENETRATING RADAR (DEPTH)		

CAUTIONARY NOTES

ELECTRO-DETECTION TECHNIQUES HAVE BEEN USED IN THE LOCATION OF UNDERGROUND SERVICES. THE RESULTS ARE NOT INFALLIBLE AND TRIAL EXCAVATIONS MUST BE CARRIED OUT TO CONFIRM SERVICE IDENTIFICATION. POSITIONS AND PARTICULARLY DEPTHS. ALTHOUGH ALL REASONABLE EFFORT HAS BEEN MADE IN SEARCHING AVAILABLE RECORD DRAWINGS. THE COMPLETENESS OF THE UNDERGROUND SERVICE INFORMATION CANNOT BE GUARANTEED. INFORMATION OBTAINED BY GPR IS INDICATIVE OF BURIED INFRASTRUCTURE THAT MAY NOT BE DETECTABLE BY OTHER MEANS.

DRAINAGE NOTES		
PIPES ON THE REPORT ARE REFERENCED CLOCKWISE FROM THE OUTGOING PIPE WITH THE MH NUMBER AS THE PREFIX I.E. MH01A.		
END POINT LOCATIONS WITHIN BUILDINGS ARE INDICATIVE UNLESS STATED.		
Note: Pipe sizes in mm		

TECHNICAL NOTES		
ALL LEVELS ARE BASED ON ORDNANCE SURVEY DATUM OBTAINED FROM ACTIVE GPS NETWORK 'OSGB36(15)'		
GRD IS BASED ON OS DATUM OBTAINED FROM ACTIVE GPS NETWORK 'OSGB36(15)'		
ALL KERB LEVELS ARE TAKEN IN CHANNEL.		
A SCALE FACTOR OF 1.000000 HAS BEEN APPLIED TO THIS DRAWING		

Rev.	Date	Description	By
A	SEPT 21	ADDITIONAL SECTIONS AND ELEVATIONS ADDED	CH

Drawn by	X.X.X.	Surveyed by	X.X.X.	Checked by	X.X.X.
----------	--------	-------------	--------	------------	--------



Project site

WHITSTABLE MUSEUM

Drawing title


SECTIONS AND ELEVATIONS

Client

AR DESIGN

Drawing No.	SDS 206247-09	Revision	A
Scale	1:50	Date	SEPT 2021
Sheet size	A1		



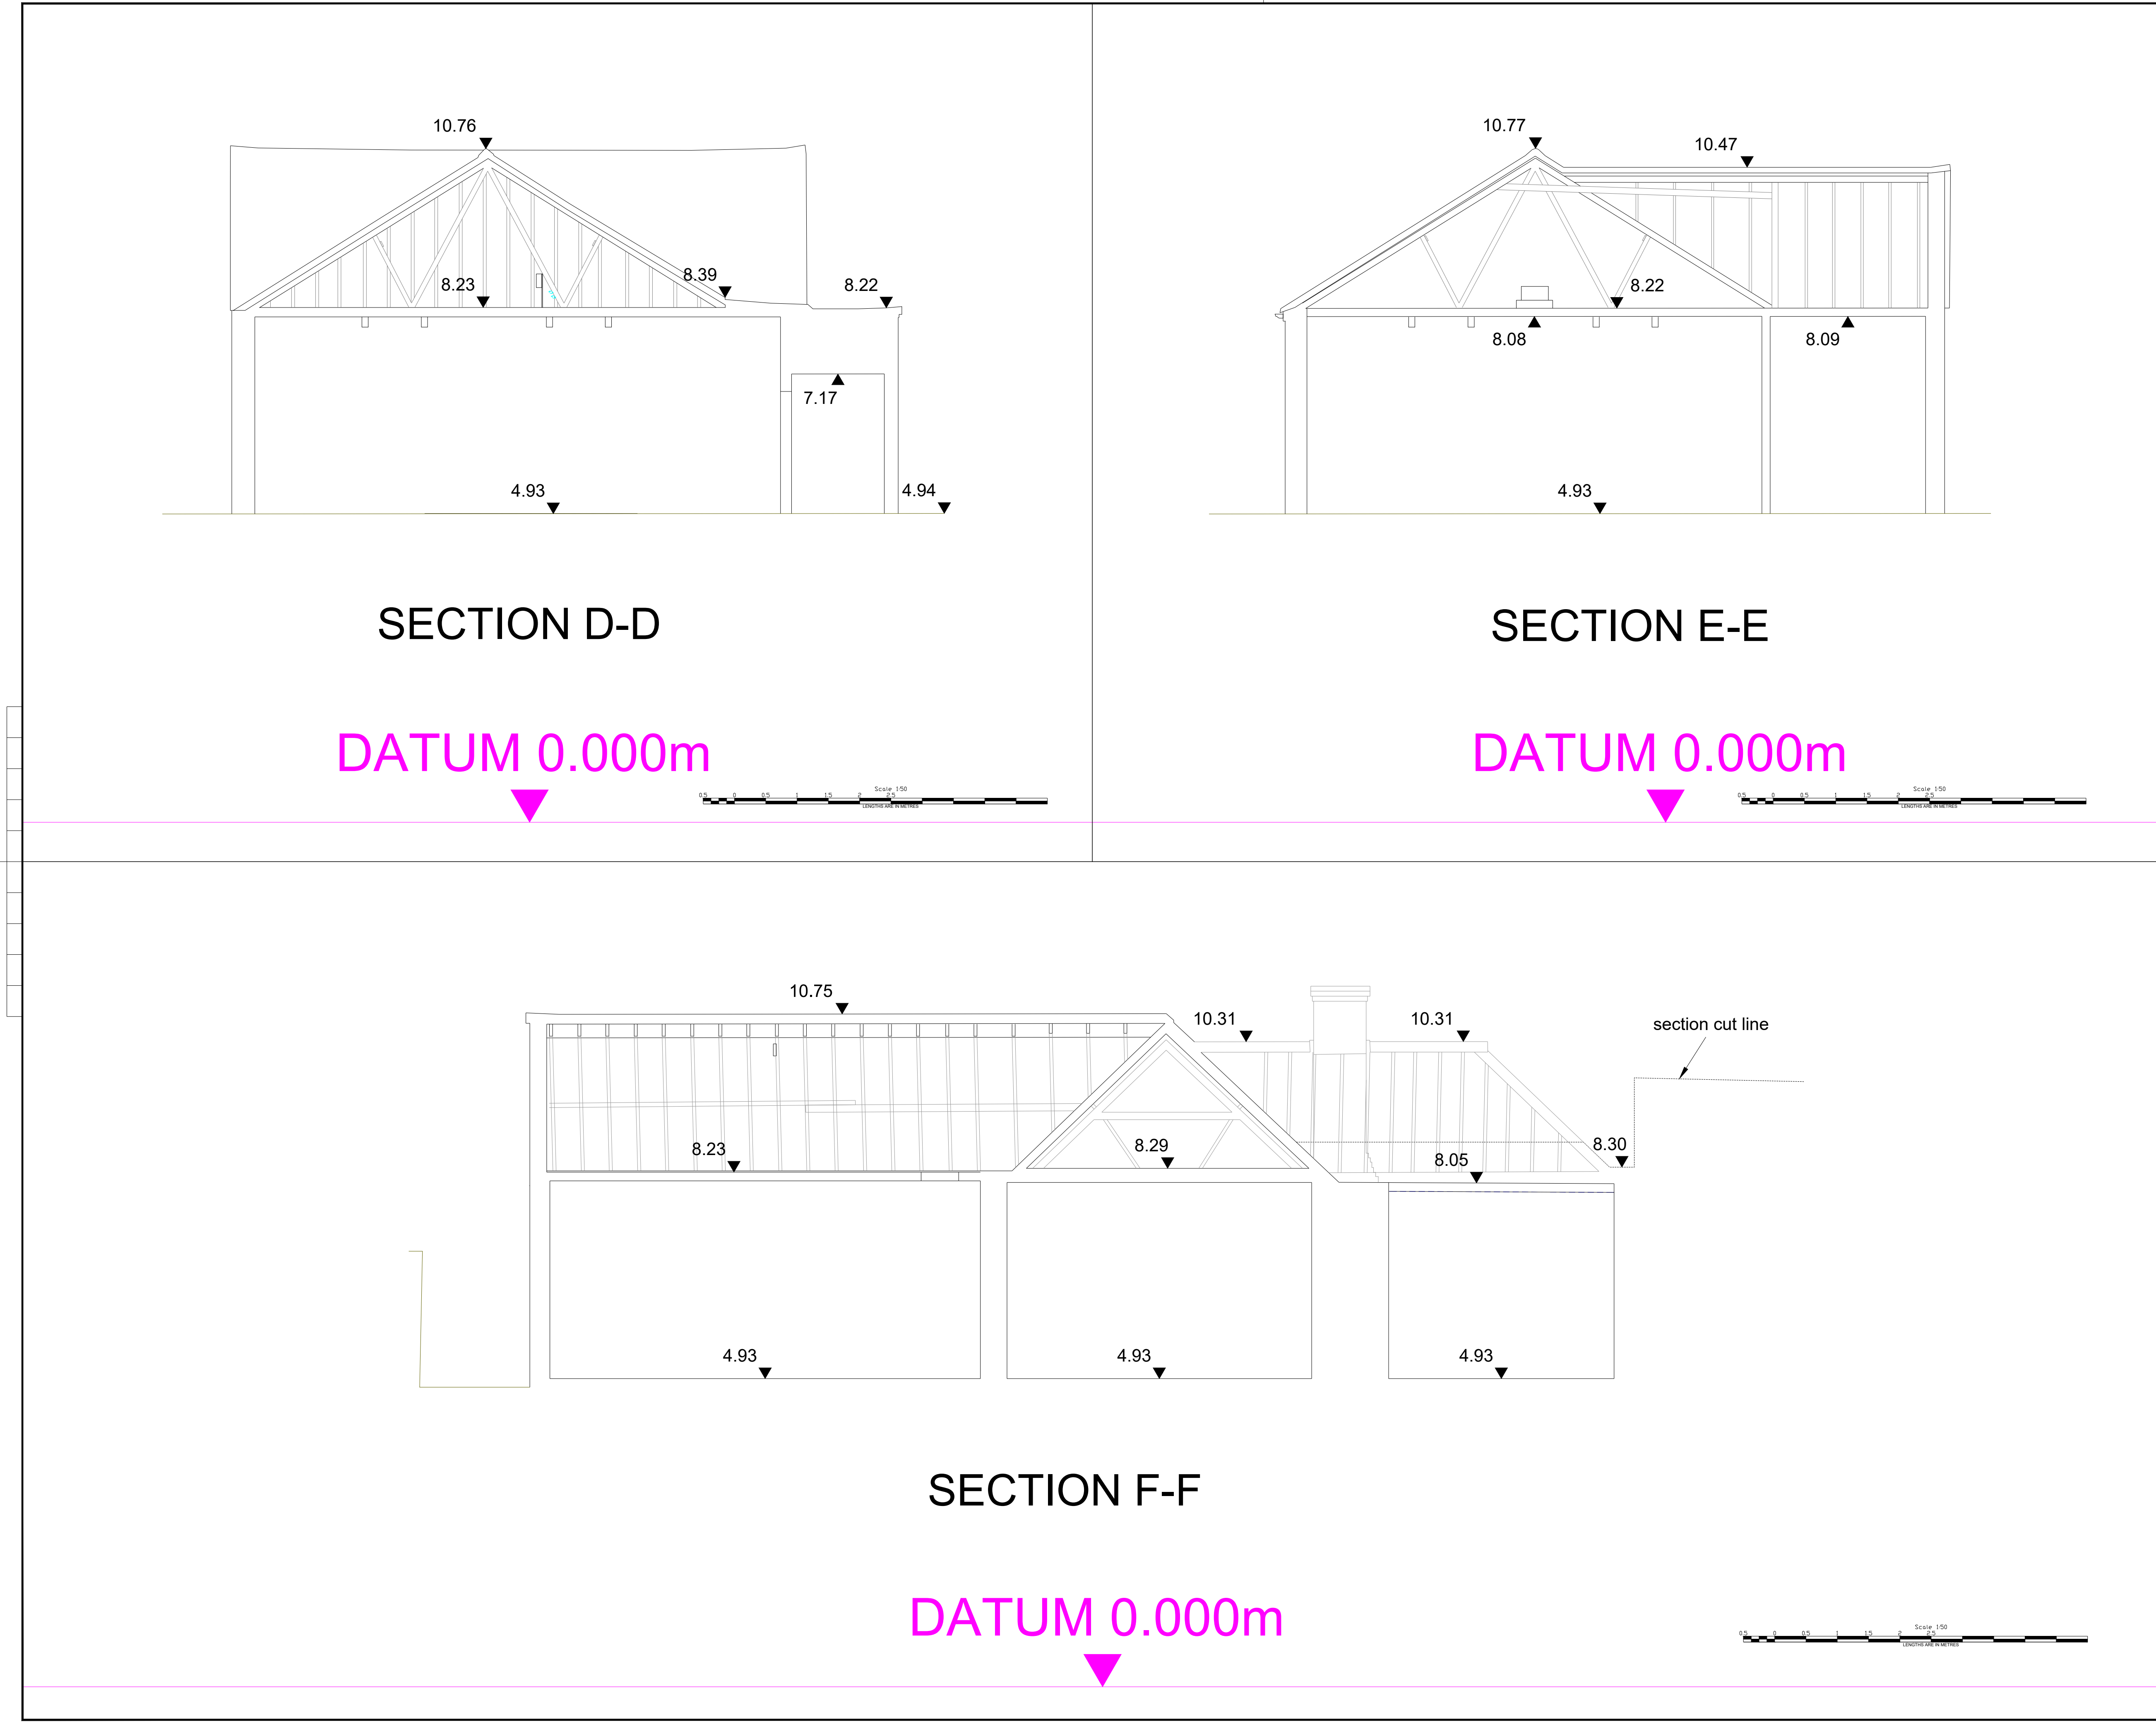

**TOPOGRAPHICAL SURVEY LEGEND**

**GENERAL**

AV	AIR VALVE	LH	LAMP HOLE
B8	BOLISHA BEACON	LP	LAMP POST
Bdy	BOUNDARY	MK	MARKER POST
BH	BORHOLE	MS	MILE STONE
BL	BED LEVEL	NB	NOTICE BOARD
BO	BOLLARD	NP	NAME-PLATE
BS	BUS STOP	OSBM	ORDNANCE SURVEY BENCH MARK
BKW	BRICK WALL	OH	OVERHEAD
CATV	CABLE TELEVISION	PE	PENSTOCK
CG	CATTLE GRID	PM	PARKING METER
CH	CHANNEL LEVEL	PO	POST
Conc	CONCRETE	RB	RUBBISH BIN
Corr	CORRUGATED	RS	ROAD SIGN
CO	COPING LEVEL	RTW	RETAINING WALL
CPS	CONC. PAVING SLABS	RWP	RAIN WATER PIPE
CR	CROWN LEVEL	SAP	SAPLING
CUL	CULVERT	SC	STOP COCK
DK	DROP KERB	SL	SOFT LEVEL
DP	DOWN PIPE	SVP	SOIL VENT PIPE
EB	ELECTRICITY BOX	SP	SIGN POST
EC	ELECTRICITY CABLE	STN	SURVEY STATION
ElecMH	ELECTRICITY MANHOLE	SV	STOP VALVE
EP	ELECTRICITY POLE	SW	SURFACE WATER
EPY	ELECTRICITY PYLON	TB	TREE BOLE
ER	EARTHING ROD	TBM	TEMPORARY BENCH MARK
FR	FIRE HYDRANT	TGB	TELEPHONE CALL BOX
FLR	FLOOR LEVEL	TH	THRESHOLD
FM	FLOW METER	TL	TRAFFIC LIGHT
FB	FLOWER BED	TMH	TELEPHONE MANHOLE
FW	FOUL WATER	TOW	TOP OF WALL
GL	GROUND LEVEL	TP	TELEGRAPH POLE
GP	GATE POST	TS	TREE STUMP
GV	GAS VALVE	UG	UNDERGROUND
H	HIGH	VA	VALVE
HO	HOLE	VP	VENT PIPE
HW	HEADWALL	W	WIDE
IC	INSPECTION COVER	WL	WATER LEVEL
JB	JUNCTION BOX	WM	WATER METER
KL	KEEP LEFT ROAD SIGN	WO	WASH OUT
LB	LETTER BOX	WP	WOODEN POST
		WV	WATER VALVE

**FENCE TYPES**

BWF	BARBED WIRE FENCE	IWF	FENCE INTERWOVEN
CBF	CLOSE BOARDED FENCE	LUF	FENCE LARCH LAP
CLF	CHAINLINK FENCE	PAL	FENCE PALISADE FENCE
CPF	CHESTNUT PALING	PRF	POST & RAIL FENCE
CWF	FENCE CHICKEN WIRE	PWF	POST & WIRE FENCE
IRF	FENCE IRON RAILING	TR	TRELLIS

**TREE TYPES**

AA	ACACIA	ED	ELDER	OR	ORNAMENTAL
AH	ASH	EM	ELM	PE	PINE
AL	ALDER	FR	FIR	PD	POLLARDED
AN	ASPEN	HB	HORNBEAM	PR	POPLAR
AP	APPLE	HC	HORSE CHESTNUT	SB	SILVER BIRCH
BH	BEECH	HN	HAWTHORN	SC	SWEET CHESTNUT
BL	BLACKTHORN	HY	HOLLY	SU	SPRUCE
BR	BIRCH	LA	LARCH	SY	SYCAMORE
CE	CHERRY	LE	LIME	WB	WHITEBEECH
CO	CONIFER	LN	LONDON PLANE	WT	WALNUT
CR	CEDAR	ME	MAPLE	WW	WILLOW
CY	CYPRESS	OK	OAK	YW	YEW
DD	DEAD			XX	UNKNOWN

**SERVICE ABBREVIATIONS**

AC	ASSUMED CONNECTION	IL	INVERT LEVEL
AR	ASSUMED ROUTE	KIG	KERB INLET GULLY
BO	BACK DROP	MH	MANHOLE
CC	CONFIRMED CONNECTION	OHL	OVER HEAD LINE
CD	CHAMBER DEPTH	PI	PETROL INTERCEPTOR
COW	CABLE ON WALL	RD	FROM RECORD DRAWINGS
C	COVER LEVEL	RE	RODDING EYE
CP	CATCH PIT	SK	SOAKAWAY
CB	CABLE RISER	TP	TRACED POINT
DTB	DEPTH TO BASE	UNK	UNKNOWN SERVICE
D	DEPTH	UTL	UNABLE TO LOCATE
(GB)	DISUSED	UTR	UNABLE TO RAISE
EOT	END OF TRACE	UTT	UNABLE TO TRACE
GU	GULLY	UTS	UNABLE TO SURVEY

**UTILITY LEGEND AND NOTES**

UTILITIES ARE DRAWN IN 3D WITH THE LEVEL CORRESPONDING TO THE CENTRE OF THE UTILITY. EXCEPTIONS TO THIS ARE DETECTED BY GPR WHERE THE LEVEL IS THAT OF THE TOP OF THE UTILITY. THESE ARE DENOTED BY GPR LAYERS OR LINETYPES SHOWN ABOVE OR BY SPECIFIC LABELLING OF THE DRAWINGS.

**CAUTIONARY NOTES**

ELECTRO-DETECTION TECHNIQUES HAVE BEEN USED IN THE LOCATION OF UNDERGROUND SERVICES. THE RESULTS ARE NOT INFALLIBLE AND TRIAL EXCAVATIONS MUST BE CARRIED OUT TO CONFIRM SERVICE IDENTIFICATION. POSITIONS AND PARTICULARLY DEPTHS. ALTHOUGH ALL REASONABLE EFFORT HAS BEEN MADE IN SEARCHING AVAILABLE RECORD DRAWINGS, THE COMPLETENESS OF THE UNDERGROUND SERVICE INFORMATION CANNOT BE GUARANTEED. INFORMATION OBTAINED BY GPR IS INDICATIVE OF BURIED INFRASTRUCTURE THAT MAY NOT BE DETECTABLE BY OTHER MEANS.

**DRAINAGE NOTES**

PIPES ON THE REPORT ARE REFERENCED CLOCKWISE FROM THE OUTGOING PIPE WITH THE MH NUMBER AS THE PREFIX I.E. MH01A. END POINT LOCATIONS WITHIN BUILDINGS ARE INDICATIVE UNLESS STATED.

**TECHNICAL NOTES**

ALL LEVELS ARE BASED ON ORDNANCE SURVEY DATUM OBTAINED FROM ACTIVE GPS NETWORK. TOGB36157

GRSD IS BASED ON OS DATUM. OBTAINED FROM ACTIVE GPS NETWORK TOGB36157

ALL KERB LEVELS ARE TAKEN IN CHANNEL.

A SCALE FACTOR OF 1.000000 HAS BEEN APPLIED TO THIS DRAWING

**Rev.**

Rev.	Date	Description	By
A	SEPT 21	ADDITIONAL SECTIONS AND ELEVATIONS ADDED	CH

**Drawn by** X.X.X. **Surveyed by** X.X.X. **Checked by** X.X.X.

**Project title** WHITSTABLE MUSEUM

**Drawing title** SECTIONS AND ELEVATIONS

**Client** AR DESIGN

**Drawing No.** SDS 206247-10 **Revision** A

**Scale** 1:50 **Date** SEPT 2021 **Sheet size** A1