

THIS DRAWING IS TO BE USED FOR ELECTRICAL
INFORMATION ONLY

KEY

 DISTRIBUTION BOARD

 DOUBLE SWITCHED SOCKET

 SINGLE SWITCHED SOCKET

4 DATA CONNECTION POINT

△ TELECOM CONNECTION POINT (MASTER)

▲ TELECOM CONNECTION POINT (SECONDARY)

 ISOLATOR☒ FUSED CONNECTION UNIT (SWITCHED)

 FUSED SPUR POINT WITH CORD OUTLET

☐ CCTV OUTLET

☐ D/T INTEGRATED DATA/TELEPHONE NODE

----- ROUTE OF TELEPHONE CONNECTION

TEMPERATURE SENSOR CONTROLLING
LOCAL FAN AS INDICATED.
(SENSOR FREE ISSUED BY
MECHANICAL SUB-CONTRACTOR)

C BLIND CONTROL

E EXHIBITION AV CONTROL BACKBOX

RIO SECURITY RIO

FAN FAN

BC BATTERY CHARGER

DI ELECTROMAGNETIC DOOR LOCK

EHO ELECTROMAGNETIC HOLD OPEN


LED DOOR LOCK STATUS LED

HA HAND DRIVER

CAM CCTV CAMERA (FUSE CONNECTION UNIT AT H/L)

DA DISABLED ALARM

DTU DAMPER TEST UNIT

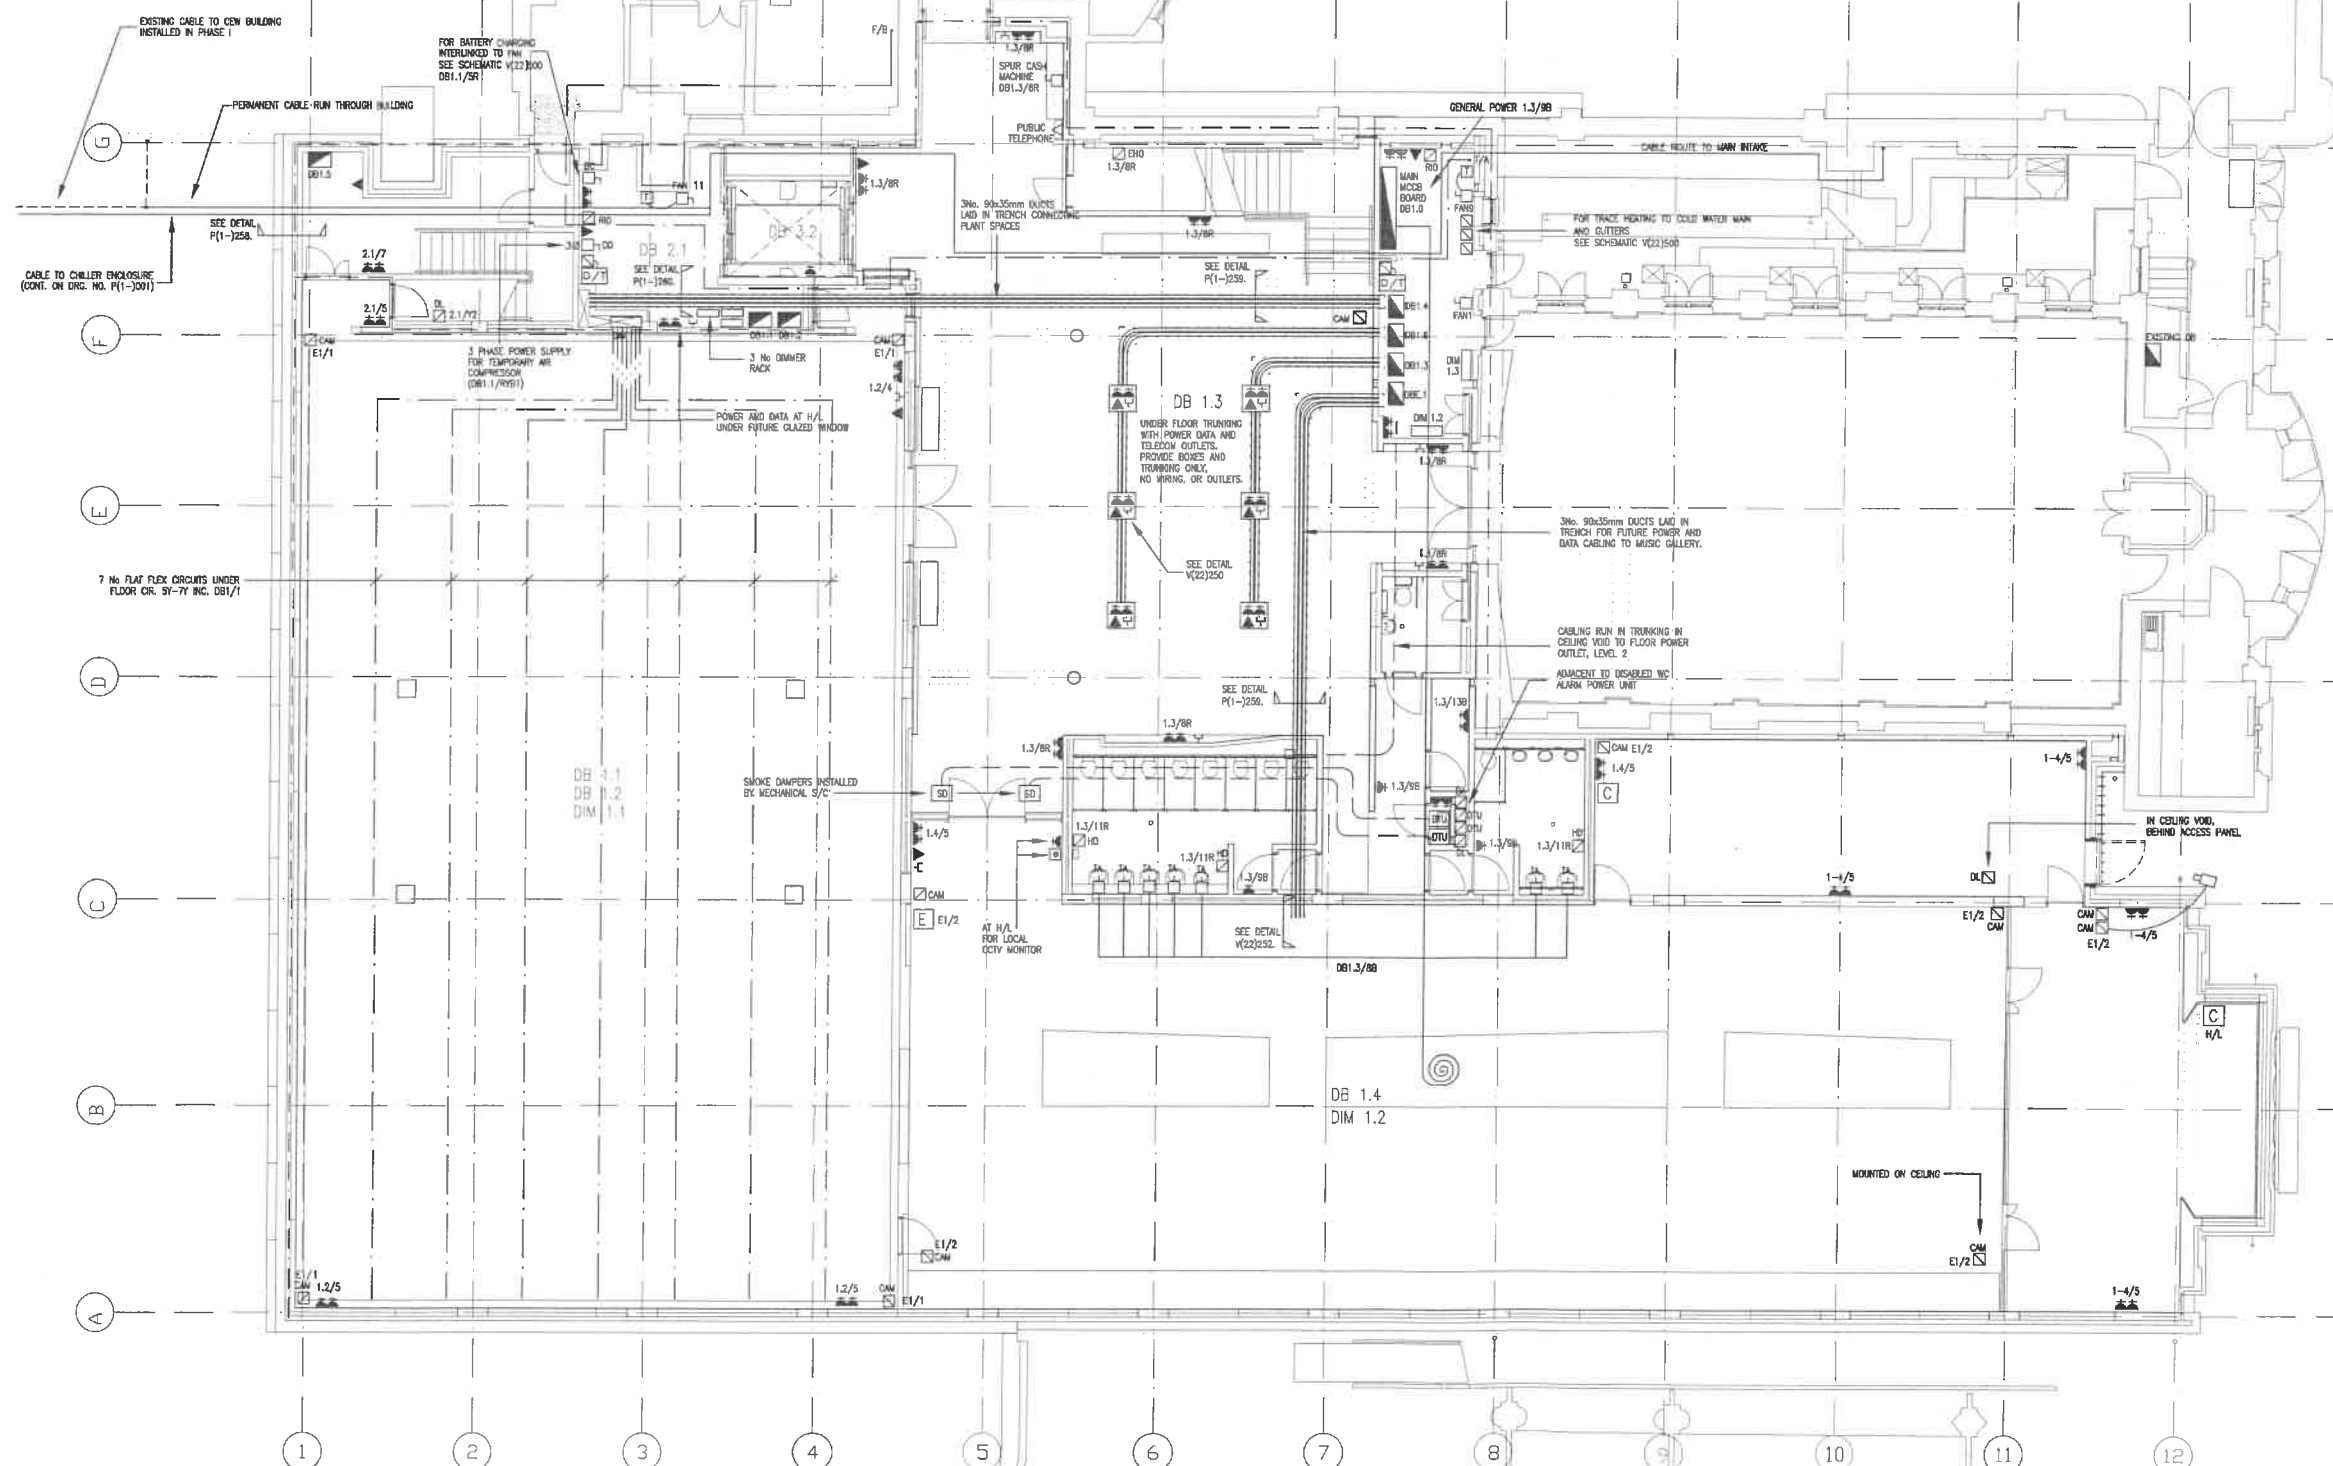

'AS INSTALLED'



CUMNOR ROAD, WOOTTON, BOARS HILL, OXFORD OX1 5JW
TEL. No. OXFORD 730881
FACSIMILE No. 01885 326750

JOB HORNIMAN 2001
MAIN BUILDING (PHASE II)

TITLE POWER, DATA & TELECOM
LEVEL 1

DATE DEC. 01	SCALE 1:1000
--------------	--------------

DRAWN LO	CHECKED VS
-------------	---------------

DRAWING No. 1711-1688000

REVISION	
----------	--