



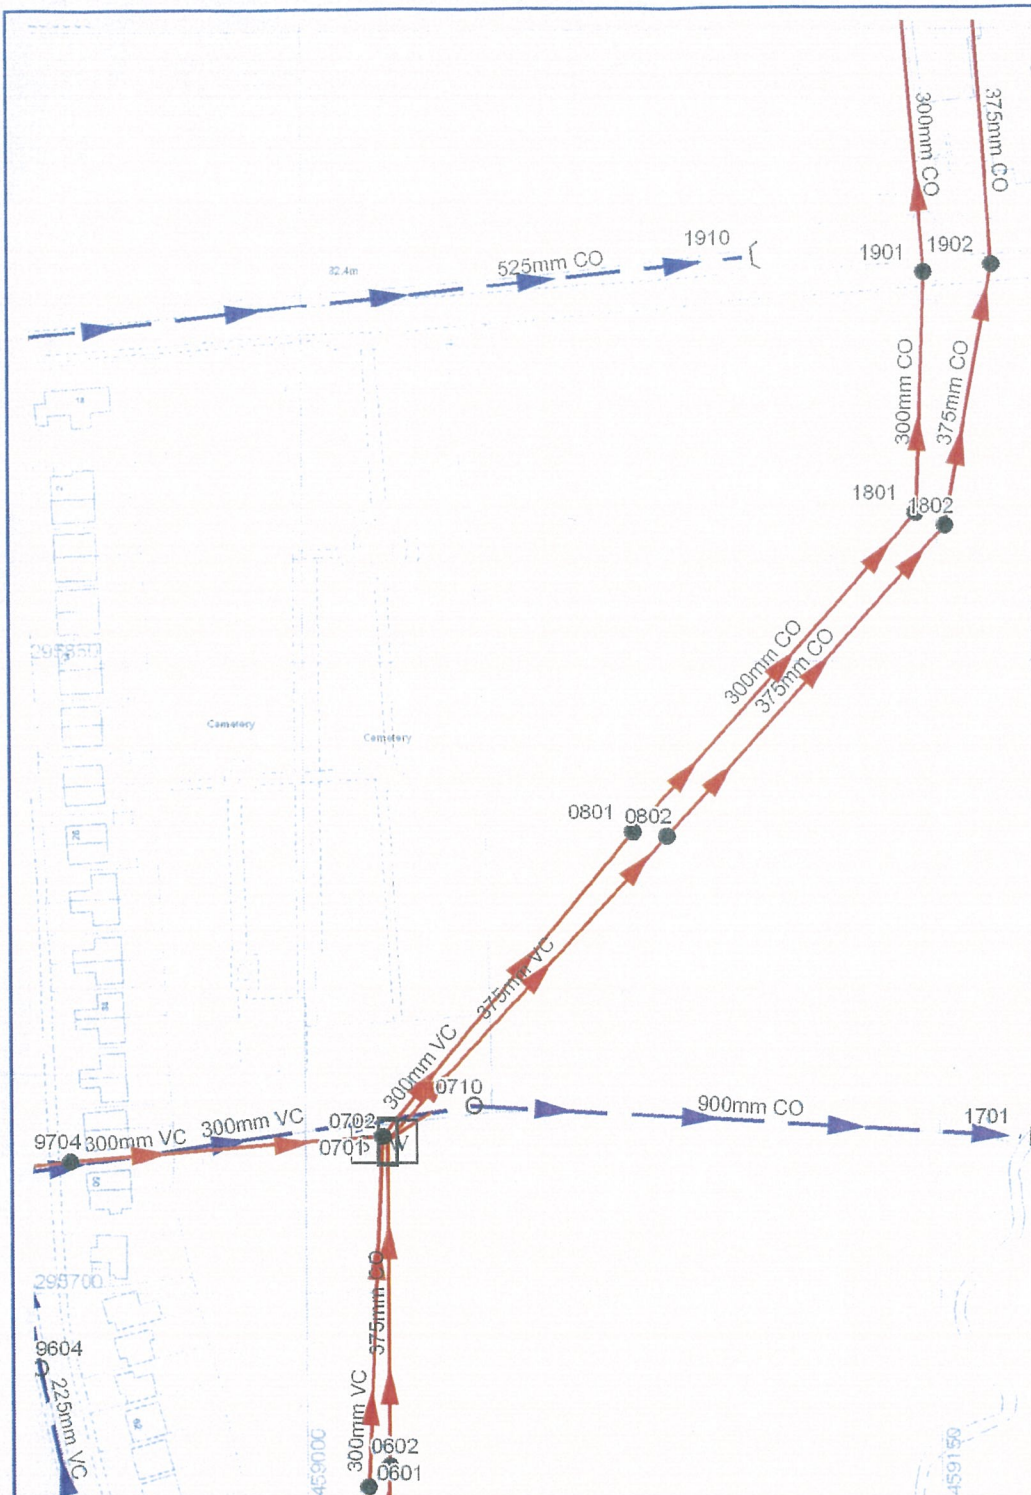

Sewer Node

Sewer Pipe Data

REFERENCE	COVER LEVEL	INV LEVEL UPSTR	INV LEVEL DOWNSTR	PURP	MATL	SHAPE	MAX SIZE	MIN SIZE	GRADIENT	YEAR LAID
SP58959604	81.49	79.86	79.48	S	VC	C	225	nil	120.74	nil
SP58959704	80.61	78.72	77.32	C	VC	C	300	nil	54.93	nil
SP59950601	79.75	77.52	77.30	C	VC	C	300	nil	377.73	nil
SP59950602	79.73	77.50	77.34	C	CO	C	375	nil	481.25	nil
SP59950701	78.72	77.67	77.67	C	BR	R	750	1400	0.00	nil
SP59950701	78.72	77.29	77.10	C	VC	C	300	nil	489.95	nil
SP59950710	nil	nil	78.12	S	CO	C	900	nil	0.00	nil
SP59950801	78.50	77.09	76.86	C	CO	C	300	nil	437.26	nil
SP59950802	78.50	77.11	76.93	C	CO	C	375	nil	546.72	nil
SP59951801	78.45	76.85	76.74	C	CO	C	300	nil	509.45	nil
SP59951802	78.48	76.93	76.77	C	CO	C	375	nil	381.25	nil
SP59951901	78.94	76.70	nil	C	CO	C	300	nil	0.00	nil
SP59951902	78.88	76.77	nil	C	CO	C	375	nil	0.00	nil

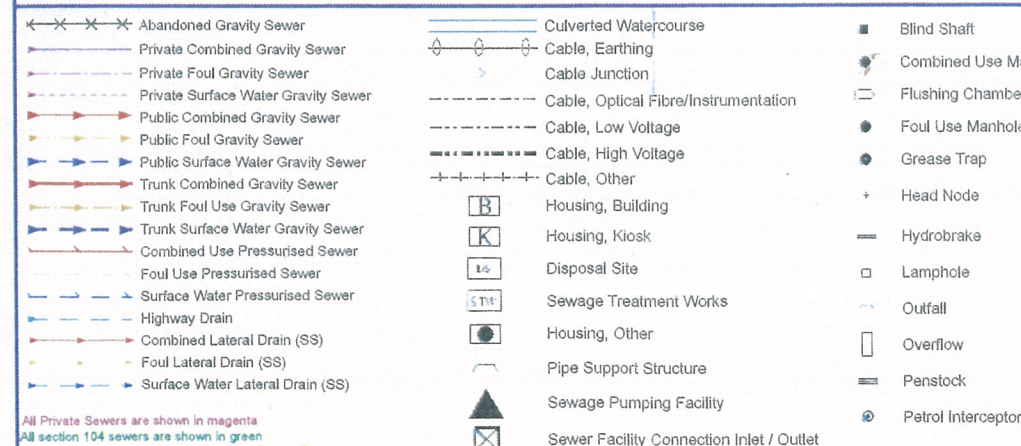

All Private Sewers are shown in magenta
All section 104 sewers are shown in green
All Sewers that have been transferred to Severn Trent
Water after the 1st October 2011, but have not been surveyed and
confirmed by Severn Trent Water, are shown in orange

- Sewer Chemical Injection Point
- Sewer Junction
- Sewerage Air Valve
- Sewerage Hatch Box Point
- Sewerage Isolation Valve
- Soakaway
- Surface Water Manhole
- Vent Column
- Waste Water Storage
- Pre-1937 Properties

TABULAR KEY
Sewer pipe data refers to downstream sewer pipe.
Where the node bifurcates (splits) X and Y indicates downstream sewer pipe.
Gradient is stated a 1 in...

MATERIALS

- NONE
- AC - ASBESTOS CEMENT
- BR - BRICK
- CC - CONCRETE BOX CULVERT
- CI - CAST IRON
- CO - CONCRETE
- CSB - CONCRETE SEGMENTS (BOLTED)
- CSU - CONCRETE SEGMENTS (UNBOLTED)
- DI - DUCTILE IRON
- GRC - GLASS REINFORCED CONCRETE
- GRP - GLASS REINFORCED PLASTIC
- MAC - MASONRY IN REGULAR COURSES
- MAR - MASONRY RANDOMLY COURSED
- PE - POLYETHYLENE
- PF - PITCH
- PP - POLYPROPYLENE
- PSC - PLASTIC STEEL COMPOSITE
- PVC - POLYVINYL CHLORIDE
- RPM - REINFORCED PLASTIC MATRIX
- SI - SPUN (GREY) IRON
- ST - STEEL
- U - UNKNOWN
- VC - VITRIFIED CLAY
- XXX - OTHER

- C - CIRCULAR
- E - EGG SHAPED
- O - OTHER
- R - RECTANGLE
- S - SQUARE
- T - TRAPEZOIDAL
- U - UNKNOWN

- C - COMBINED
- E - FINAL EFFLUENT
- F - FOUL
- L - SLUDGE
- S - SURFACE WATER

CATEGORIES

- W - WEIR
- C - CASCADE
- DB - DAMBOARD
- SE - SIDE ENTRY
- FV - FLAP VALVE
- BD - BACK DROP
- S - SIPHON
- HD - HIGHWAY DRAIN
- S104 - SECTION 104



Severn Trent Water Limited
Asset Data Management
PO Box 5344
Coventry
CV3 9PT
Telephone: 0845 601 6616

SEWER RECORD (Tabular)

O/S Map scale:	1:1750	This map is centred upon:	
Date of issue:	11.12.12	O / S Grid reference:	
Sheet No.	1 of 1	x :	459104
		y :	295826

Disclaimer Statement:
1. Do not scale off this Map.
2. This map and any information supplied with it is furnished as a general guide, is only valid at the date of issue and no warranty as to its correctness is given or implied. In particular this Map and any information shown on it must not be relied upon in the event of any development or works (including but not limited to excavations) in the vicinity of Severn Trent Water's assets or for the purposes of determining the suitability, of a point of connection to the sewerage or distribution systems.
3. On 1 October 2011 most private sewers and private lateral drains in Severn Trent Water's sewerage area, which were connected to a public sewer as at 1 July 2011, transferred to the ownership of Severn Trent Water and became public sewers and public lateral drains. A further transfer takes place on 1 October 2012 (date to be confirmed). Private pumping stations, which form part of these sewers or lateral drains, will transfer to the ownership of Severn Trent Water on or before 1 October 2016. Severn Trent Water does not possess complete records of these assets. These assets may not be displayed on this Map.
4. Reproduction by permission of Ordnance Survey on behalf of HMSO. © Crown Copyright and database right 2004. All rights reserved. Ordnance Survey licence number 100019202. Document users other than Severn Trent Water business users are advised that this document is provided for reference purpose only and is subject to copyright, therefore, no further copies should be made from it.