


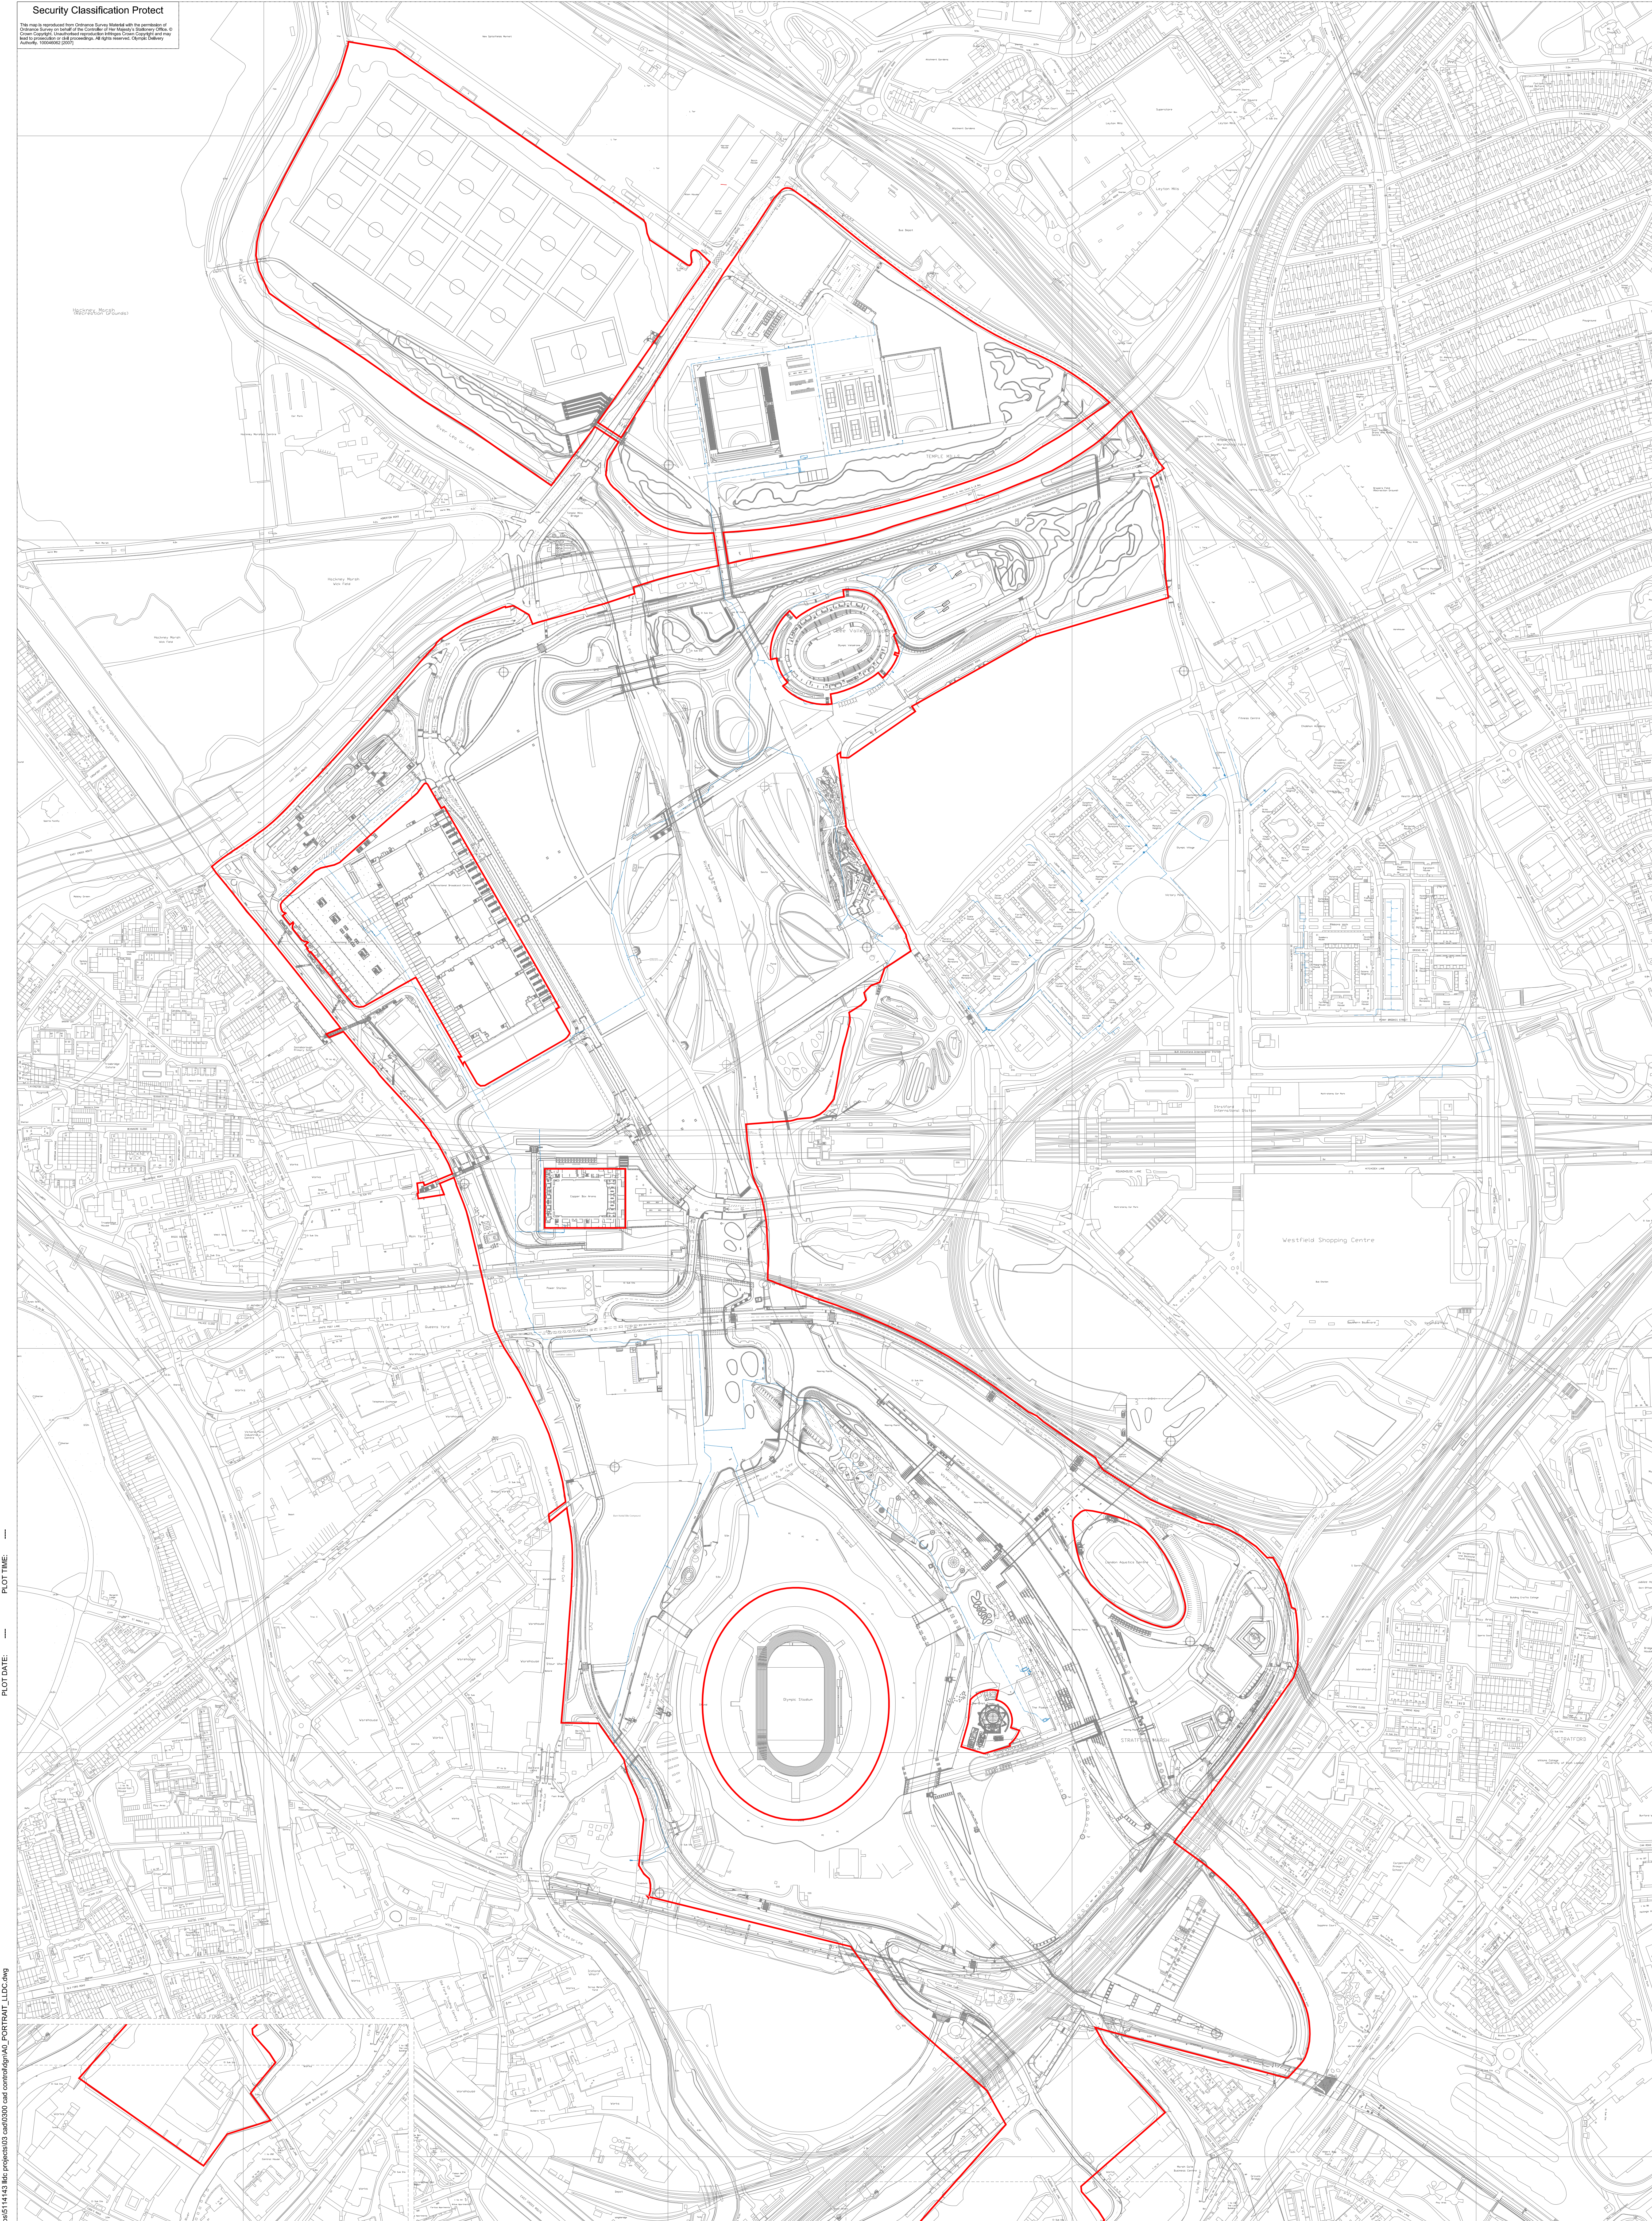

FILENAME: P:\ghemf\infrastructure\projects\14143\Bsc\project\02\cam\0300 and cam\del\AVU_FORT64T_LLDC.dwg

P01	FOR INFORMATION	ARA	JAR	27/03/2015
Rev	Description	Drawn	Checked	Date

Do not scale this drawing.

Notes:

1. The information contained within the Transformation As-built Model (TAM) files were provided by the London Legacy Development Corporation (LLDC) and collated by Atkins. All As-built records provided by LLDC and used within the TAM are shown in LC810-TAM-APK-Z-REG-0001. Atkins do not take any responsibility for the accuracy of the information provided within this model.
2. The information contained within this model has been collated based on transformation as-built model files only. No as-built information from pre-transformation works has been included as part of this model but should be reviewed prior to undertaking any design work.
3. Information provided within this model is indicative (for information only) and users should refer to the relevant as-built information (including Olympic Games model) prior to undertaking any design/construction work.
4. The location, depths, sizes, number and lengths of services/utilities should be verified on site by a competent contractor prior to undertaking any design/construction works.
5. All abandoned services have been collated based on information provided by others. Where conflicting or unclear information has been received regarding the abandonment or retention of services, the services have been shown as live. Services should be verified as abandoned by a competent contractor where required before any work is commenced.
6. The red-line boundary shows the extents of the transformation as-built model. It is likely that information shown outside of this boundary may contain anomalies or have missing information.
7. Foul Water Network shown within the Gainsborough Sports Pitch has been assumed abandoned. Services should be verified as abandoned by a competent contractor where required before undertaking any design/construction works.
8. Chobham Manor is currently under construction and as such all services shown within this area are subject to change and have therefore been coloured grey. Contractor to update as-built utility information for this area when works have been completed.
9. A combination of Olympic Park As-Built CAD records and Ordnance Survey information has been used to generate background information. Where conflicts have arisen precedence has been given to the as-built records. Atkins takes no responsibility for any inaccuracies that may be present within the background model.
10. All TAM drawings should be read in conjunction with the following Documents: LC810-TAM-APK-Z-REG-0001 Register of Models & LC810-TAM-APK-Z-REG-0002 Register of Issues & LC810-TAM-APK-Z-REG-0003 Register of Drawings & LC810-TAM-APK-Z-PEP-0001 - Confirmation of Scope Report & LC810-TAM-XXX-Z-PRO-0001 - Transformation As-Built Models User Manual

Copyright: Olympic Delivery Authority (ODA) 2007. All rights reserved. Except as permitted by the Copyright, Design and Patents Act 1988, no part of this document may be reproduced, stored, transmitted or distributed in any form or by any means, whether electronic, mechanical, by photocopying, recording or otherwise, without prior permission of a director. Except where otherwise expressly agreed in writing, the ODA shall have no responsibility or liability for any loss (direct, consequential or otherwise) which may arise from the reliance on or use of this document or the information contained in it.

Safety, Health and Environment Information:

In addition to the hazards / risks normally associated with the types of work detailed on this drawing, note the following risks and information:

Construction	CL
Dismantling / Demolition / Future	DL

For information relating to Use, Cleaning and Maintenance see the Health and Safety File. It is assumed that all works will be carried out by a competent contractor working, where appropriate, to an approved method statement.

Creator

Prepared by
ATKINS
On behalf of the LLDC

Drawing Title

**ALL PARK
NON-POTABLE WATER
NETWORK**

Project Title

OLYMPIC PARK

Drawn	Checked	Approved
ARA	ARKP	MEL
Date	Scale	Size
27/03/2015	1:2500	A0
Purpose of Drawing	Subsidiarity	
FOR INFORMATION	S2	
Drawing No.	Sheet	Rev.
LC810-TAM-WNN-CD-DGA-0001		P01