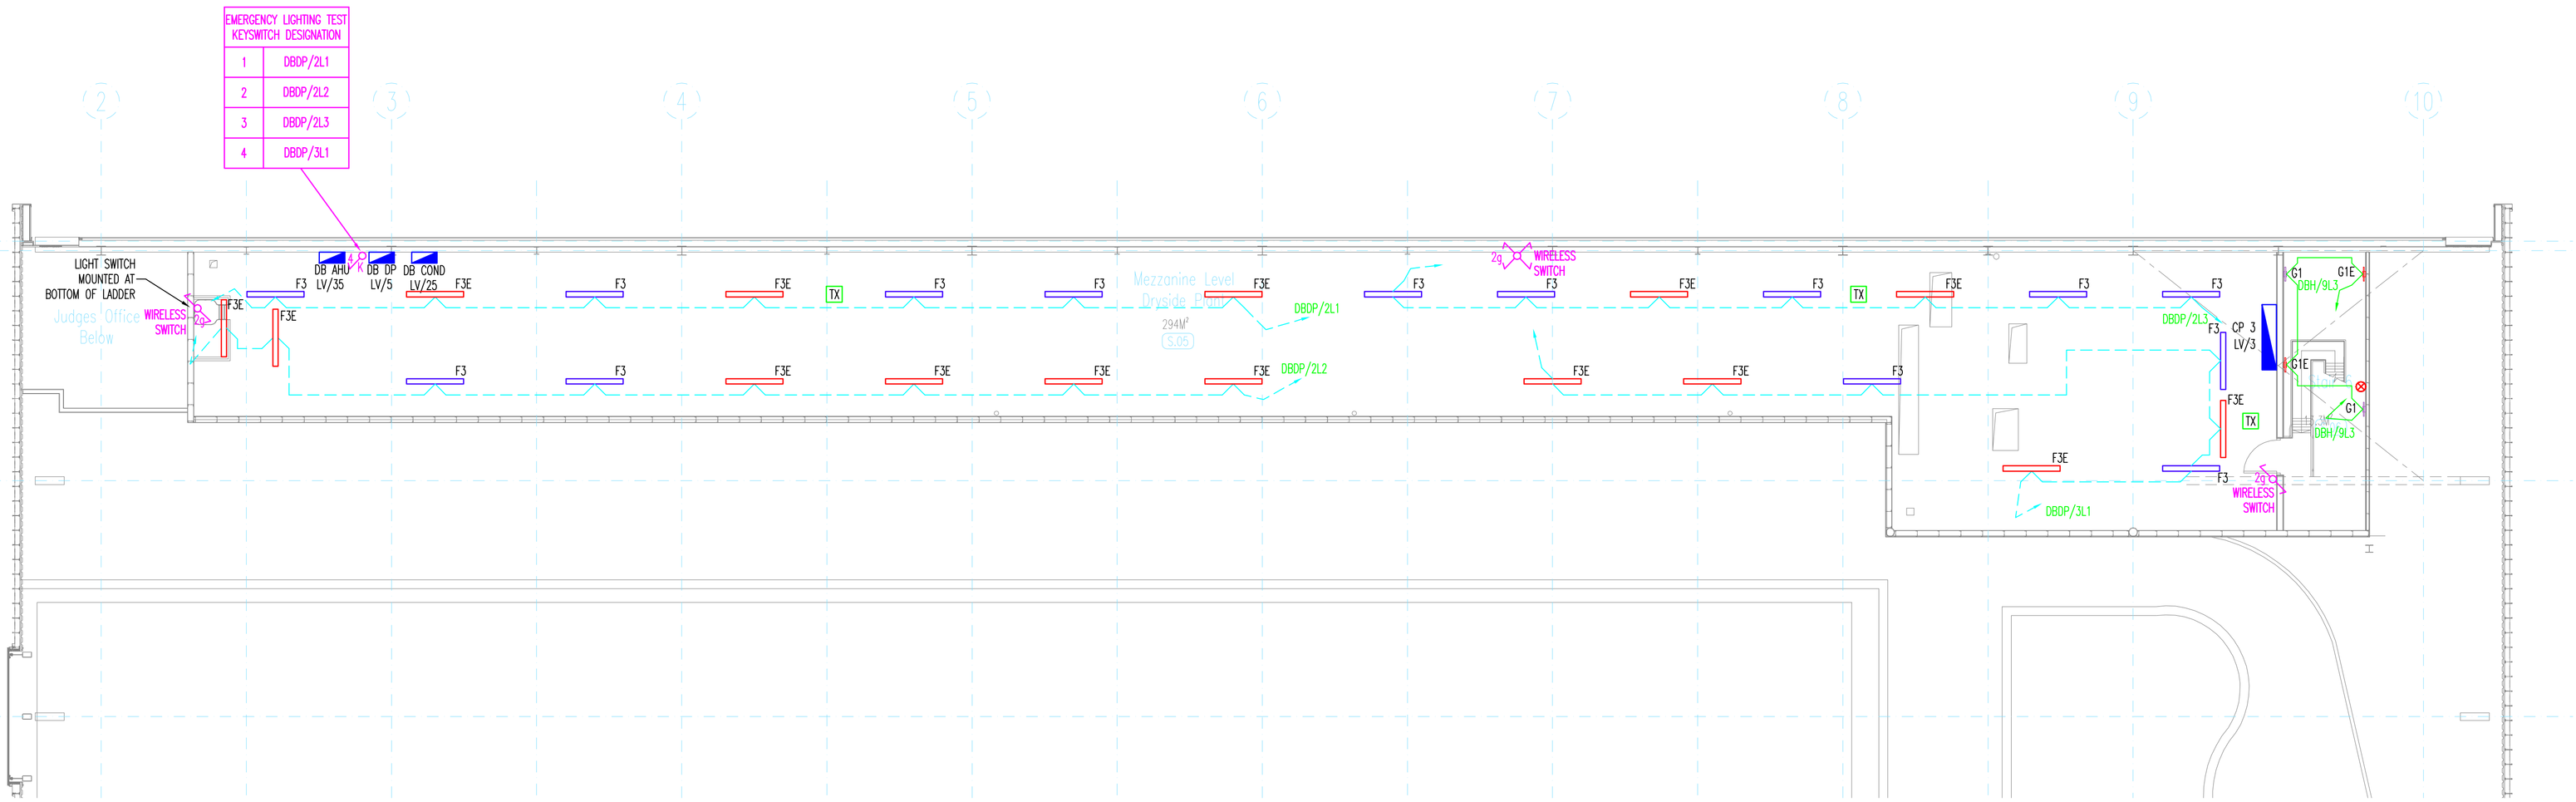

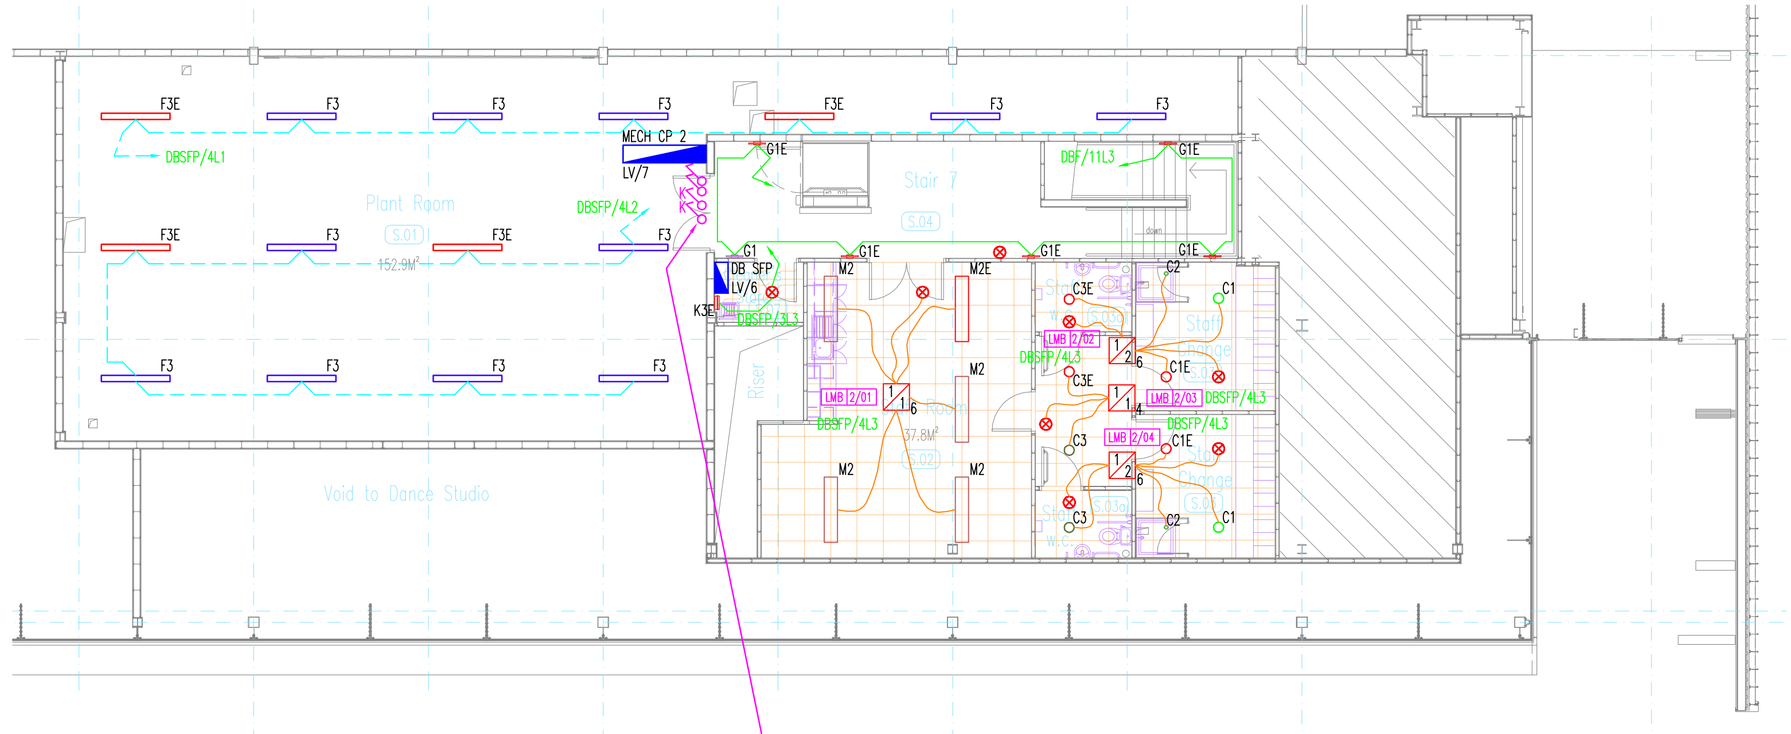

LEGEND

⊗	KLIX PRESENCE DETECTOR C/W PHOTOCELL OS2/AP	•	DENOTES EMERGENCY LUMINAIRES FED FROM CENTRAL BATTERY INVERTER UNIT
PC	PHOTOCELL FOR DIGITAL DIMMING EX-OR MP2000UF	1/1 No.	KLIX LUMINAIRE MARSHALLING BOX (LMB) No. DENOTES NUMBER OF WAYS
n	MANUAL LIGHT SWITCH MK (n DENOTES NUMBER OF GANGS)	1/1 No.	KLIX LUMINAIRE MARSHALLING BOX (LMB) WITH DIGITAL DIMMING No. DENOTES NUMBER OF WAYS
	2 WAY MANUAL LIGHT SWITCH MK	LMB 1/01	LUMINAIRE MARSHALLING BOX IDENTIFICATION NUMBER
	INTERMEDIATE LIGHT SWITCH MK	EL 1U/01	EMERGENCY LIGHTING IDENTIFICATION NUMBER
K	EMERGENCY TEST KEY SWITCH	H	EMERGENCY LUMINAIRE HOLD OFF RELAY EMERGILITE S1230 DIMS
	DIMMER SWITCH MK		KLIX LUMINAIRE SUPPORT COUPLER (LSC)
HR	HAND HELD REMOTE CONTROL DIMMER SWITCH KLIX OSDCS	A1	SWITCH REFERENCE CONTROLLING CCT
	GROUPED CIRCUITS FED VIA CONTACTORS SWITCHED AS INDICATED ON LIGHTING CONTROL SCHEMATIC DRAWINGS	TX	TRANSMITTER LIGHTING
	SWITCH/CONTROL LINES		PLEASE REFER TO DRAWING 106-E-051 FOR DETAILS OF MOUNTING HEIGHTS.
	POOLSIDE EMERGENCY CIRCUIT		

NOTES:-

1. LIGHTING CONTROLLED IN ACCORDANCE WITH LIGHTING CONTROL PHILOSOPHY AND SCHEMATIC DRAWINGS.
2. FOR LUMINAIRE REFERENCES REFER TO THE LUMINAIRE SCHEDULE ON DRAWING No. 106-E-171.
3. PLANT ROOM LUMINAIRE POSITIONS MAY BE ADJUSTED TO SUIT ACTUAL PLANT LAYOUTS.
4. FLEXES FROM MARSHALLING BOXES TO LUMINAIRES CLIPPED DISCREETLY TO BUILDING STRUCTURE.
5. ACCESS HATCHES ARE PROVIDED TO LMB'S AS REQUIRED.
6. ALL EMERGENCY TEST KEY SWITCHES FOR SELF CONTAINED LUMINAIRES ARE LOCATED AT THE DISTRIBUTION BOARD SUPPLYING THE LIGHTING.

EMERGENCY LIGHTING TEST KEYSWITCH DESIGNATION	
1	DBSFP/4L1
2	DBSFP/4L2
1	DBSFP/4L3
2	DBSFP/3L3

© DERRY BUILDING SERVICES LIMITED

This drawing is the property of Derry Building Services Limited. Copyright is reserved by them and the drawing is issued on the condition that it is not copied, reproduced, retained or disclosed to any unauthorised person, either wholly or in part without the consent in writing of Derry Building Services Ltd.

Notes:

1. DO NOT SCALE THIS DRAWING.
2. DO NOT ALTER BY HAND.
3. THIS DRAWING IS TO BE READ IN CONJUNCTION WITH ALL OTHER RELEVANT DRAWINGS AND SPECIFICATIONS.
4. ALL DIMENSIONS ARE IN MILLIMETRES UNLESS STATED OTHERWISE.

Rev.	Amendments	By	Date
As Inst.	As Installed Issue.	CAT	20/07/09

Drawing Status: As Installed

Approval Status: N/A

derry BUILDING SERVICES
Established Since 1734
Sam Derry House,
London Road,
NEWARK, NOTTS, NG24 1JP
Tel: 01636 614300 Fax: 01636 605387
Email: design@derry-bs.co.uk

Project:
Corby East Midlands International Swimming Pool

Title:
Second Floor Lighting Layout

Drawn By:	Engineer:	Rec Copy Chk:
C. Tomlinson	R. Dawson	

Primary Scale:	Size:	Date Created:
1:100	A1	June 2009

Based on White Young Green dg: A028331/E/L/04 Rev E

Drawing Number:	Revision:
106-E-104	AI

Second Floor AI
Base Created By: Catherine Tomlinson
Date Created: 25th June 2009
Created from Architects File:
219412(10)04 – 104.dwg Rev: E04
Notes: