This drawing will be at scale shown below at A1 size

THIS DRAWING IS NOT TO SCALE - NTS

GENERAL NOTES:

1. CONTRACTOR TO CONFIRM ALL DIMENSIONS AND LEVELS ON SITE PRIOR TO COMMENCEMENT OF WORKS.
2. WORKMANSHIP, MATERIALS AND TESTING SHALL COMPLY WITH ALL RELEVANT ISO, EN AND NATIONAL STANDARDS AND LOCAL AUTHORITY REGULATIONS.
3. THIS DRAWING TO BE READ IN CONJUNCTION WITH ALL OTHER DOCUMENTS FOR THE WORKS.
4. USE FIGURED DIMENSIONS ONLY. ALL DIMENSIONS IN MILLIMETRES UNLESS STATED OTHERWISE. ALL LEVELS IN METRES. DO NOT SCALE. CHECK THIS DRAWING HAS NOT BEEN ENLARGED / REDUCED.

PARTICULAR NOTES:

1. THIS DRAWING IS BASED ON RECORD DRAWING No. P4807-05M7799-003 Rev. G AND HAS BEEN REVISED BY SCITECH TO REFLECT THE CURRENT INSTALLATION FOLLOWING A NON INTRUSIVE SURVEY.
2. NORMAL AHU OPERATION AT 50%= 1.690m³/s @ 356Pa (ESP). IN THE EVENT OF THE OTHER AHU FAILING THE AHU SHALL BE CAPABLE OF 100% DUTY = 3.338m³/s @ 356Pa (ESP).
3. RE-BALANCE THE ENTIRE SUPPLY AND EXTRACT VENTILATION SYSTEMS TO THE AIR FLOW RATES INDICATED ON THIS DRAWING.

LEGEND:

EXISTING SERVICES

NEW SERVICES

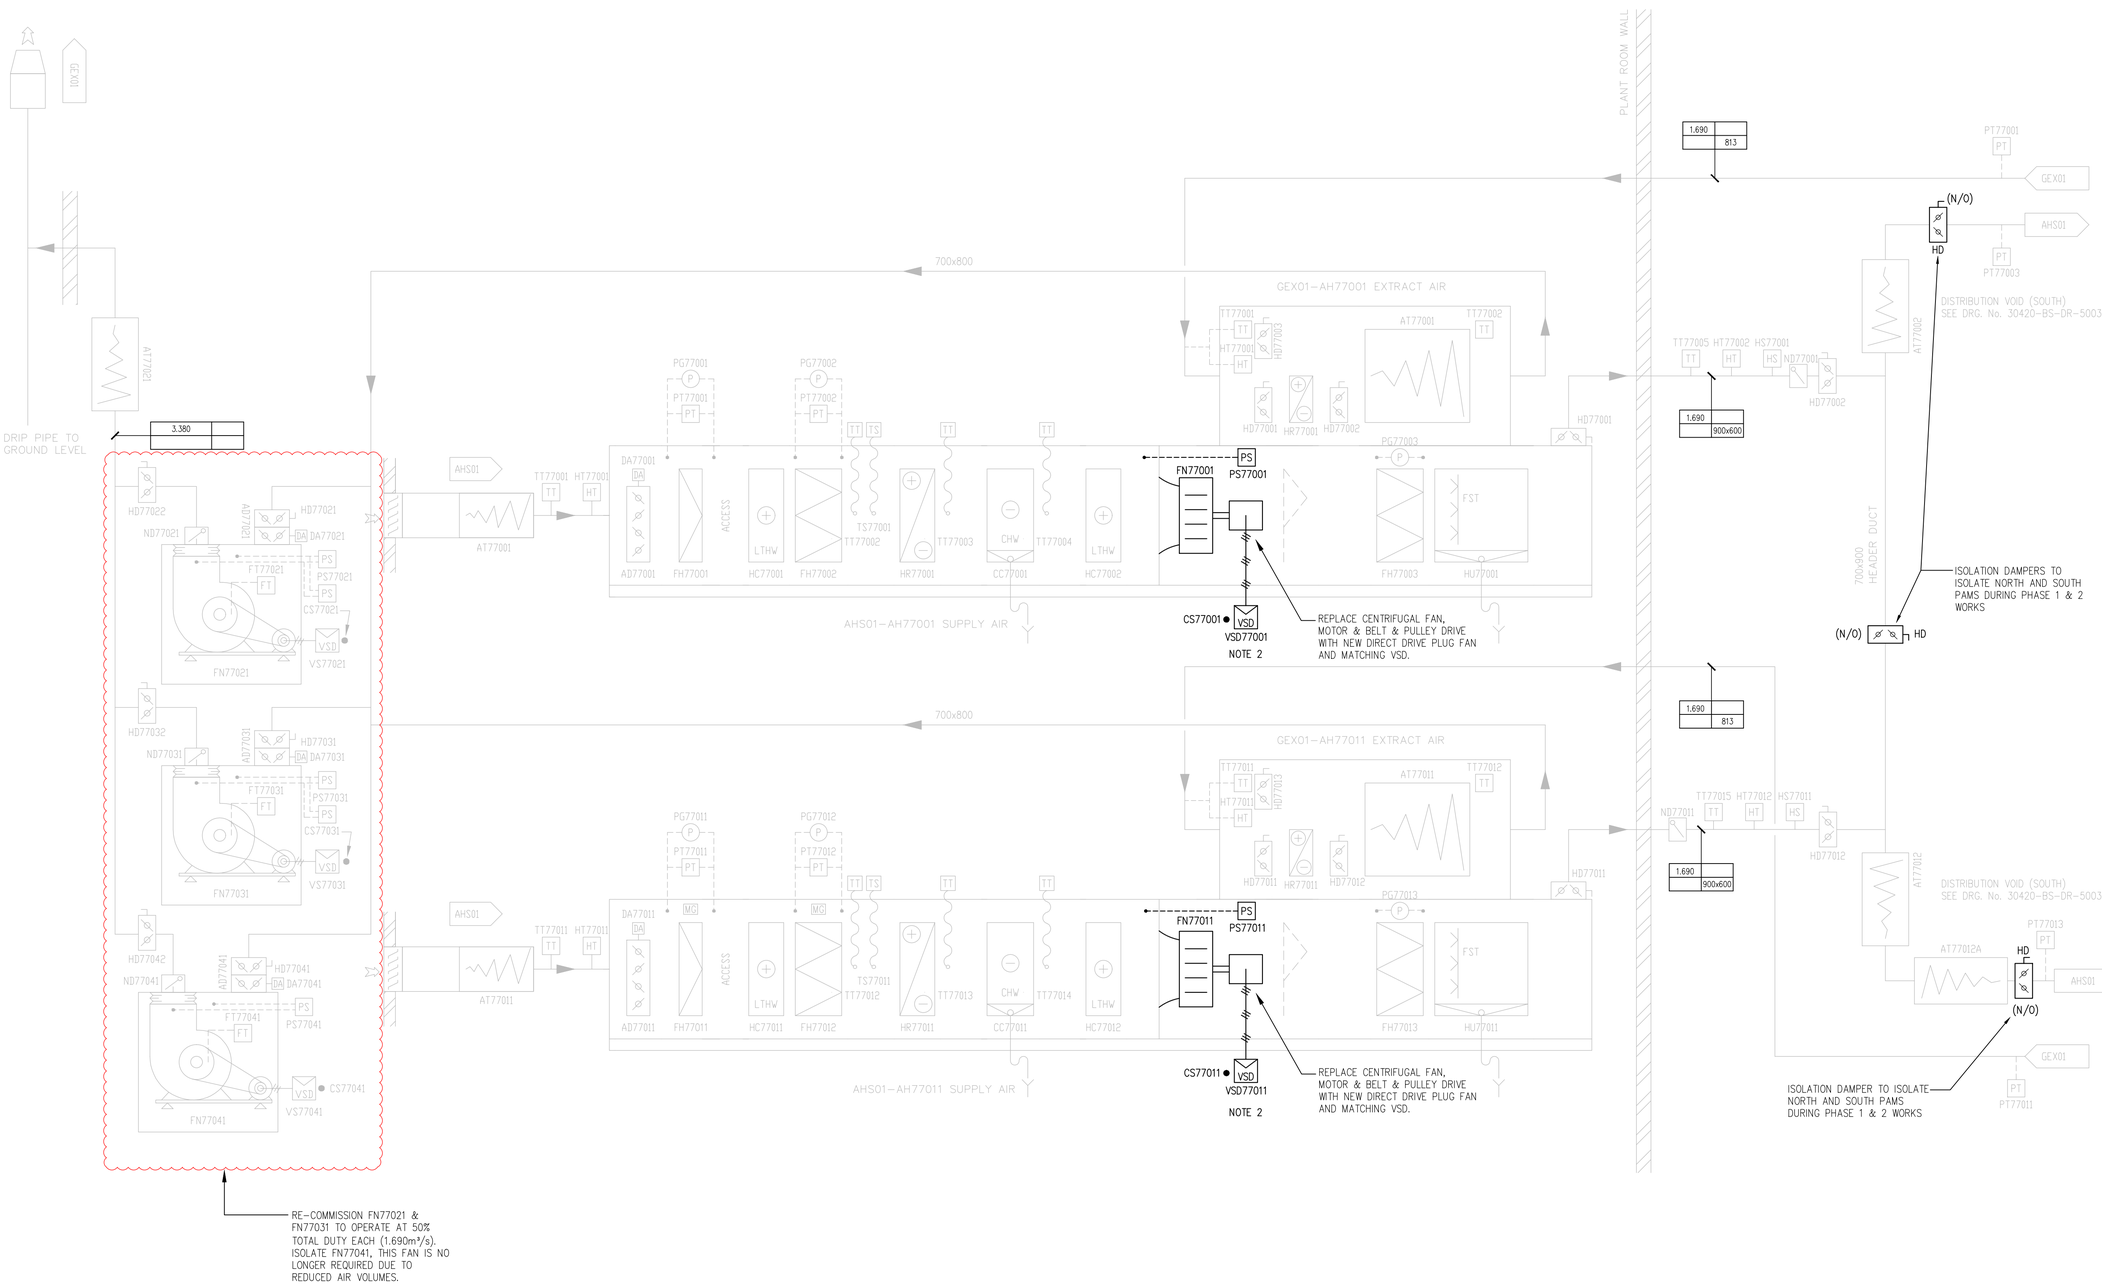

PRELIMINARY - NOT FOR CONSTRUCTION

REV	DESCRIPTION	DRAWN	AUTHOR	CHECKED	APP'D	DATE
B1	ISSUED FOR TENDER	MRF	RAC	LJ	JO	29/1/20

Drawing Status

TENDER

The Pirbright Institute,
Ash Road,
Pirbright,
Surrey.
GU24 0NF

Scitech. Perfect outcomes

Main Office, UK
Scitech House,
Mill Lane,
Godalming, Surrey
GU7 1EY
+44 (0) 1483 270555

Wales Office, UK
Tuscan House, Beck Court
Cardiff Gate Business Park,
Cardiff, Wales
CF23 8RP
+44 (0) 2922 678999

Project Name

TPI IS4L Technical Support

Title

HVAC PLANT
SCHEMATIC
AHS01 / GEX01 (PROPOSED)

Drawn By	MRF	Date Created	AUG 2020

Project No

30420

Drawing No

30420-BS-DR-5007

Revision

B1

A1 SHEET

cad