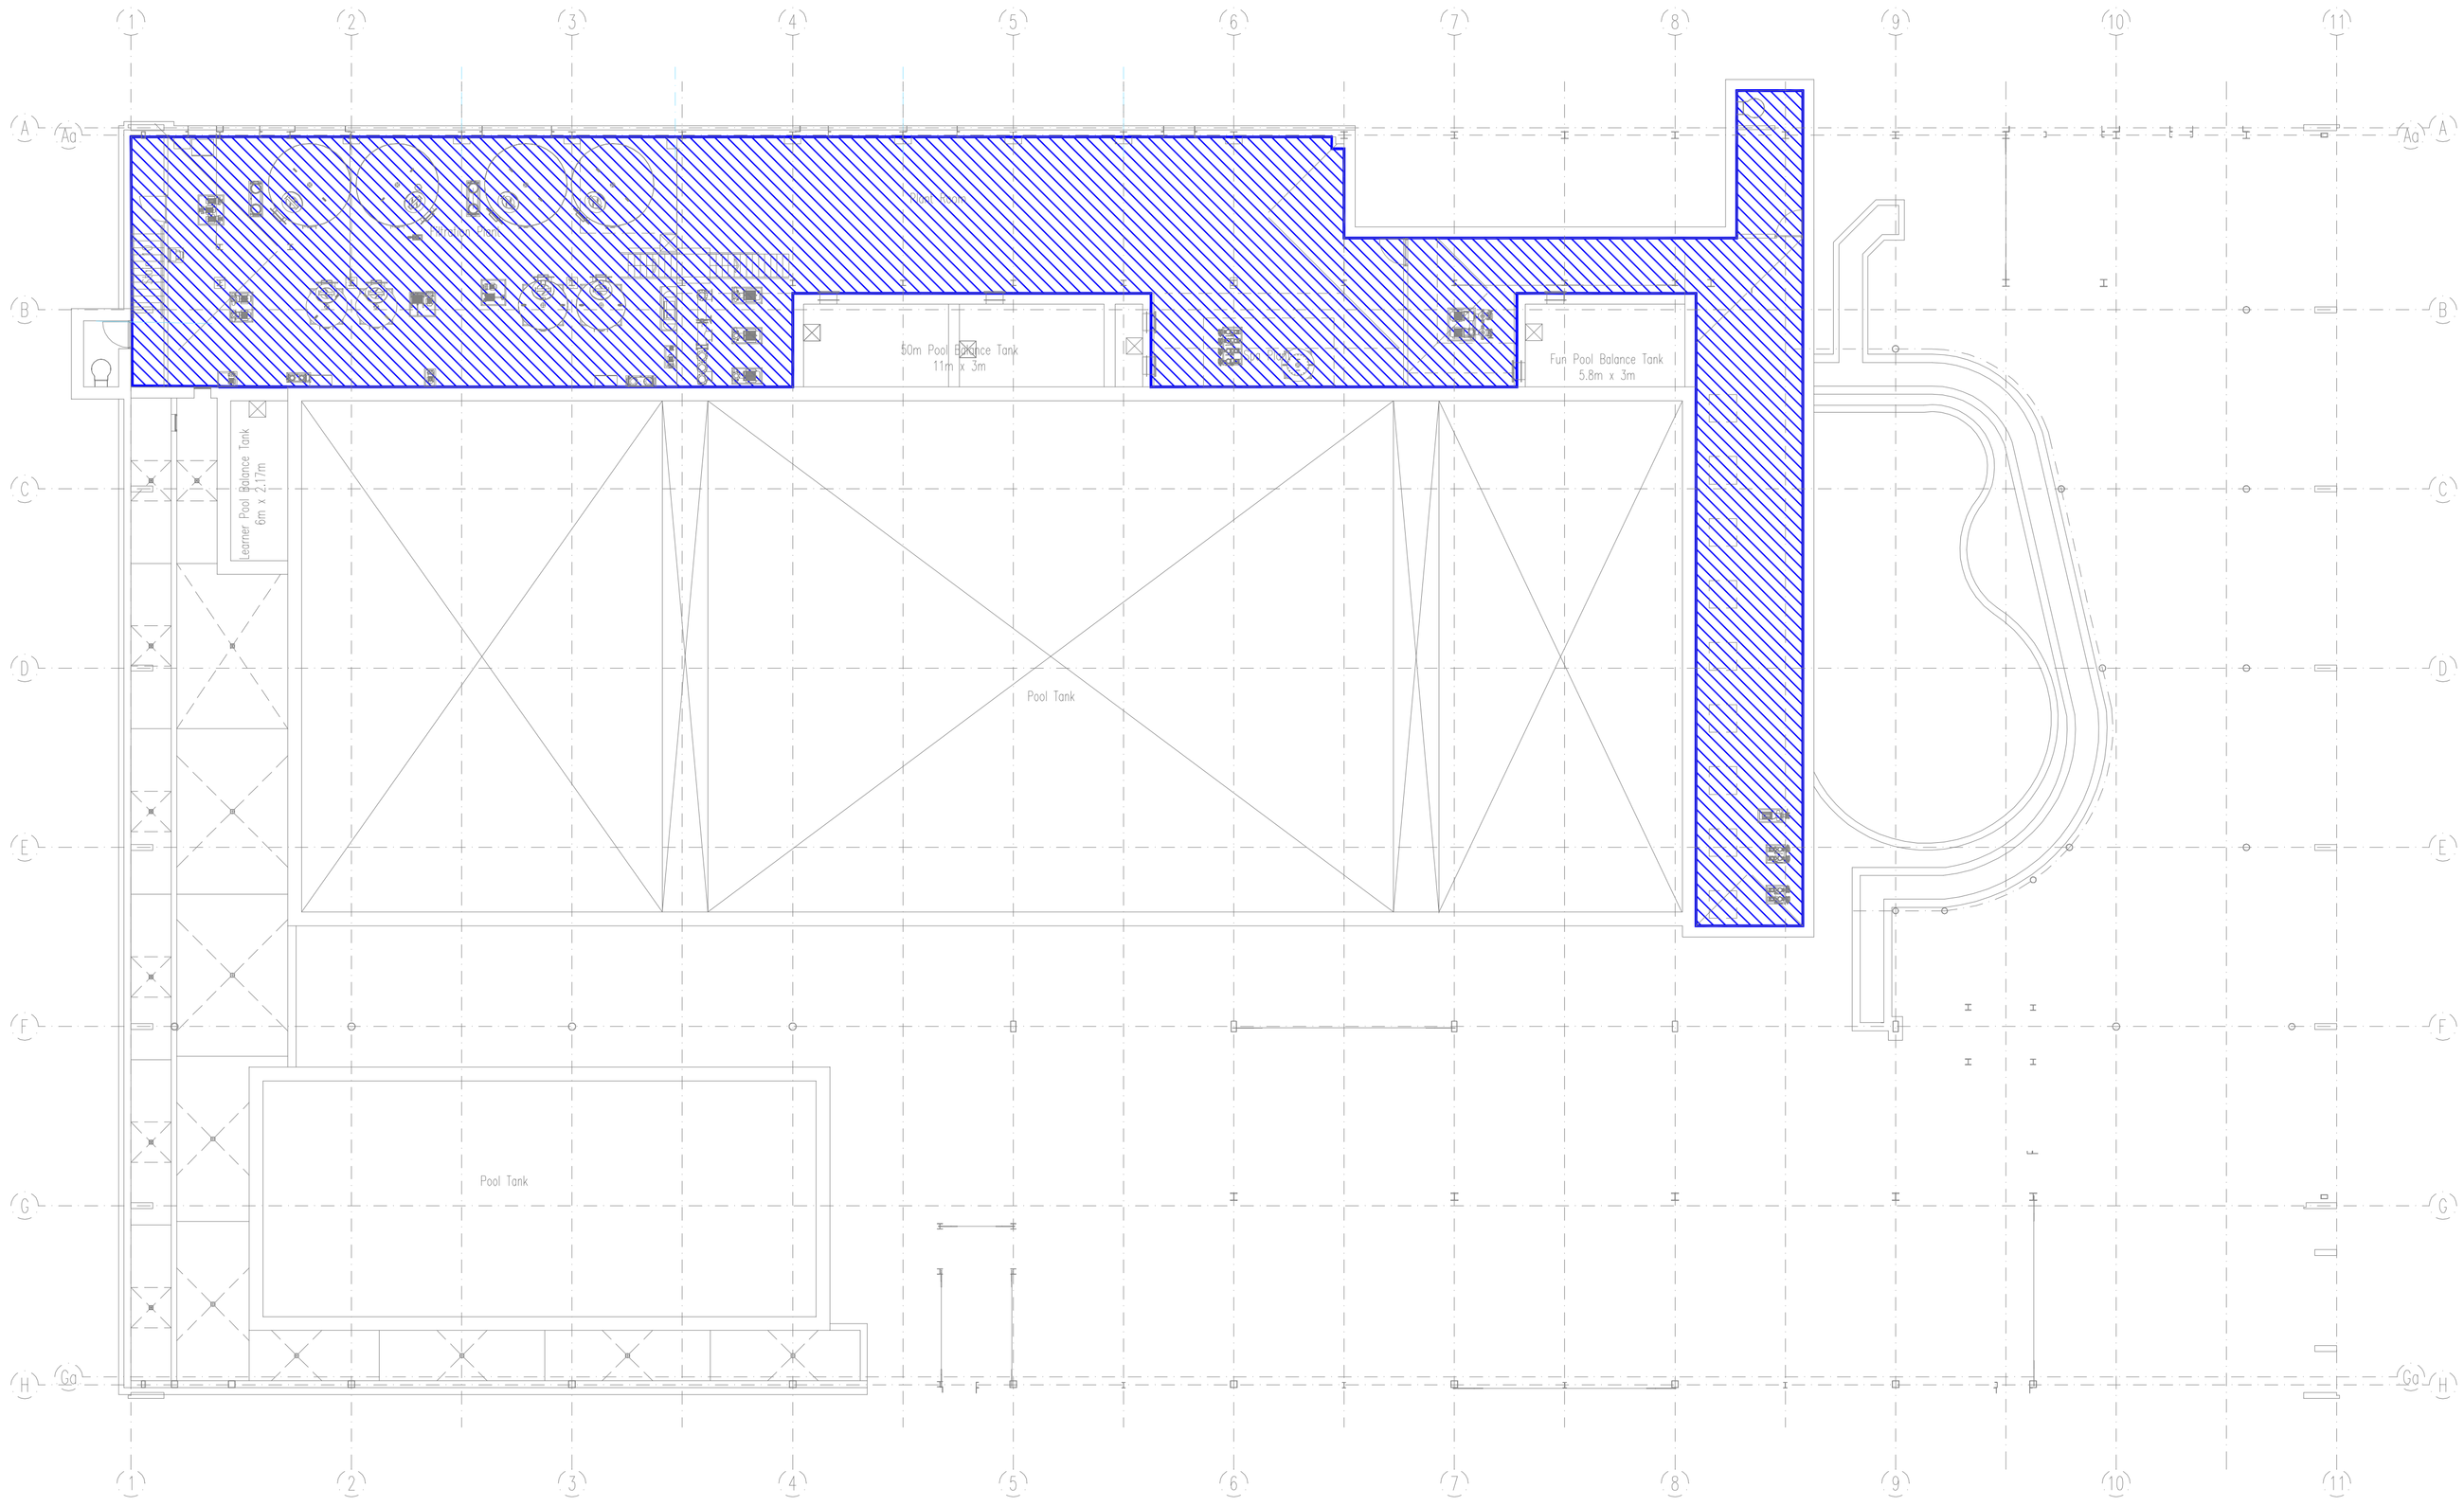

LEGEND

- SWITCHED FROM BEHIND THE RECEPTION DESK. WIRING OF FITTINGS IS SUCH THAT ALTERNATE UPLIGHT FITTINGS CAN BE SWITCHED OFF TO PROVIDE A 50% LIGHTING UPLIGHT LEVEL AND ALTERNATE DOWNLIGHT FITTINGS CAN BE SWITCHED OFF TO PROVIDE A 50% LIGHTING DOWNLIGHT LEVEL
- LOCAL MANUAL SWITCHING
- LOCAL MANUAL SWITCH WITH MASTER SWITCH AT RECEPTION
- PRESENCE DETECTION
- SWITCHED FROM BEHIND THE MAIN RECEPTION DESK.
- LOCAL MANUAL SWITCH WITH DAYLIGHT DIMMING OVERRIDE AND MASTER AT RECEPTION (FIRST ROW OF LIGHTING IS OPERATIONAL BEYOND OPENING TIMES)

© DERRY BUILDING SERVICES LIMITED

This drawing is the property of Derry Building Services Limited. Copyright is reserved by them and the drawing is issued on the condition that it is not copied, reproduced, retained or disclosed to any unauthorised person, either wholly or in part without the consent in writing of Derry Building Services Ltd.

Notes:

1. DO NOT SCALE THIS DRAWING.
2. DO NOT ALTER BY HAND.
3. THIS DRAWING IS TO BE READ IN CONJUNCTION WITH ALL OTHER RELEVANT DRAWINGS AND SPECIFICATIONS.
4. ALL DIMENSIONS ARE IN MILLIMETRES UNLESS STATED OTHERWISE.

Rev:	Amendments	By	Date
As Inst.	As Installed Issue.	CAT	25/06/09

Drawing Status: As Installed

Approval Status: N/A

derry BUILDING SERVICES
Established Since 1734
Sam Derry House,
London Road,
NEWARK, NOTTS, NG24 1JP
Tel: 01636 614300 Fax: 01636 605387
Email: design@derry-bs.co.uk

Project:
Corby East Midlands International Swimming Pool

Title:
Undercroft
Lighting Control Philosophy

Drawn By:	Engineer:	Rec Copy Chk:
C. Tomlinson	L. O'Brien	R.A.D.
Primary Scale:	**Size:**	**Date Created:**
1:150	A1	June 2009

Drawing Number: 106-E-151

Revision: AI

Undercroft AI
Base Created By: Catherine Tomlinson
Date Created: 24th June 2008
Created from Architects File:
21MAY2003 – 02D.dwg Rev: 02D
Notes: